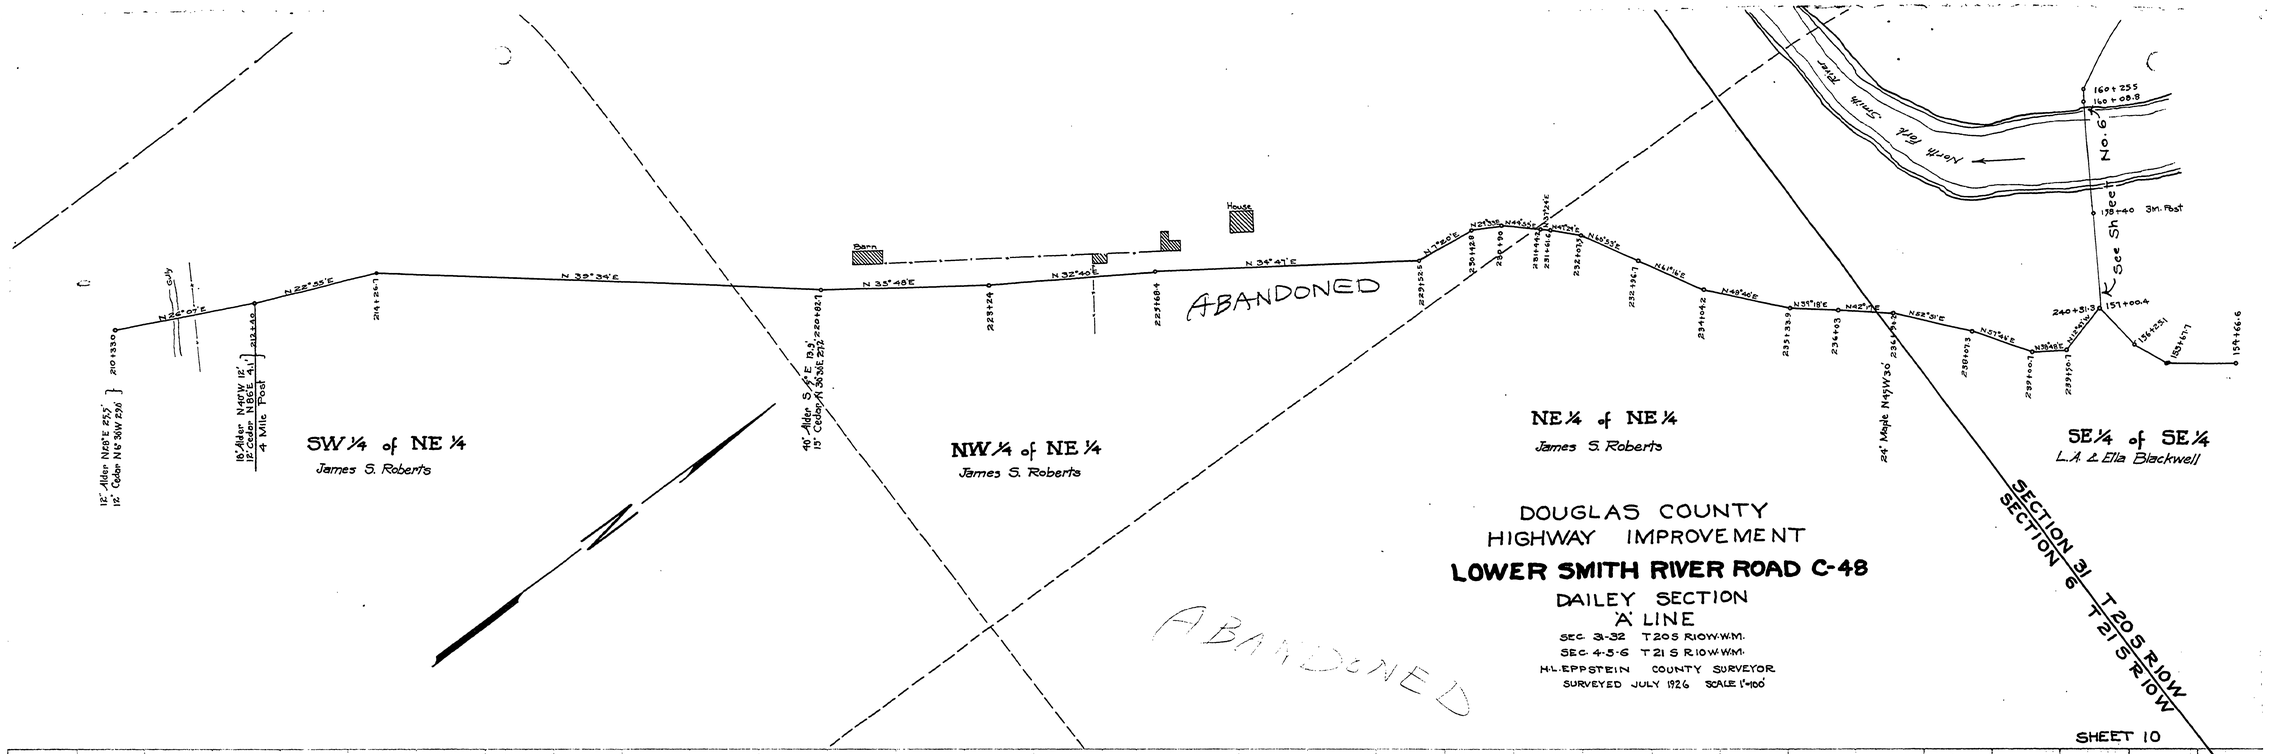

18001803

C-48

~M.P. 18.0

T20-10 S.31 & 32
T21-10 S.4,5 & 6 JULY 1926 SHT 10 OF 10 (62)