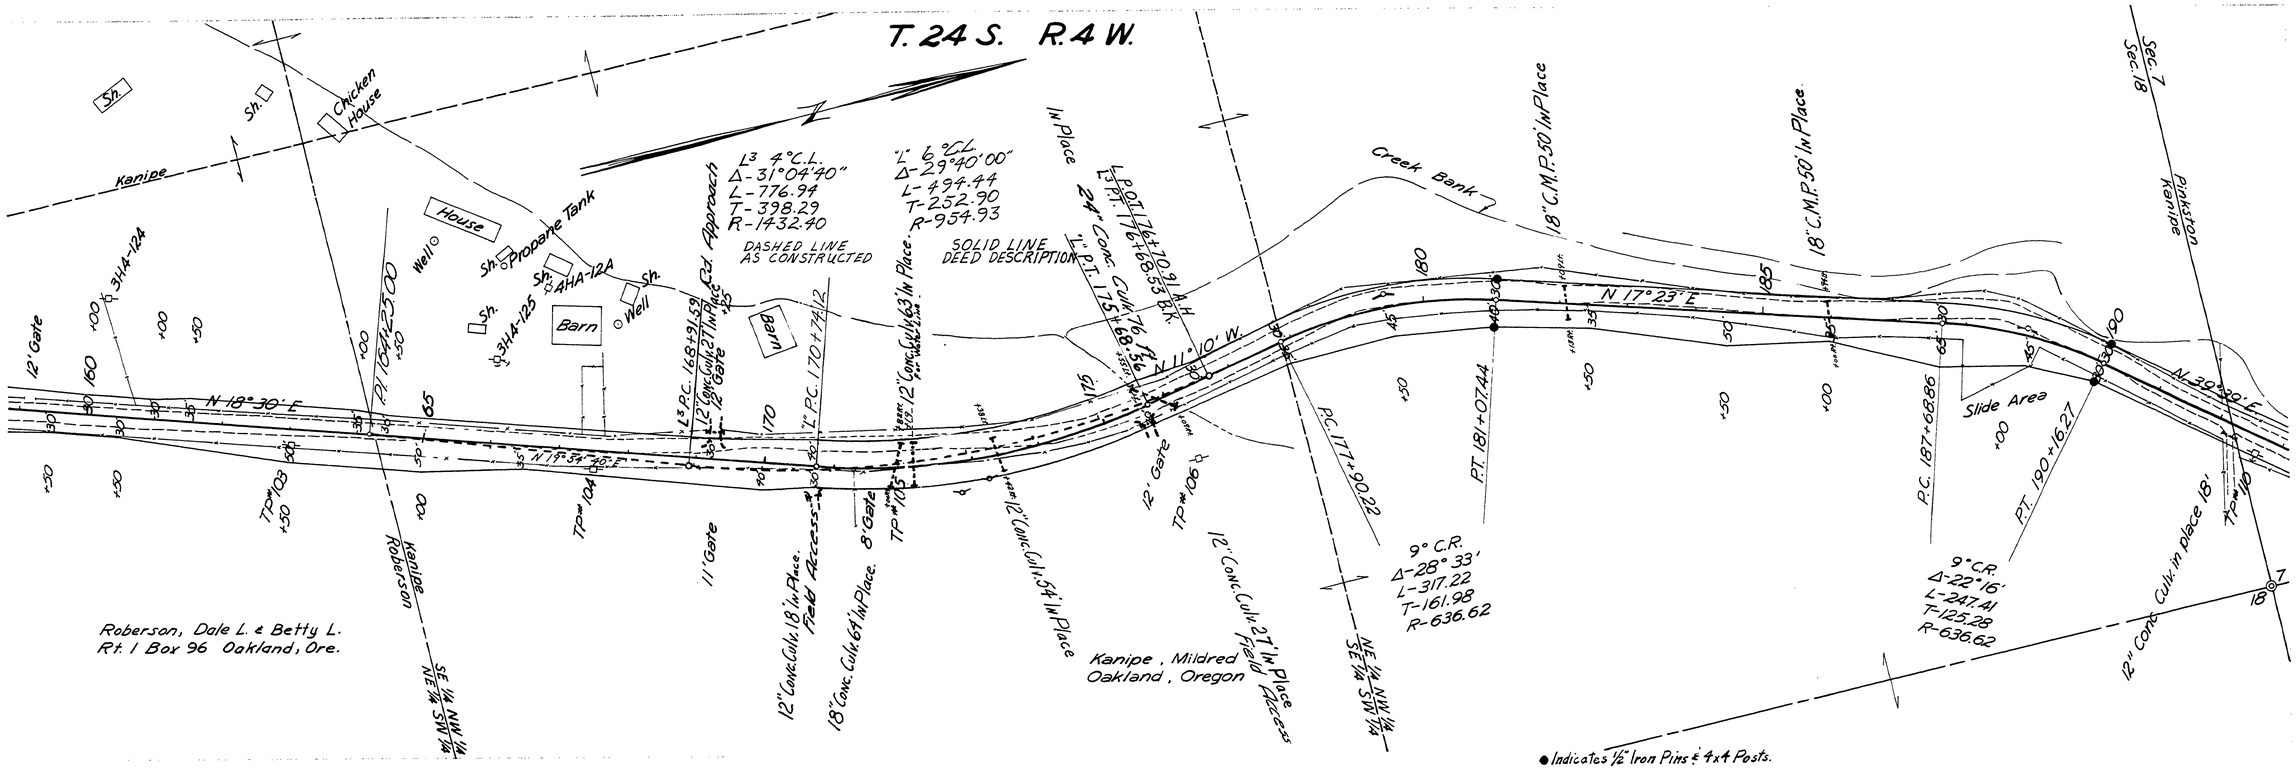

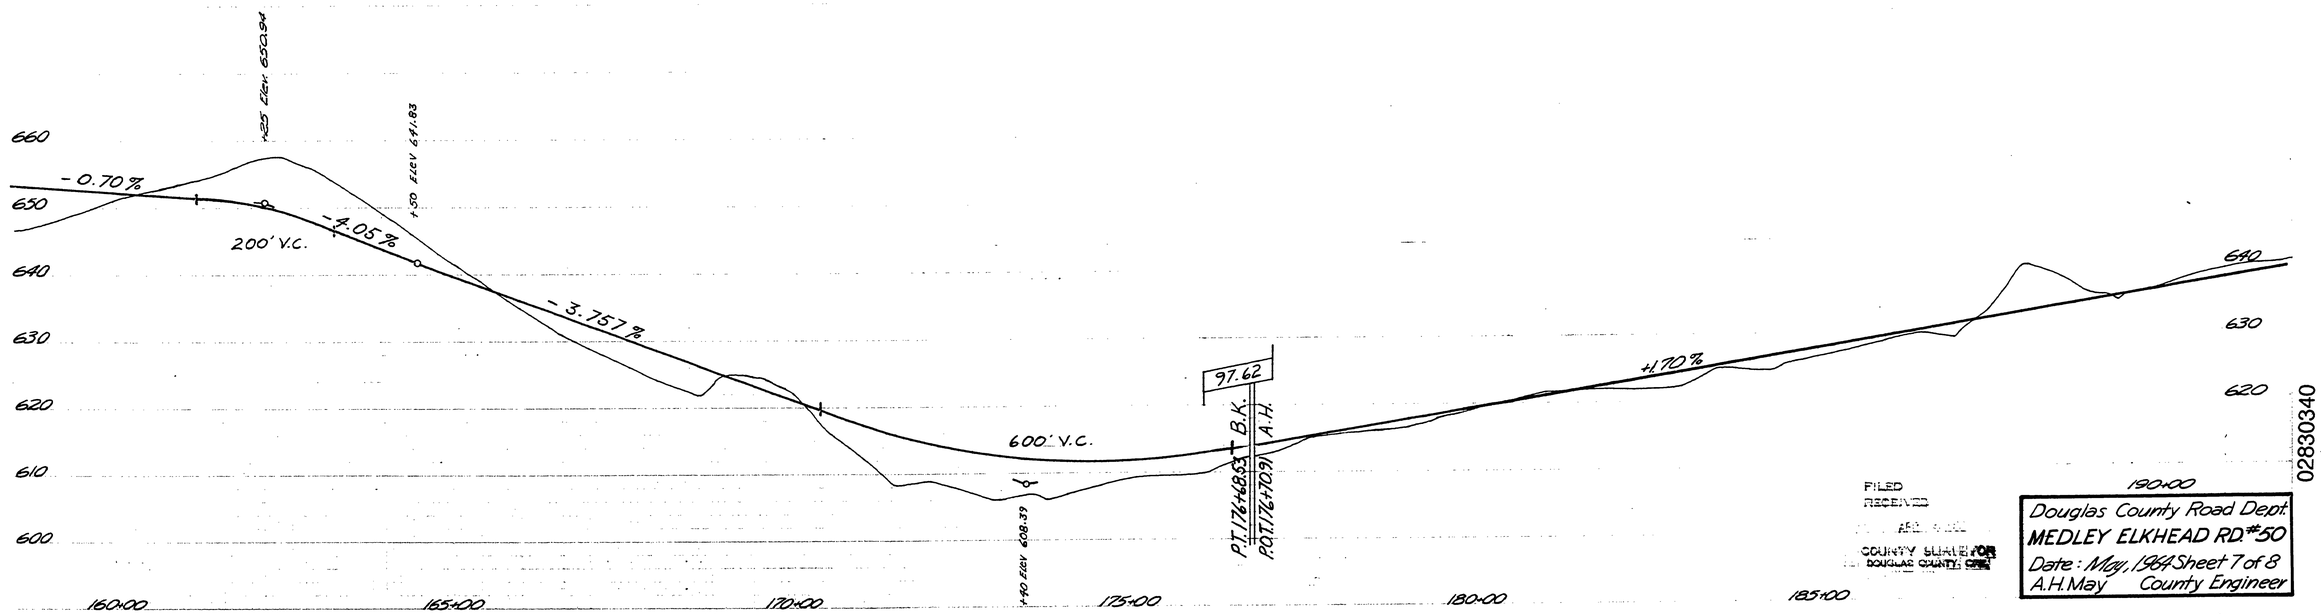

FILED
RECEIVED
COUNTY SURVEYOR
DOUGLAS COUNTY, ORE.

Douglas County Road Dept.
MEDLEY ELKHEAD RD. #50
Date: May, 1964 Sheet 7 of 8
A.H. May County Engineer

02830340

Co. Rd. #50 May, '64 sht. 7 of 8 (132)