RD 52

SEC 24.25.26 T27S R7W W.M.

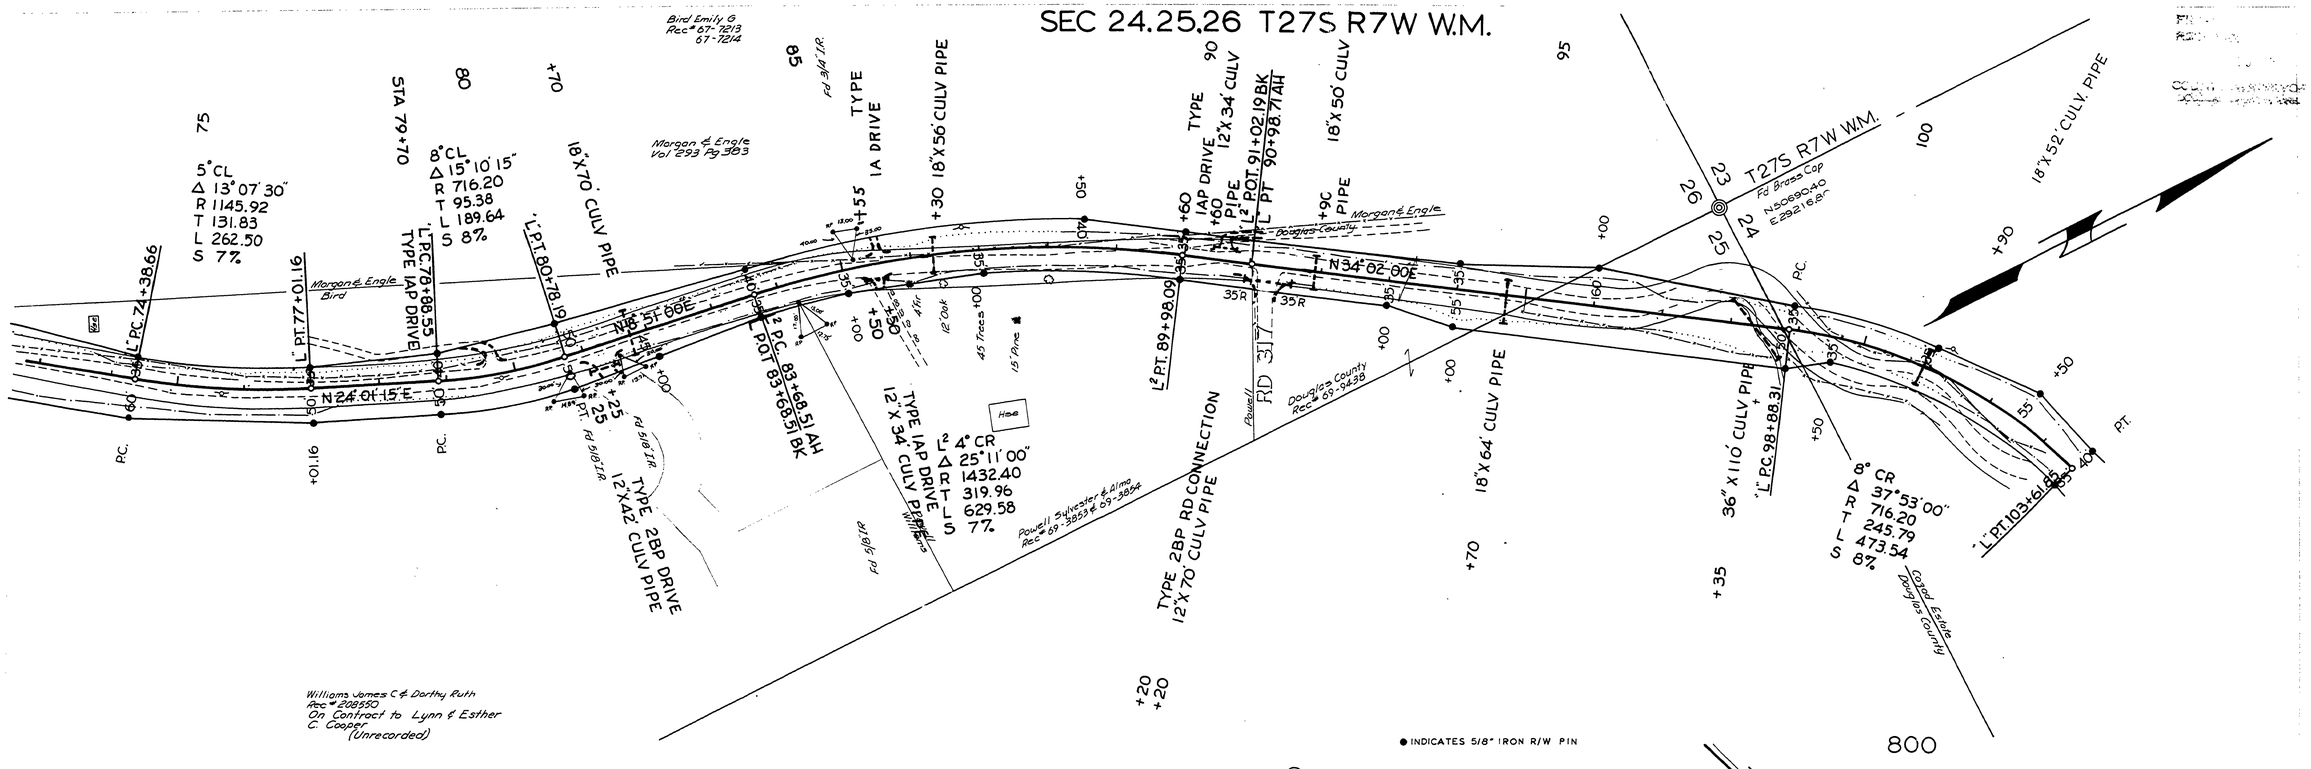

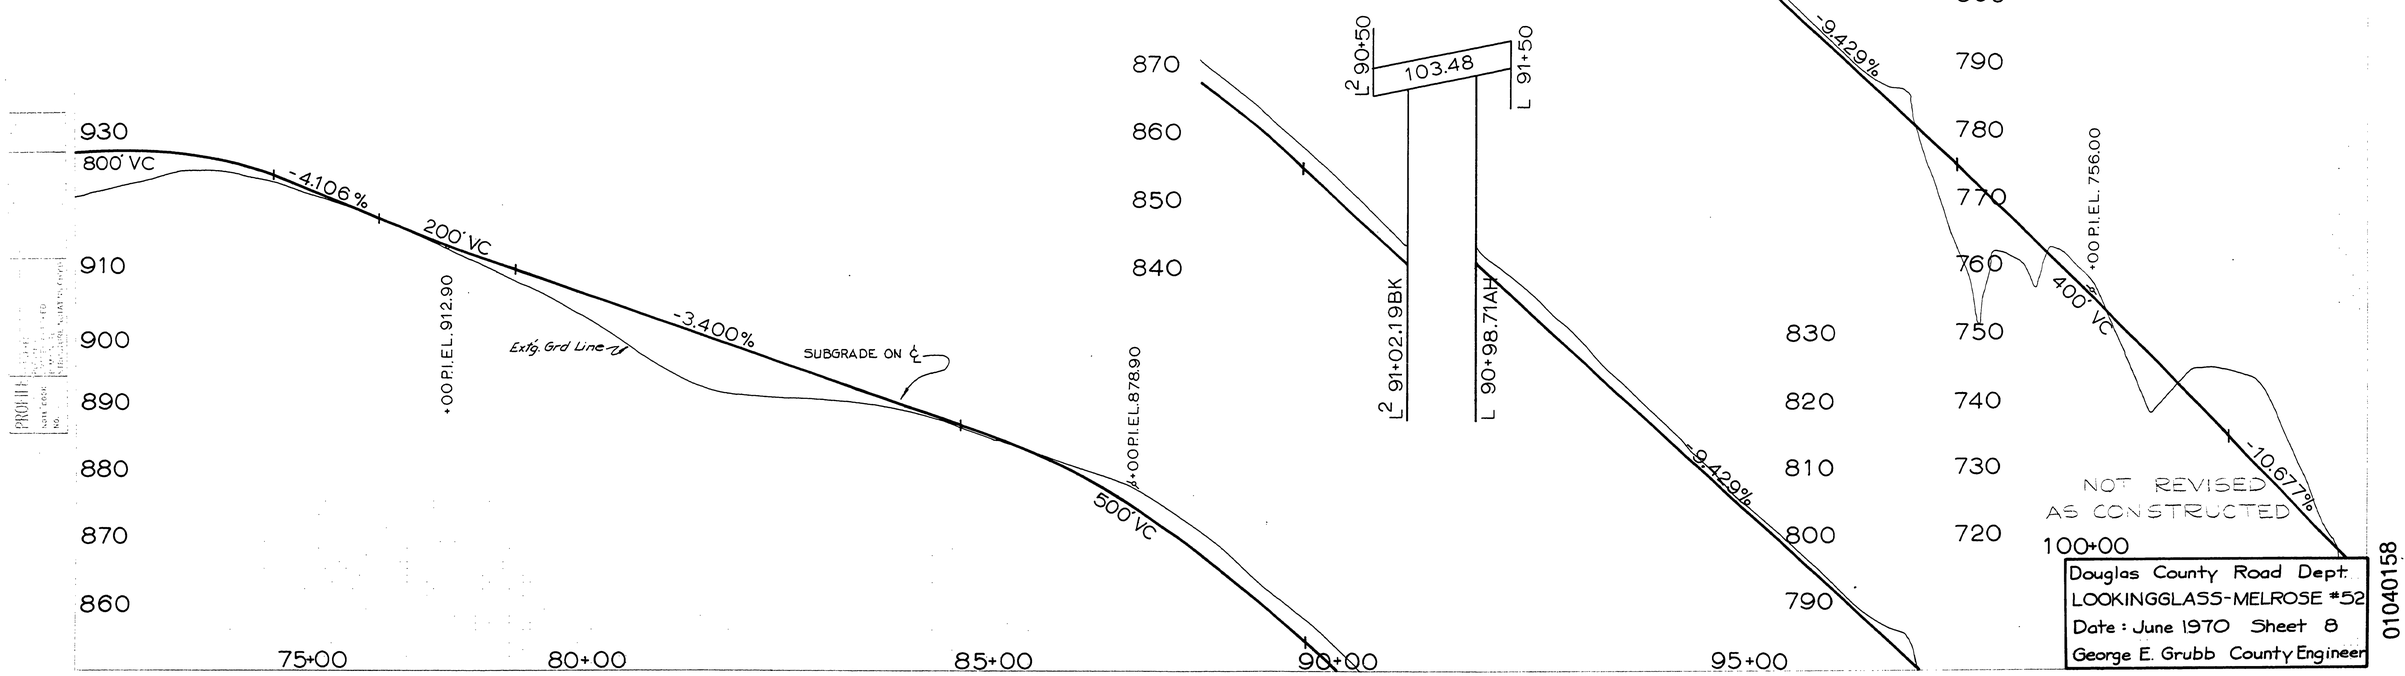

Douglas County Road Dept.
LOOKINGGLASS-MELROSE #52
Date: June 1970 Sheet 8
George E. Grubb County Engineer

01040158

M.P. 1.04 - 1.58

June 1970

C. Rd # 52 Sht. 8 of 14

27