SEC 12 T27S R7W W.M.

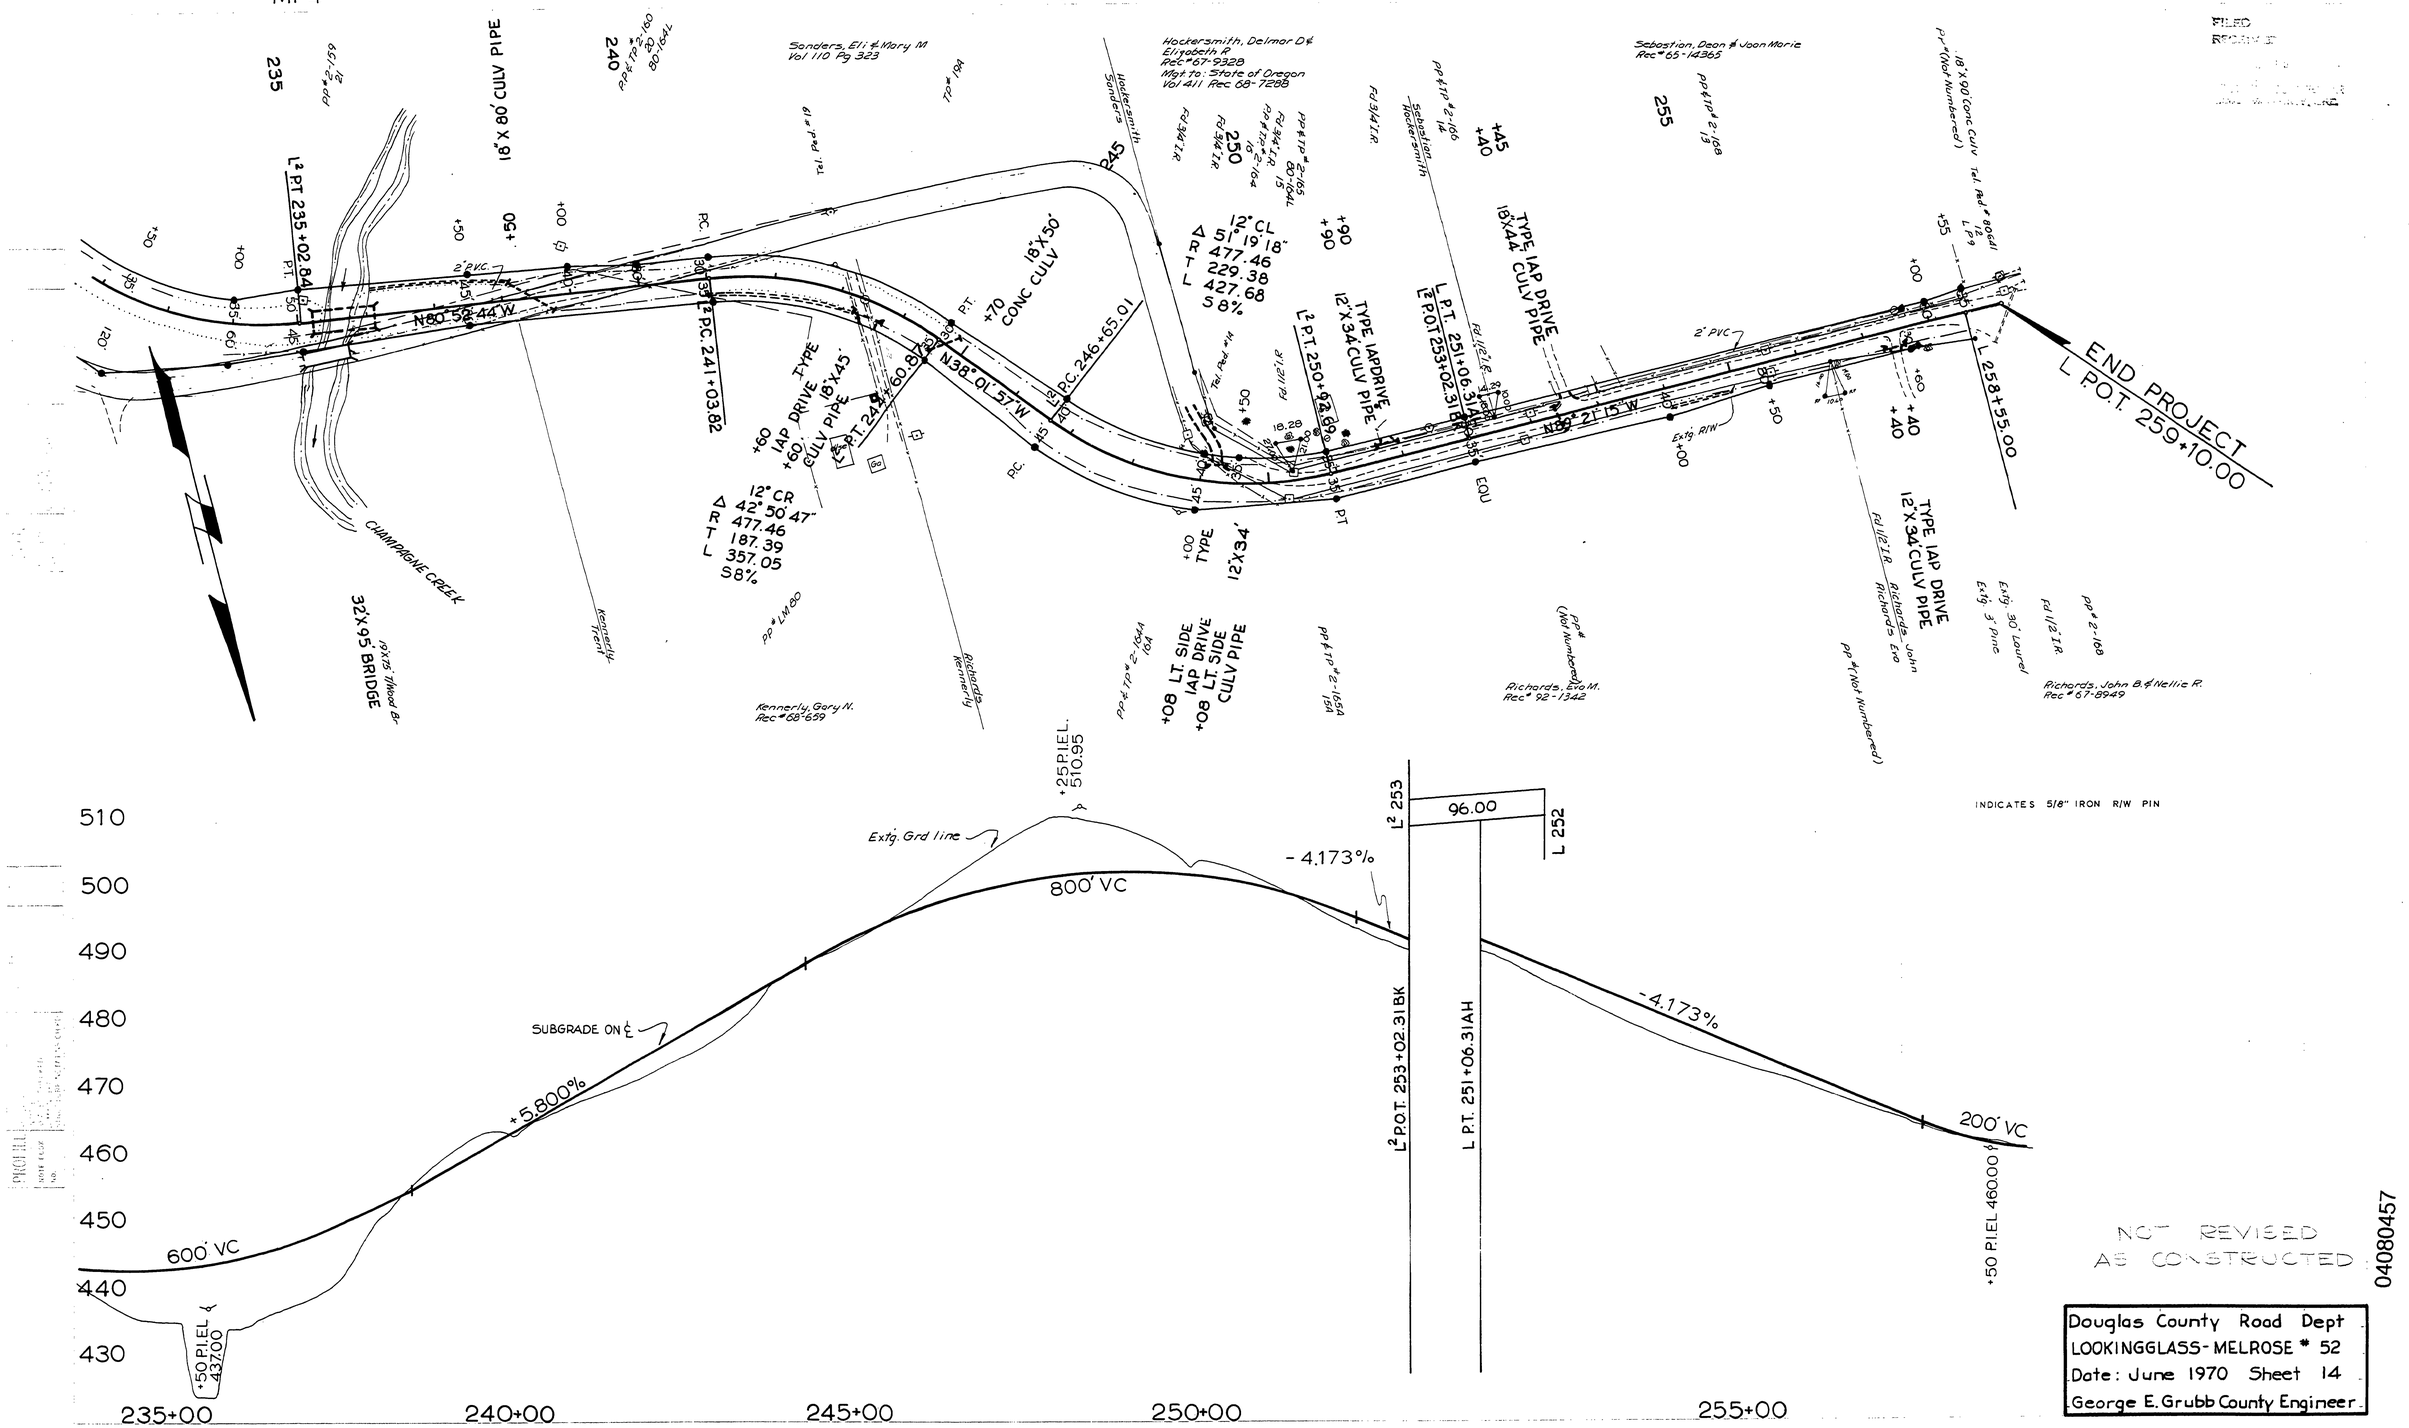

NOT REVISED AS CONSTRUCTED

04080457

Douglas County Road Dept
LOOKINGGLASS-MELROSE # 52
Date: June 1970 Sheet 14
George E. Grubb County Engineer

M.P. 4.08 - 4.57

C. Rd # 52 JUNE 1970 Sht. 14 of 14