SEC 34,35 T26S R7W W.M.

RD 53

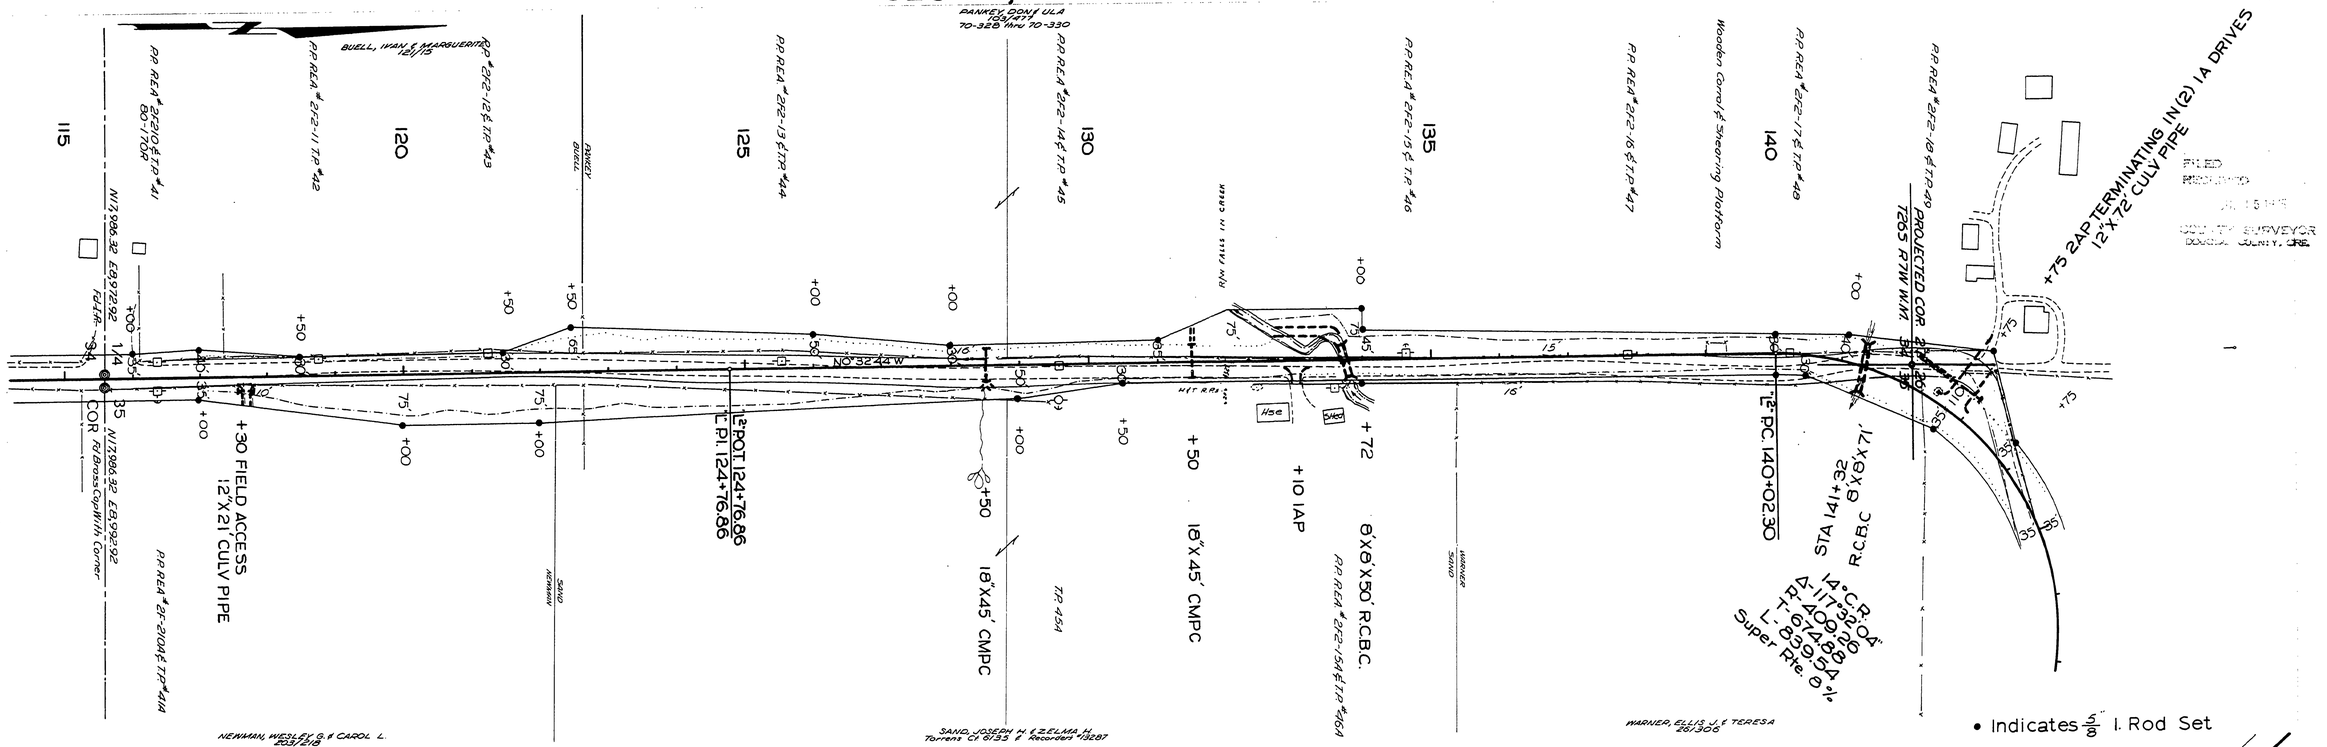

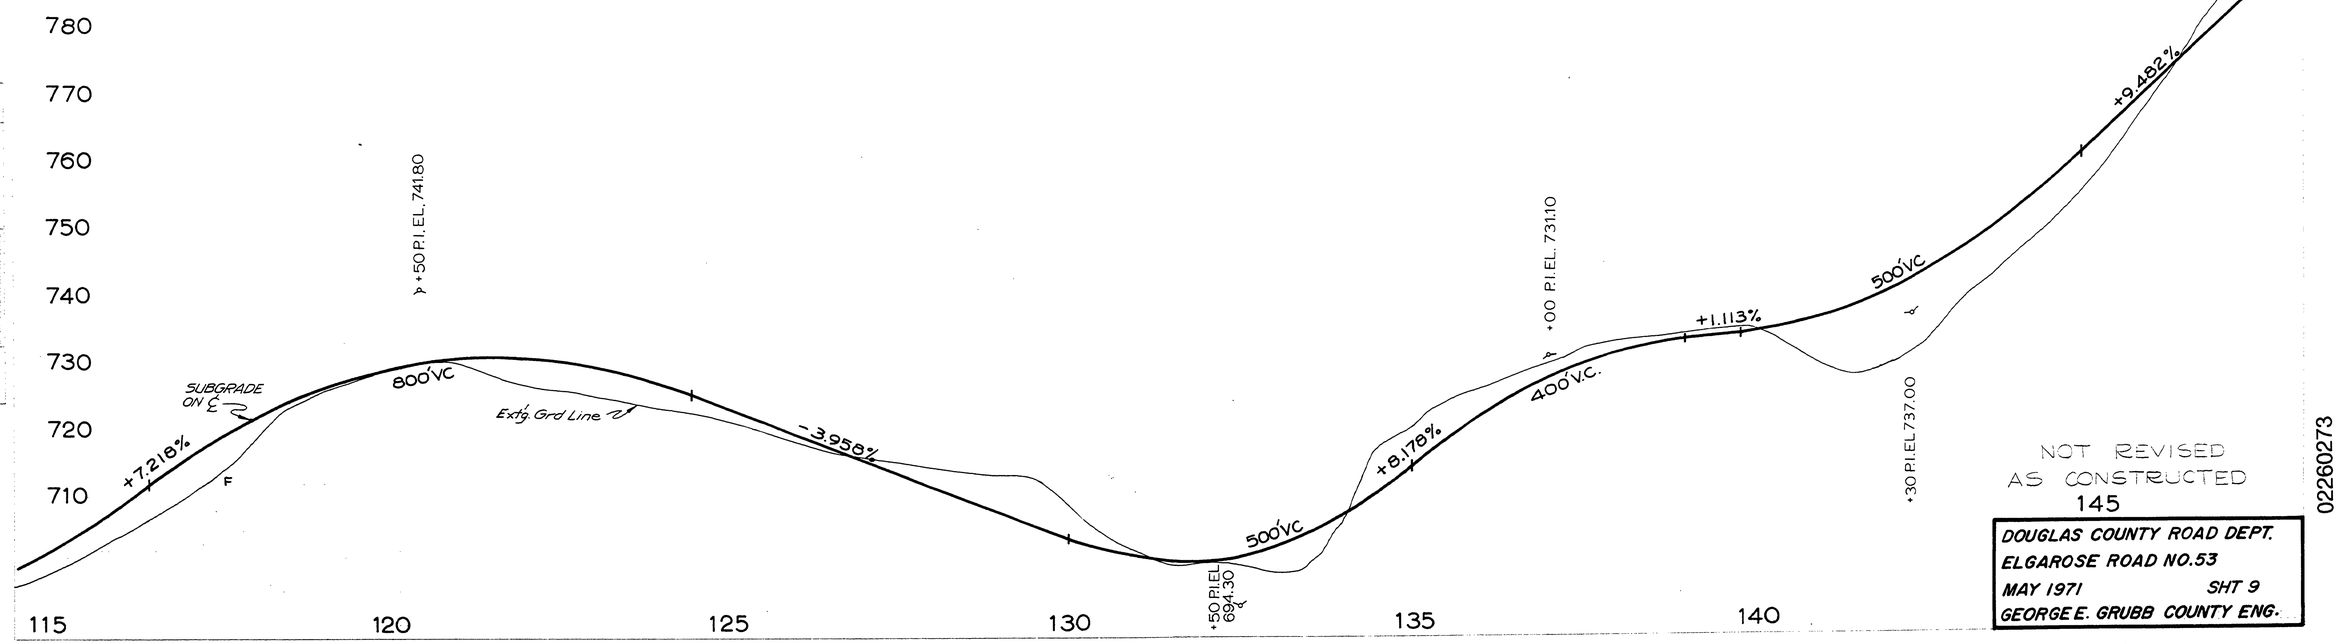

NOT REVISED
AS CONSTRUCTED

DOUGLAS COUNTY ROAD DEPT.
ELGAROSE ROAD NO.53
MAY 1971 SHT 9
GEORGE E. GRUBB COUNTY ENG.

02260273

M.P. 2.26-2.73

MAY, 1971
Co. Rd. # 53 sht. 9 of 14

45