FILED

SEC 26,35 T26S R7W W.M.

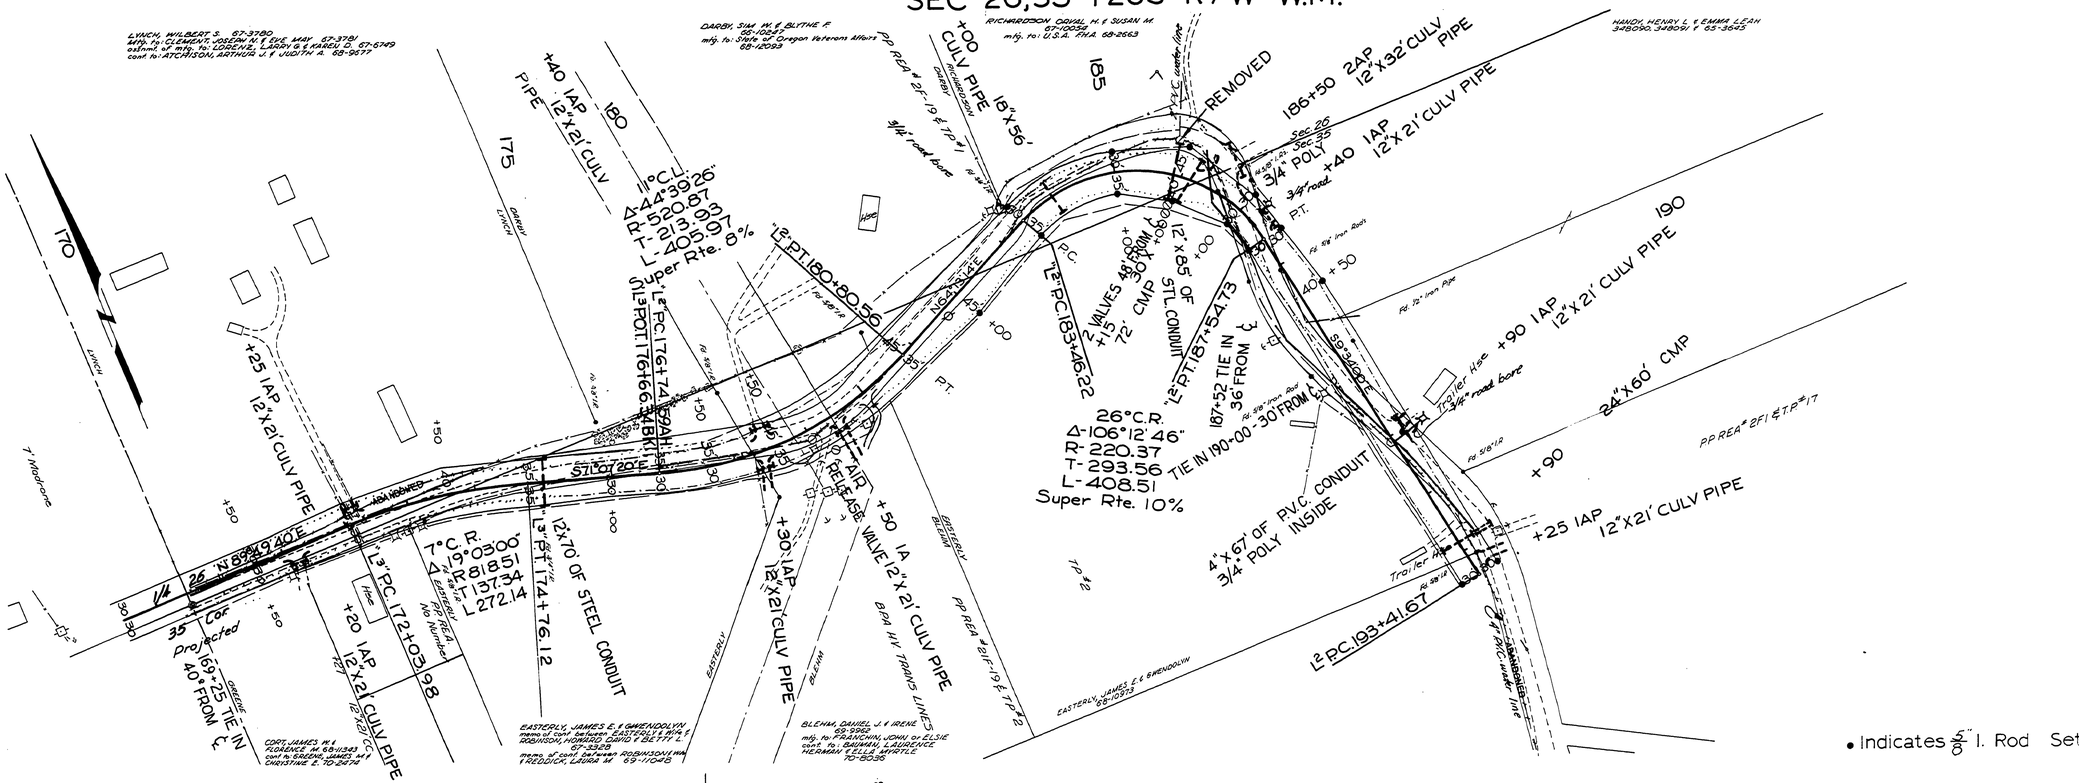
LYNCH, WILBERT S. 67-3780
mtg. to: CLEMENT, JOSEPH H. & EDE, MAY 67-3781
assmnt of mtg. to: LOSKENS, LANDY W. & KAREN D. 67-6749
cont to: ATCHISON, ARTHUR J. & JUDITH A. 68-9677
DARBY, SIM W. & BLYTHE F. 66-10257
mtg. to: State of Oregon Veterans Affairs 68-2093
RICHARDSON ORVAL H. & SUSAN M. 67-10037
mtg. to: U.S.A. FHA 68-2663
HANDI, HENRY L. & EMMA LEAN 348090, 348091 & 65-3643
PP REA # 2F-19 & TP #1
CULV PIPE
18"X56'
REMOVED
186+50 2AP 12"X32' CULV PIPE
+40 IAP 12"X21' CULV PIPE
+40 IAP 12"X21' CULV PIPE
11° C.U.
Δ-44°39'26"
R-520.87
T-213.93
L-405.97
super Rte. 8%
L² P.T. 180+80.56
L³ POT. 176+66.34
L² P.C. 176+74.59
L² P.C. 183+46.22
L² P.T. 187+54.73
2 VALVES 48' FROM 30'X +50
72" CMP
12"X85' OF STL CONDUIT
+15
26° C.R.
Δ-106°12'46"
R-220.37
T-293.56
L-408.51
Super Rte. 10%
187+52 TIE IN 36' FROM ℄
TIE IN 190+00 - 30' FROM ℄
4"X67' OF P.V.C. CONDUIT 3/4" POLY INSIDE
+90 IAP 12"X21' CULV PIPE
24"X60' CMP
+25 IAP 12"X21' CULV PIPE
+25 IAP 12"X21' CULV PIPE
7° C.R.
Δ-19°03'00"
R-818.51
T-137.34
L-272.14
L³ P.C. 172+03.98
L³ P.T. 174+76.12
12"X70' OF STEEL CONDUIT
+20 IAP 12"X21' CULV PIPE
+30 IAP 12"X21' CULV PIPE
+50 IA VALVE 12"X21' CULV PIPE
AIR RELEASE
BPA HV TRANS LINE
PP REA # 2F-19 & TP #2
PP REA # 2F1 & T.P. #17
7" Waterline
35' Cor Projected
169+25 TIE IN 40' FROM ℄
CORT, JAMES, M. & FLORENCE, M. 68-11343
cont to: GREENE, JAMES, M. & CHRISTINE E. 70-2474
EASTERLY, JAMES E. & GWENDOLYN
memo of cont between EASTERLY & WM. F. ROBINSON, HOWARD DAVID & BETTY L. 67-3549
memo of cont between ROBINSON & WM. F. REDDICK, LAURA M. 69-11048
BLEHM, DANIEL J. & IRENE 69-9960
mtg. to: FRANCHINI, JOHN or ELSIE
cont to: BAUMAN, LAURENCE HERMAN & ELLA MYRTLE 70-8636
EASTERLY, JAMES E. & GWENDOLYN 68-10373
7" P.V.C. WATER LINE
Trailer Hse
3/4" road bore
Fd 5/8" Iron Rod
Fd 5/8" Iron Pipe
Fd 5/8" Iron Rod
Fd 5/8" 1.R.
Fd 3/8" 1.R.
Fd 3/8" 1.R.
Fd 5/8" Iron Rod
Sec 26
Sec 35
N 89°29'40" E
S 89°30'40" E
N 54°35'14" E
S 71°07'20" E
NO REVISED
NO NUMBER
EASTERLY
WESTERLY
GREENE
LYNCH
CORT
DARBY
RICHARDSON
170
175
180
185
190
+50
+00
+25
+90
+40
+20
+30
+50
+00
+90
+25
+50
+00
+50
+00
+50
+00