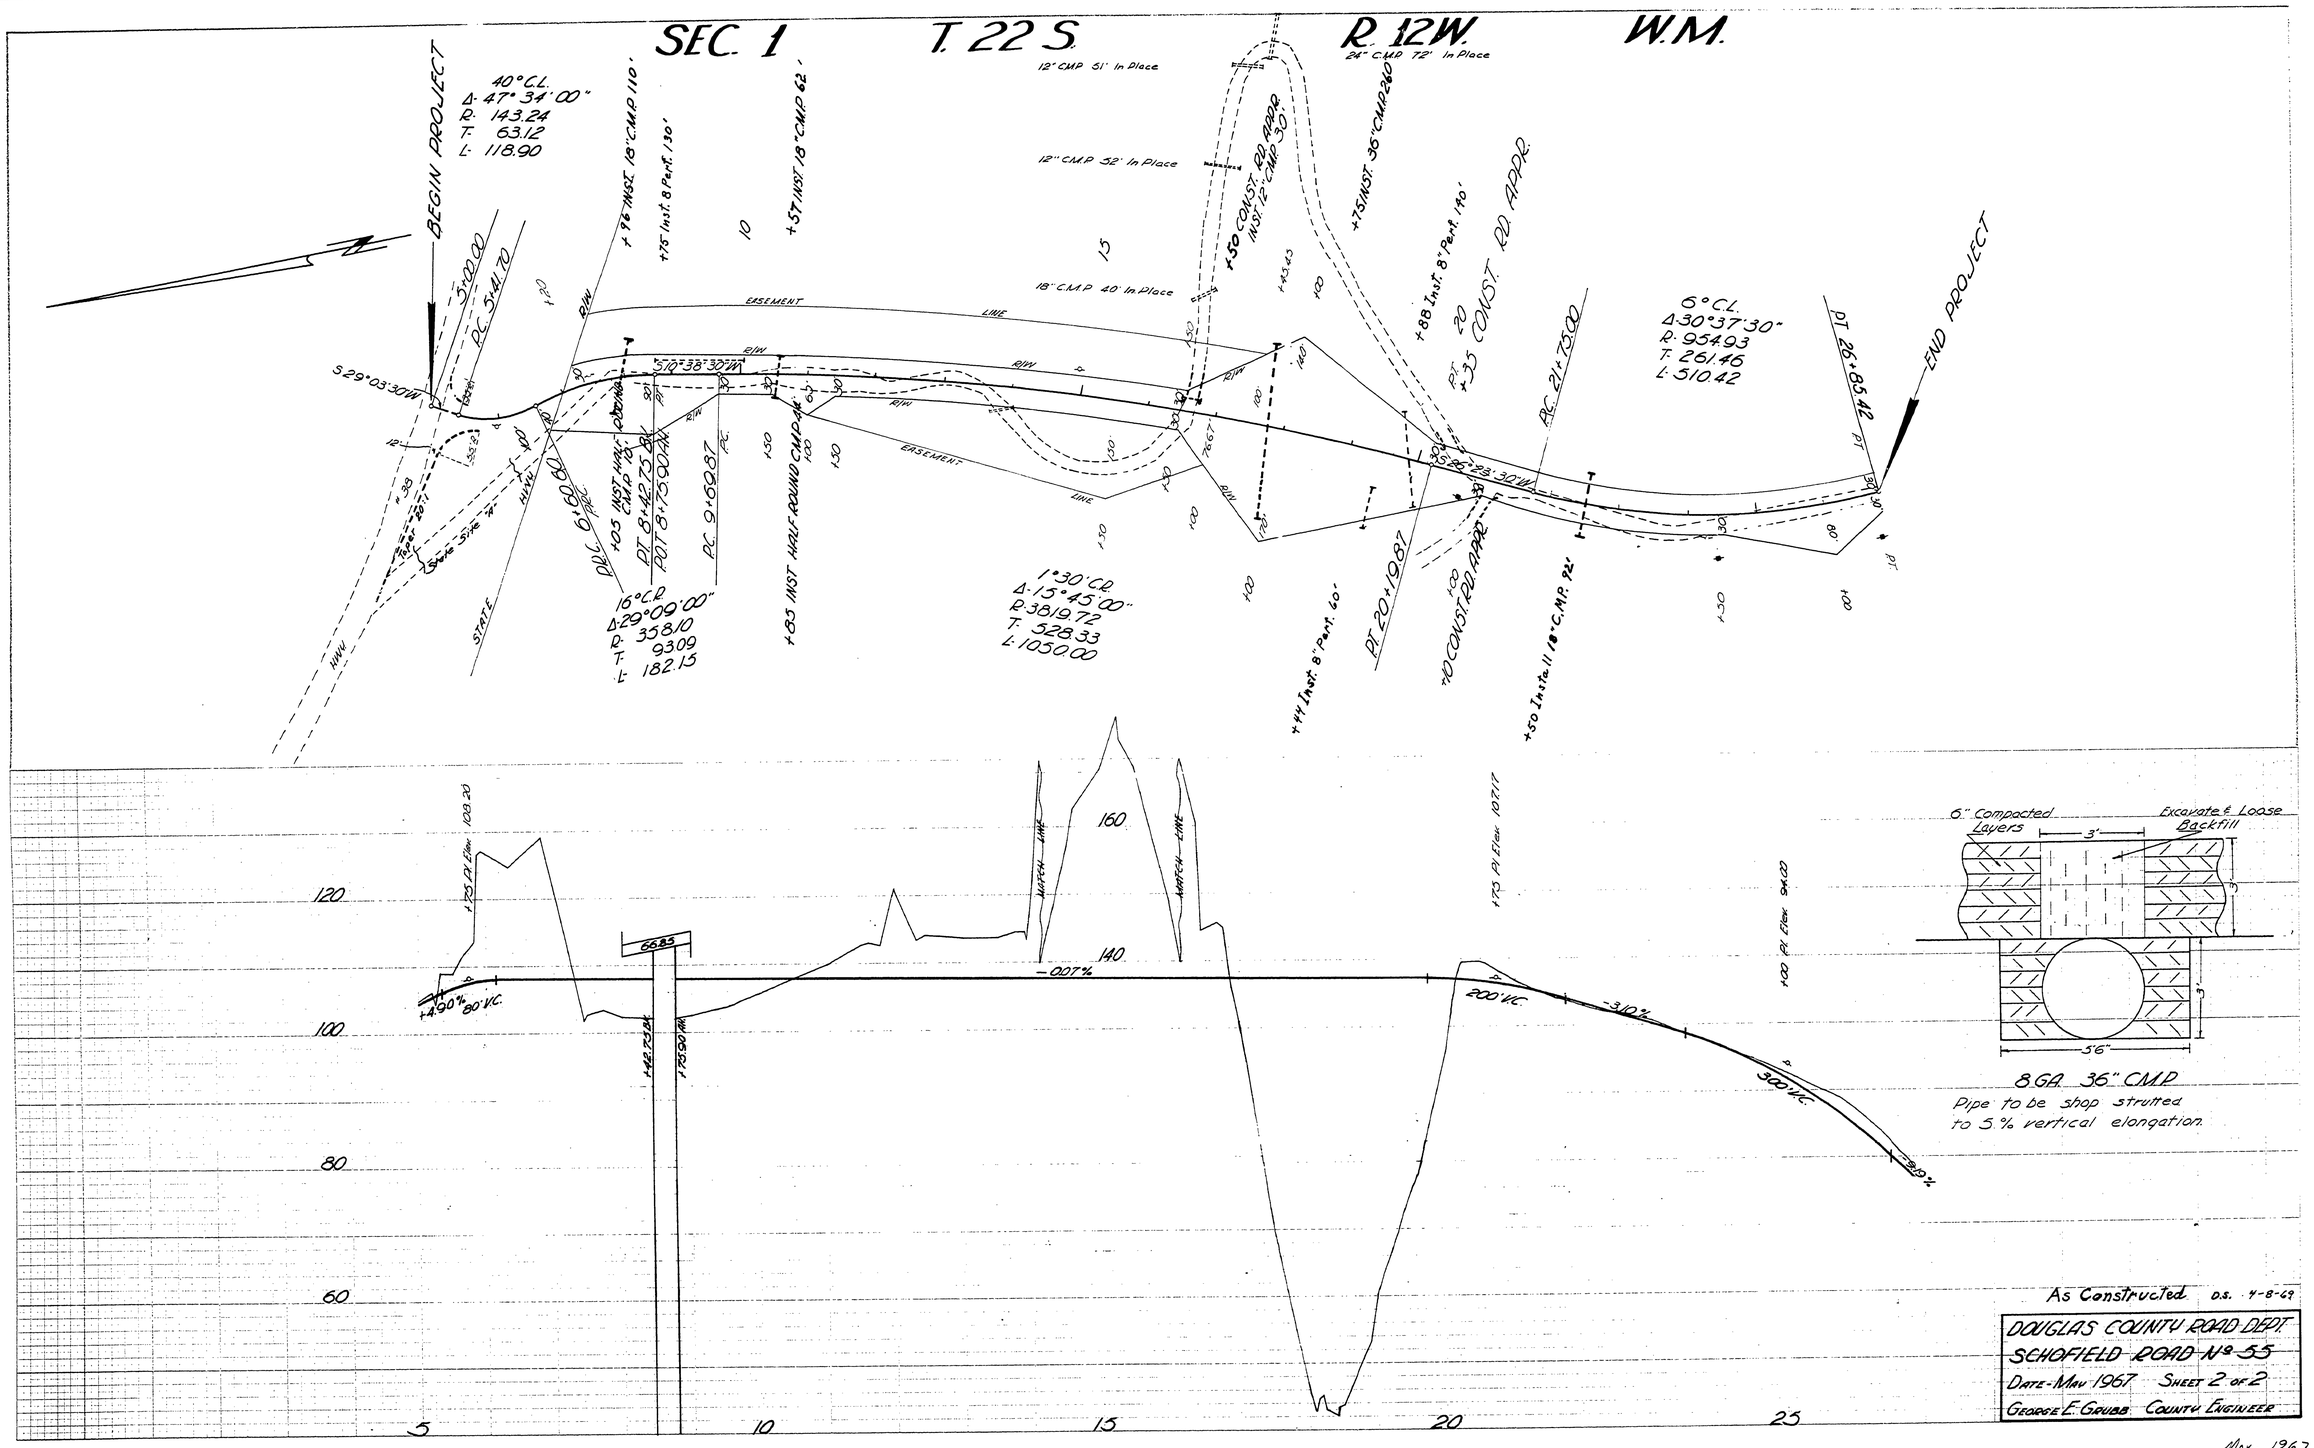

M.P. 0.00 - 0.41

May, 1967

G. Rd. # 55 Sht. 2 of 2

52

00000041