


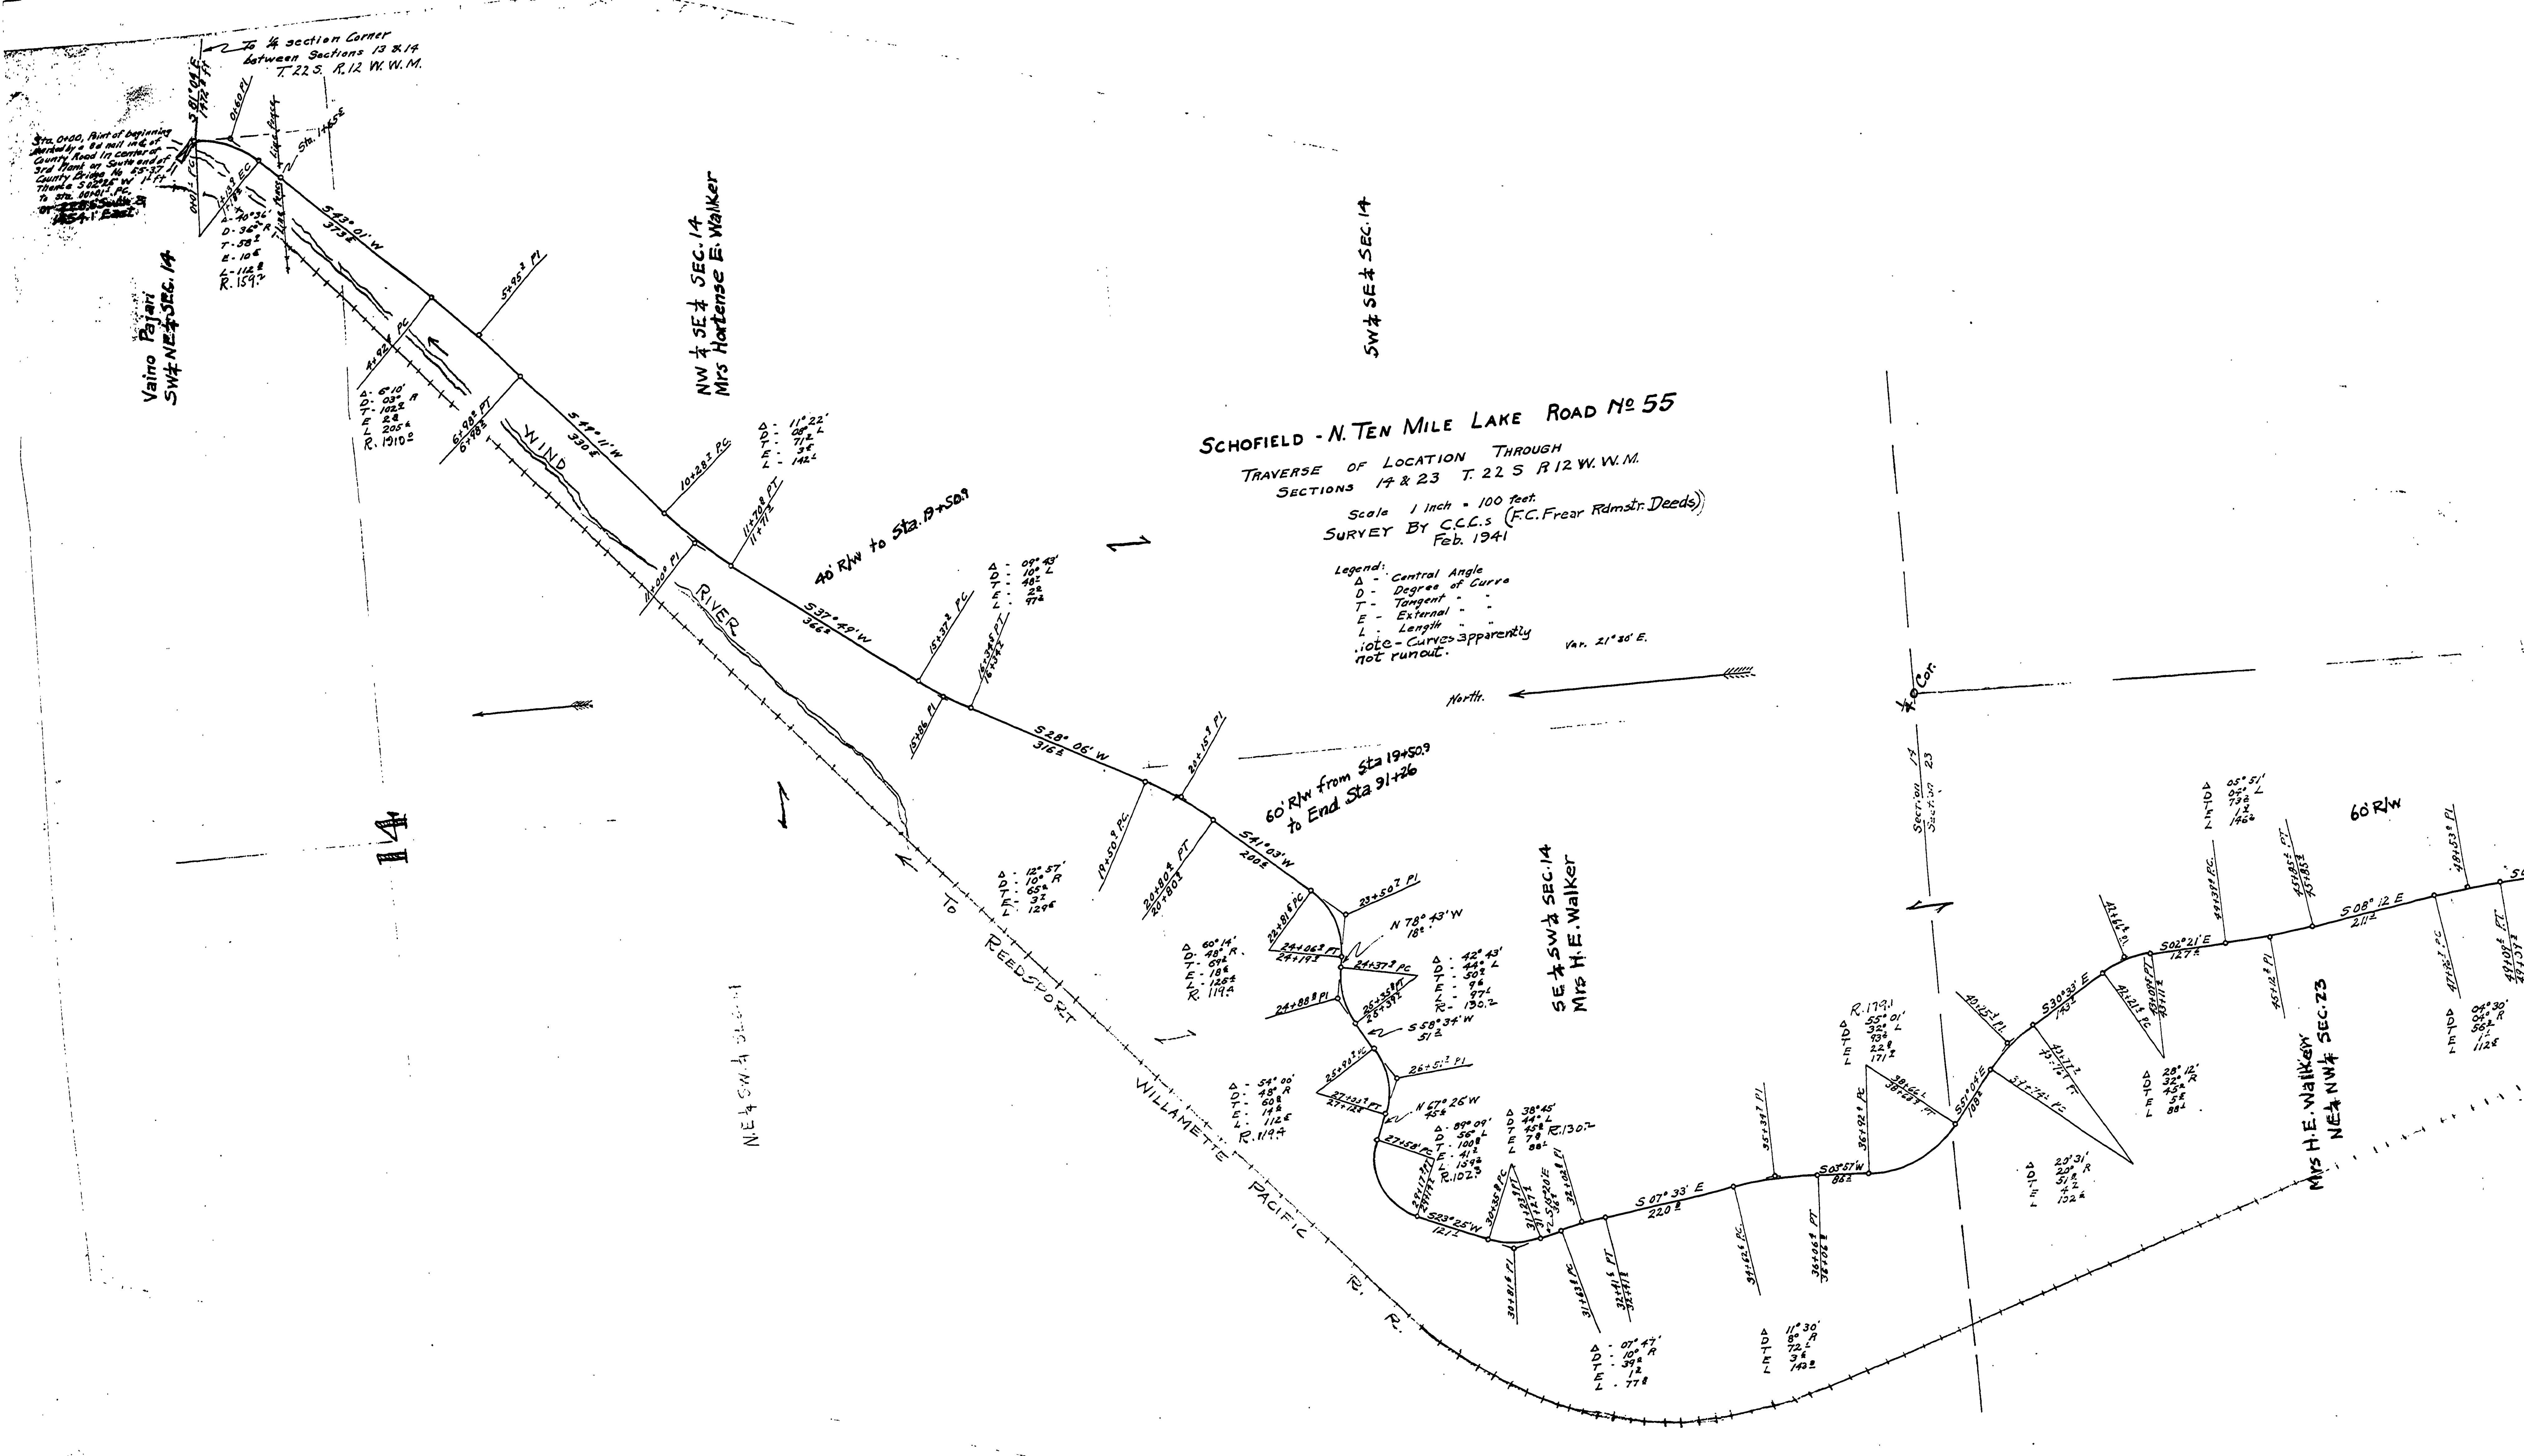

30 X