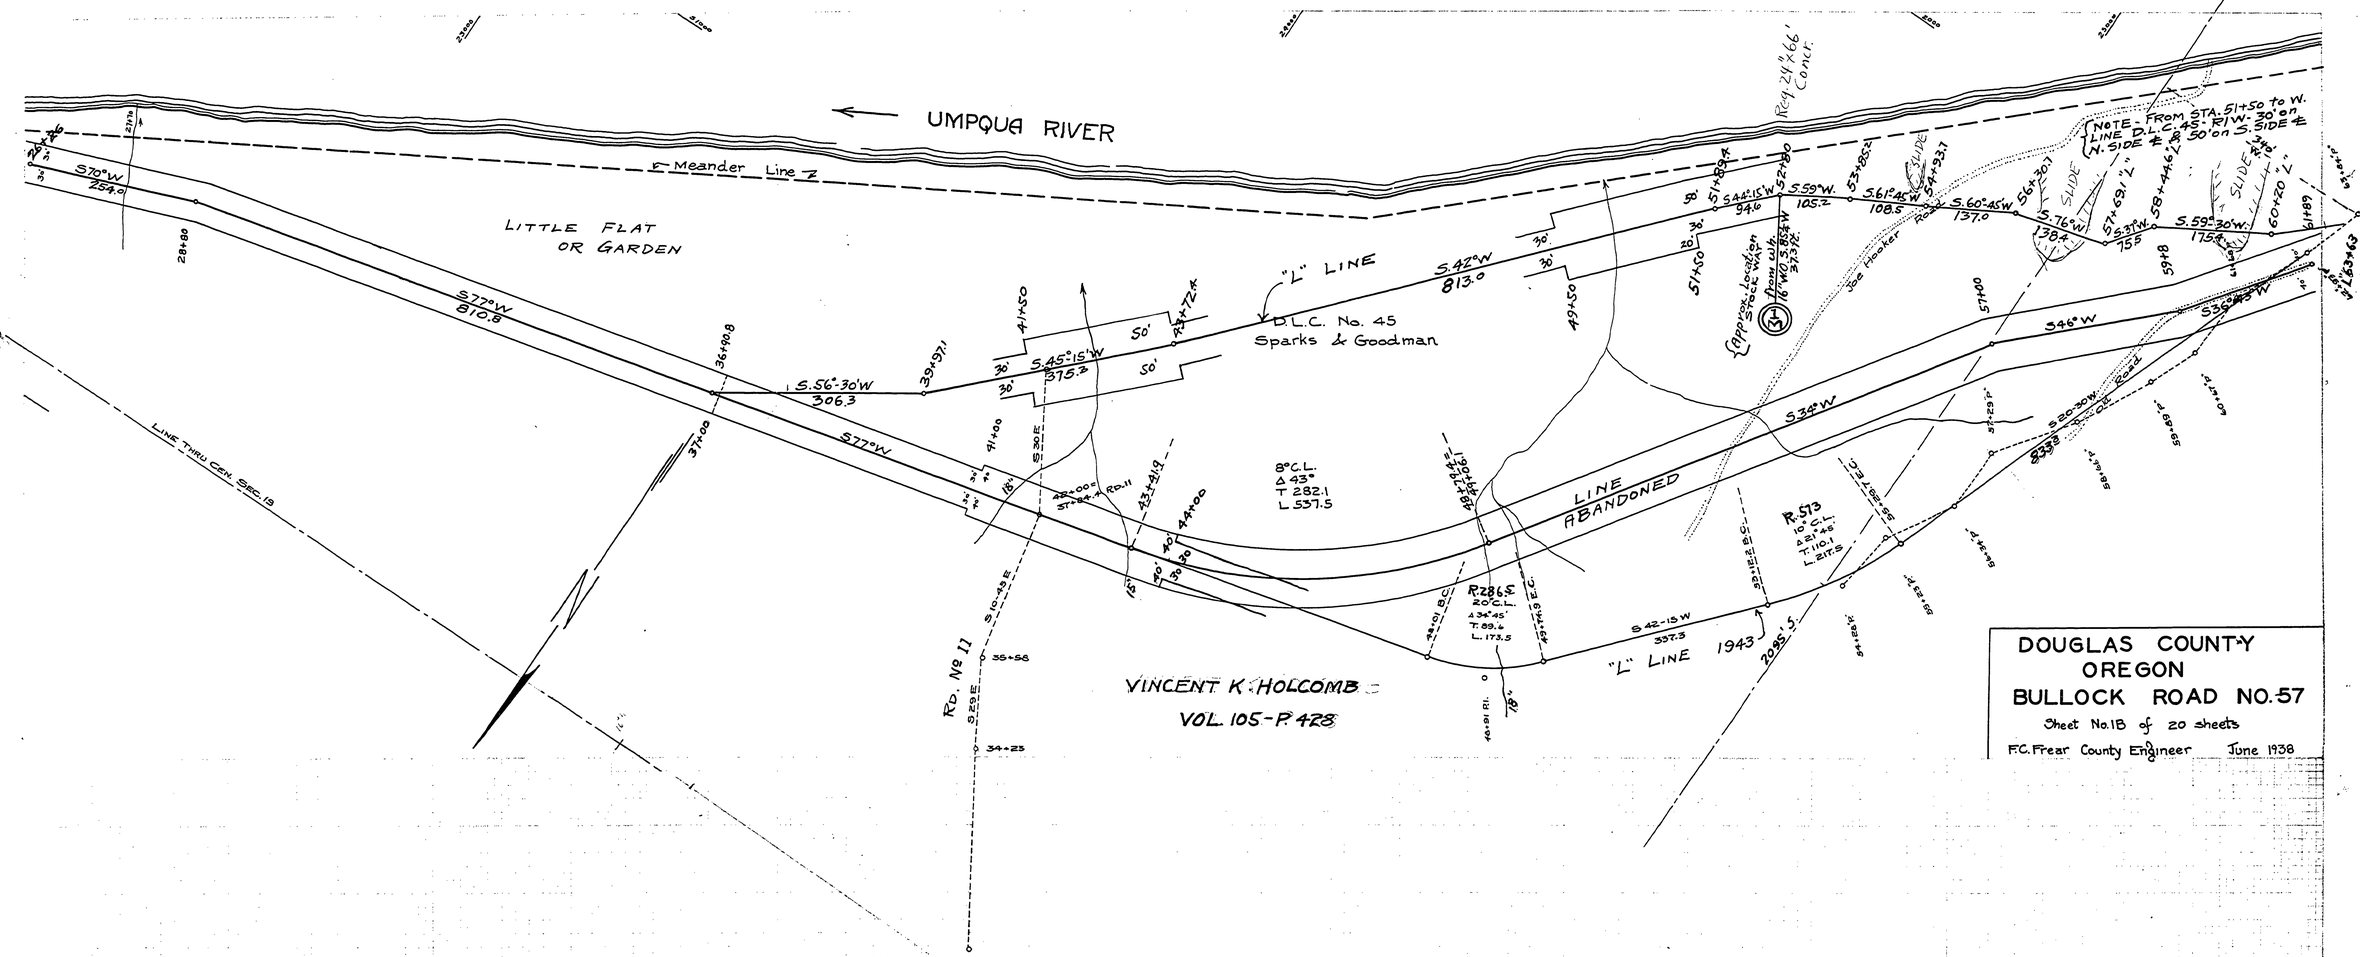

DOUGLAS COUNTY
OREGON
BULLOCK ROAD NO. 57
Sheet No. 1B of 20 sheets
F.C. Frear County Engineer June 1938

00550121

M.P. 0.55 - 1.21

T 23-7 S 19 FEB 1936 SHT 1B OF 20 (41)