


PROPOSED KELLOGG-TYEE ROAD. 57
Feb. 1938

- LEGEND
==== Surf. Rds.
----- Forest & Private Rds
- - - Trails
- - - Proposed Rd. 57
IM-MILE POSTS
• RESIDENCES
--- F- Ferry or Crossing

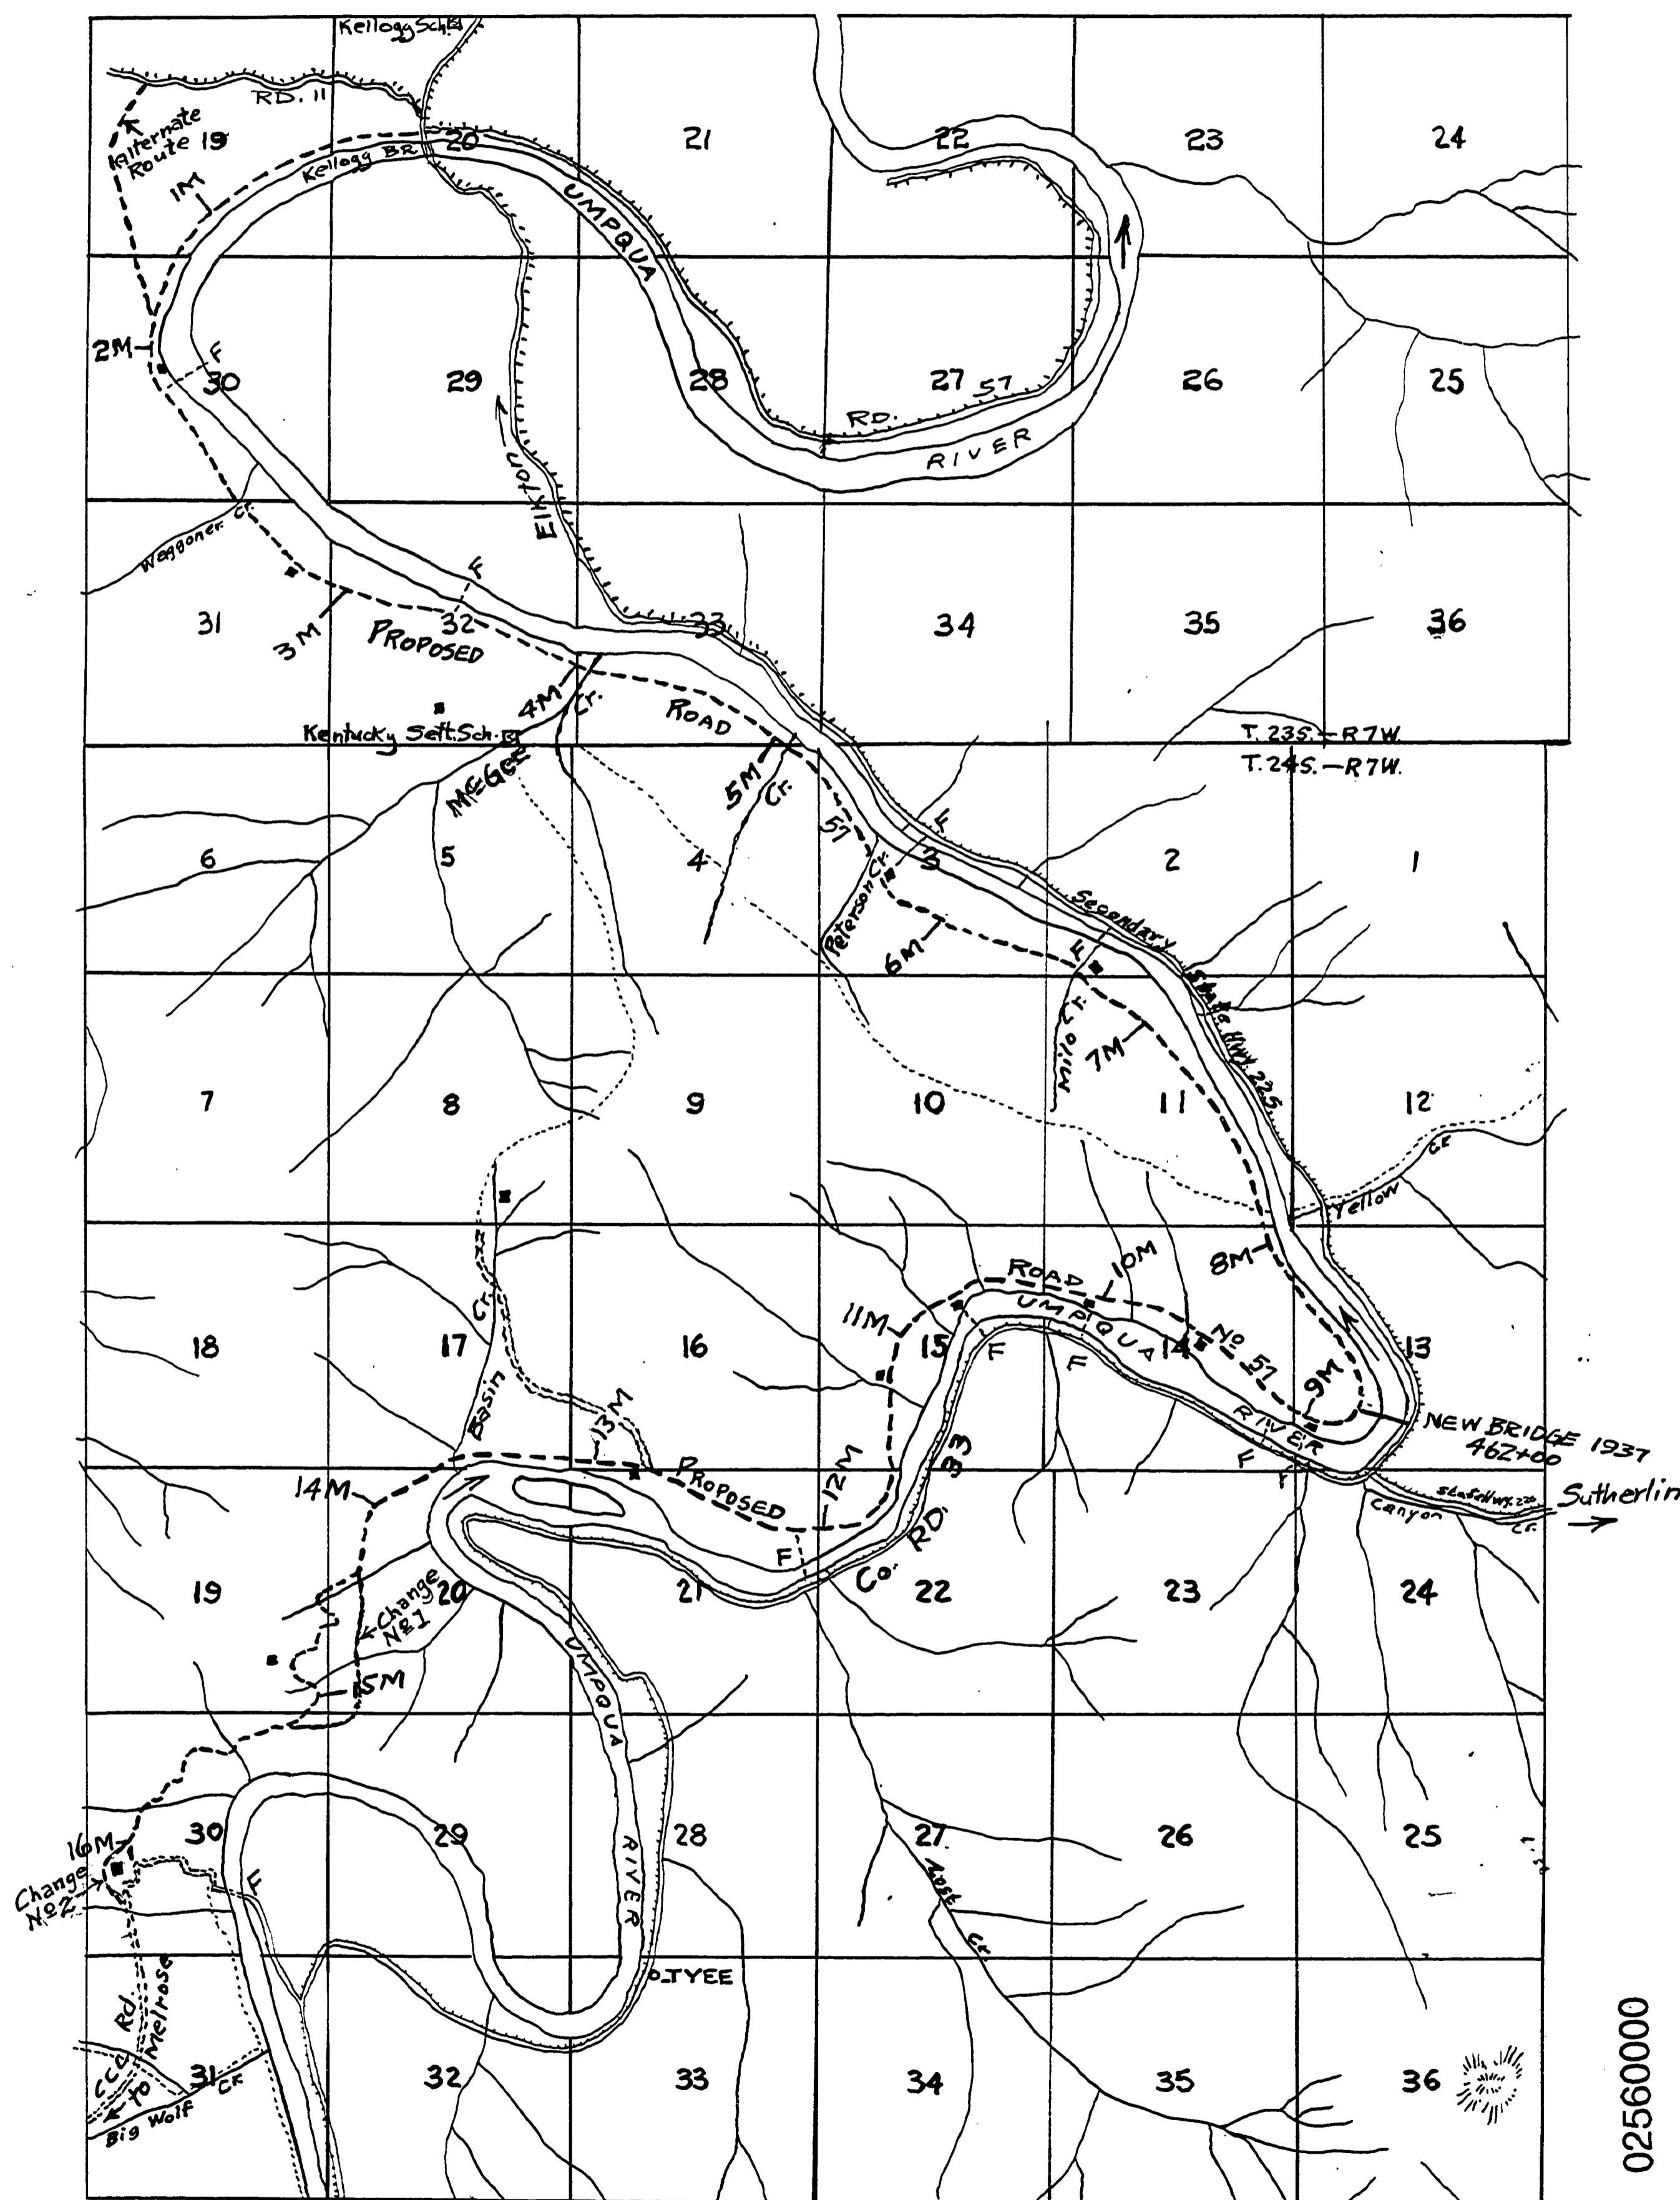

02560000

M.P. 1500-010 Co. Rd. # 57 & 57D
T 23-7 & T 24-7 FEB 1938 (63)