




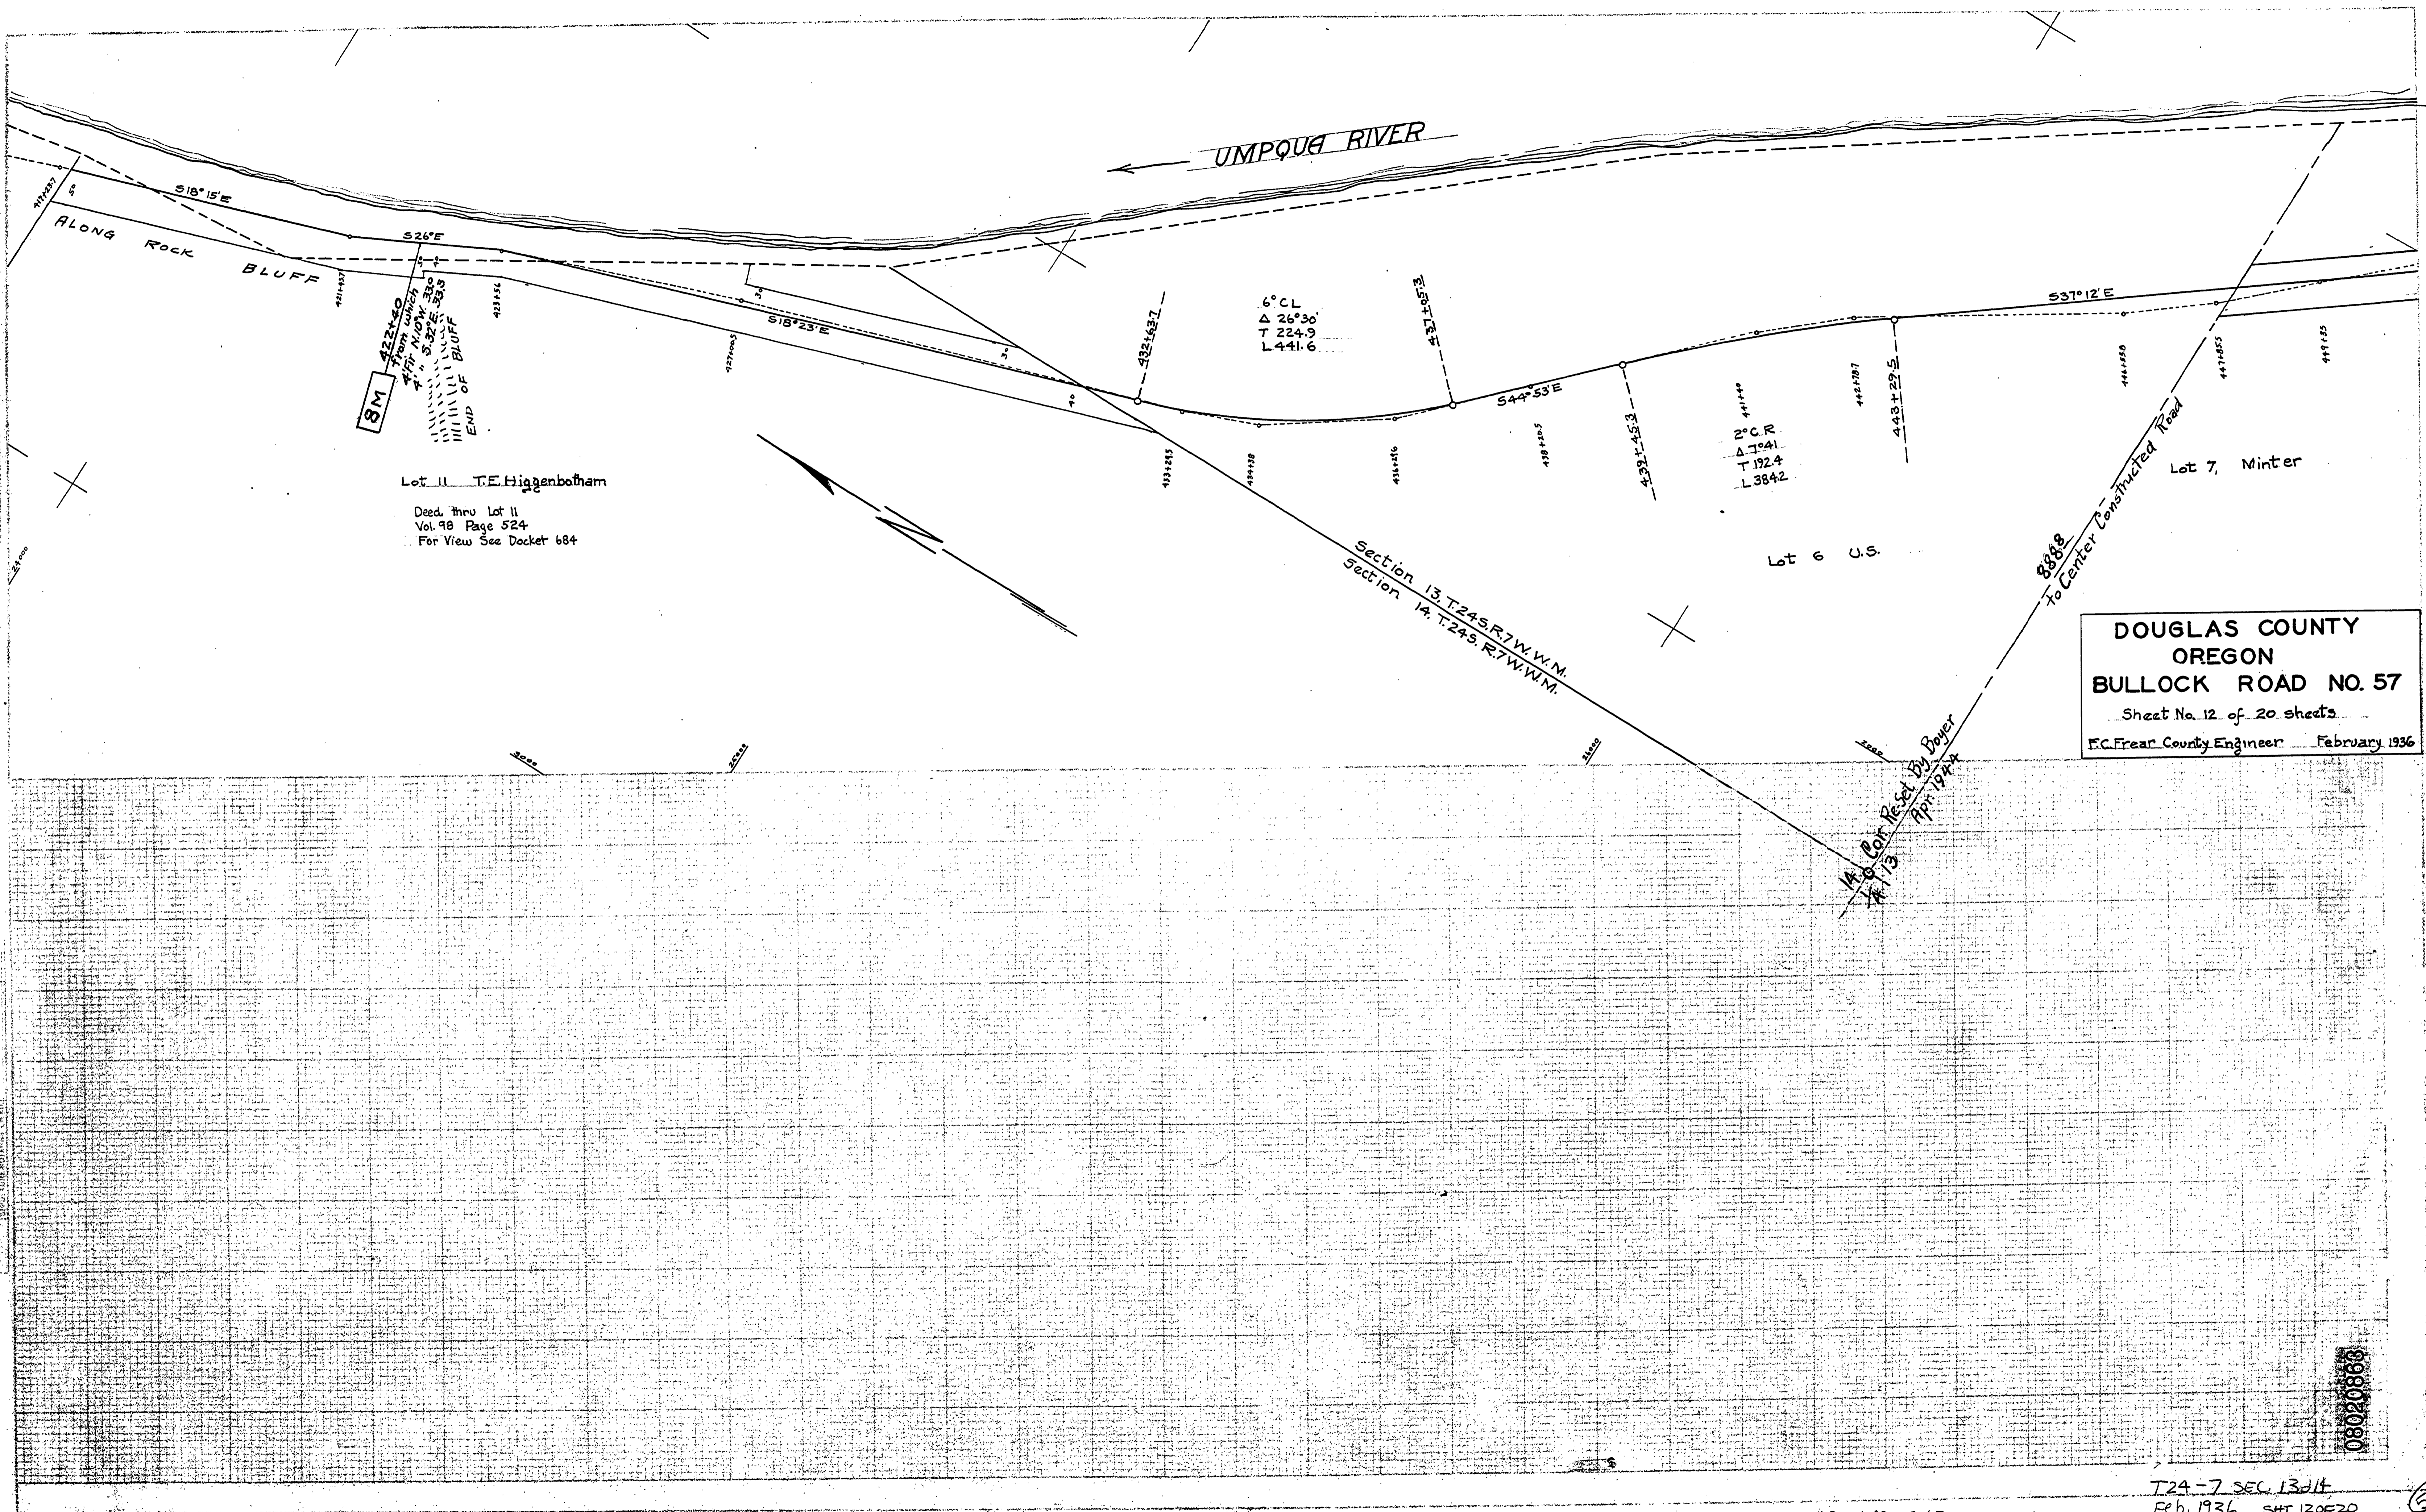

Lot 11 T.E. Higgenbotham  
 Deed thru Lot 11  
 Vol. 98 Page 524  
 For View See Docket 684

**DOUGLAS COUNTY**  
**OREGON**  
**BULLOCK ROAD NO. 57**  
 Sheet No. 12 of 20 sheets  
 F.C. Freear, County Engineer February 1936

~ M.P. 8.02 - 8.63

T24-7 SEC. 13d1t  
 Feb. 1936 SHT 12 OF 20


62