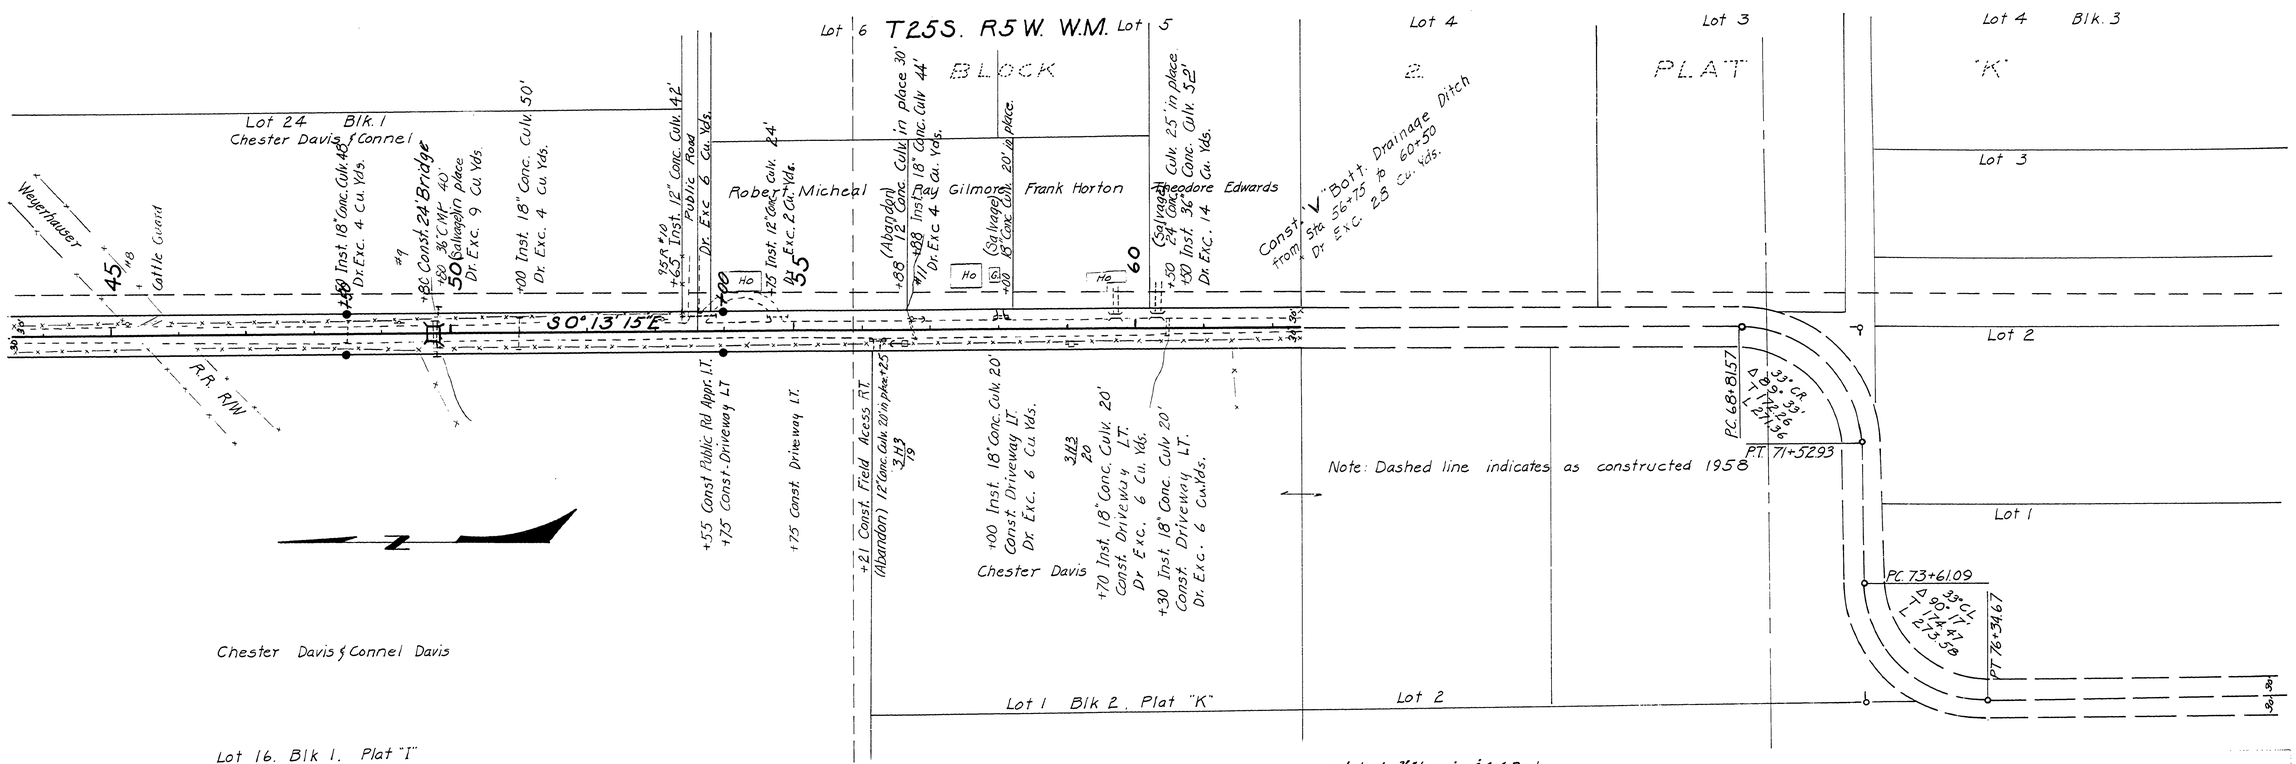

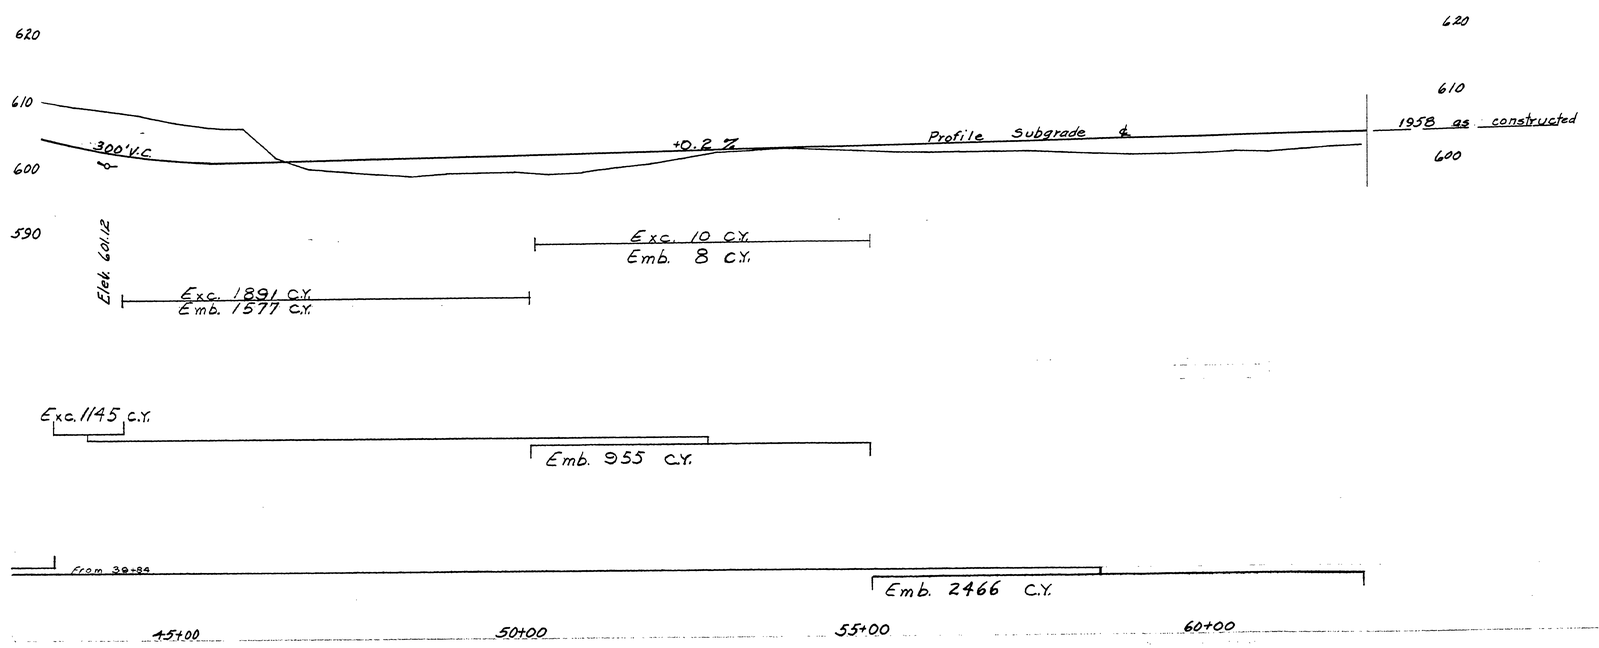

DOUGLAS COUNTY, OREGON
PLAT "K" ROAD No. 75
Twp. 25S Rge. 5 W.
Sec. 13 Sheet 7 of 8
Scales April 1961
Map 1" = 100'
Profile: Horz. 1" = 100'
Vert. 1" = 10'

A. H. May County Engineer

00880123

M.P. 0.88 - 1.23

G. Rd. # 75 Apr. '61 Sht. 7 of 8

17