DOUGLAS COUNTY, OREGON

PLANS FOR PROPOSED PROJECT

GRADING & SURFACING

GREEN VALLEY HWY NO. 76

1972

MILE POINT 0.00 TO MILE POINT 0.56

ALSO KNOWN AS RD NO. 23

FILED
RECEIVED
COUNTY SURVEYOR
DOUGLAS COUNTY, ORE.

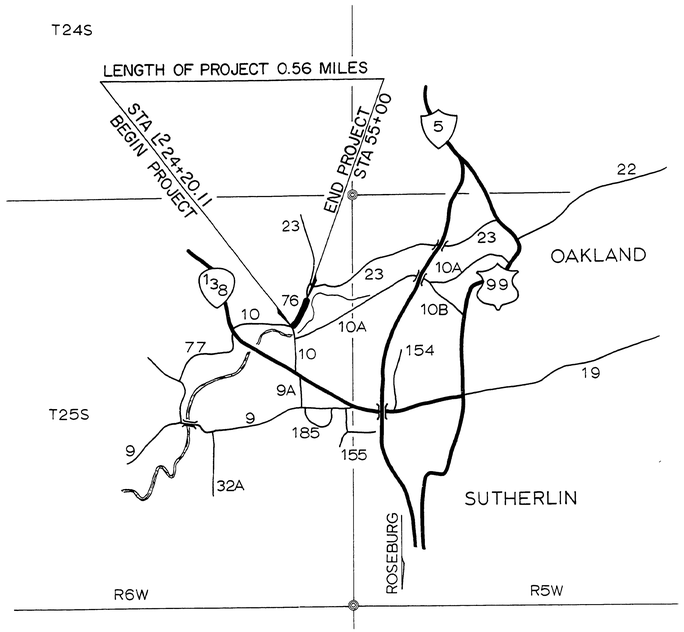

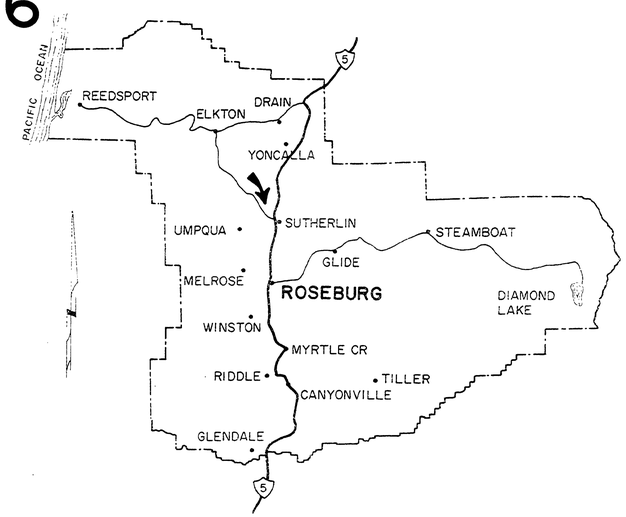

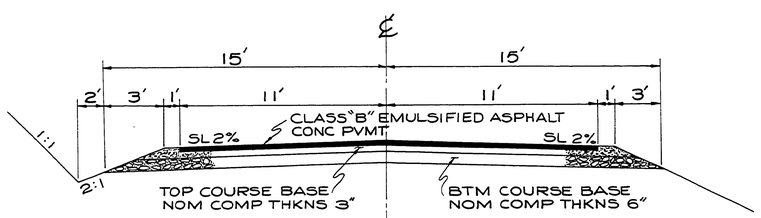

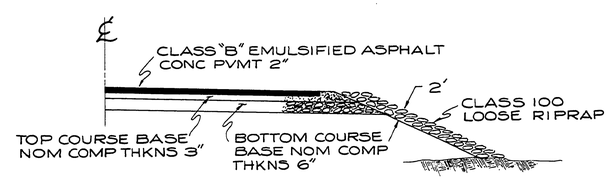

STA	TO	STA
24+20	"	27+00
45+00	"	53+25

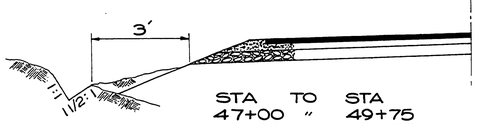

STA	TO	STA
47+00	"	49+75
51+00	"	51+75

INDEX OF DRAWINGS

SHEET NUMBER	
1	TITLE SHEET & TYPICAL SECTION
2	QUANTITY SUMMARY
3	ROAD PLAN

STANDARD DRAWINGS
1, 6 & 9

TOTAL OF 6 SHEETS

NOT REVISED
AS CONSTRUCTED

REGISTERED PROFESSIONAL ENGINEER #250 OREGON MAY 2, 1958 GEORGE E. GRUBB

DOUGLAS COUNTY ROAD DEPT.
GREEN VALLEY HWY NO. 76
1972 SHT 1
GEORGE E. GRUBB COUNTY ENGR.

0000012C

Co Rd # 76 1972 sht 1 (20)