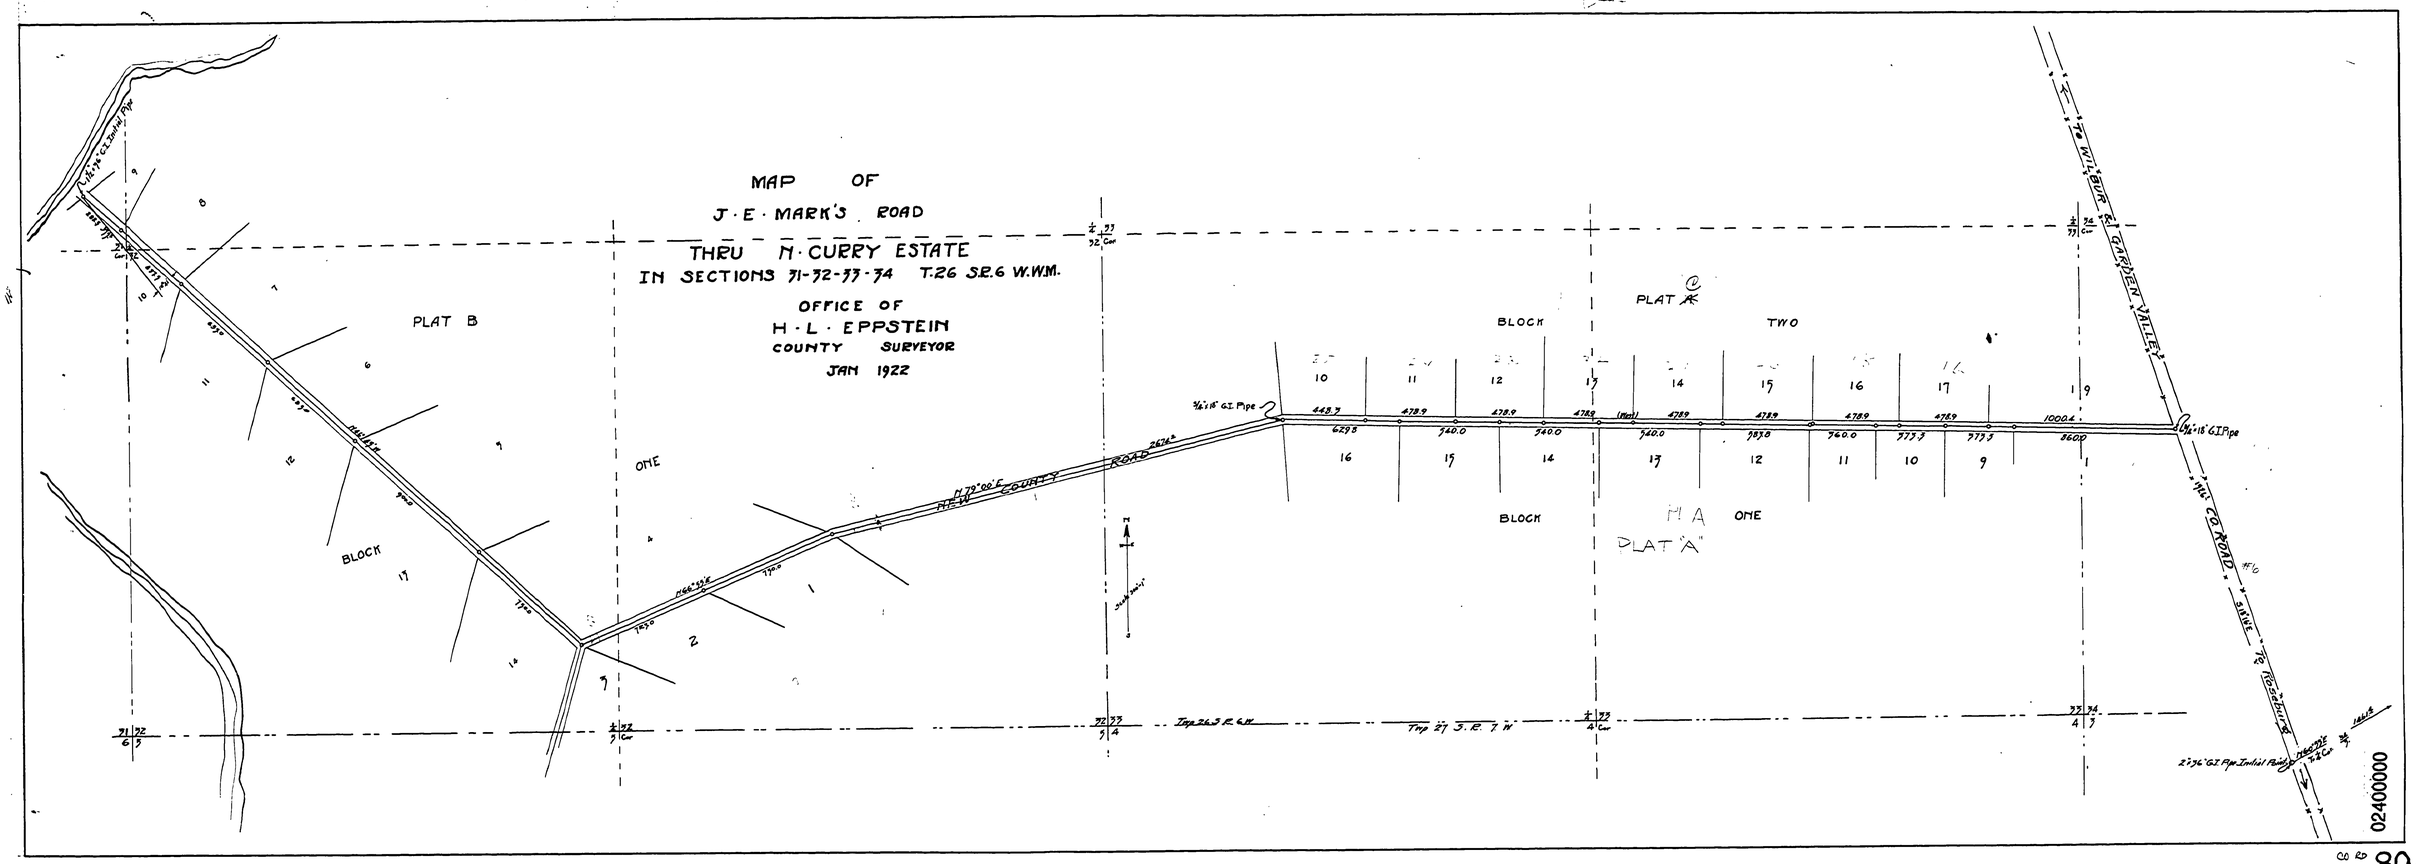

CO RD 80 (14)

~M.P. 2.40 – 0.00

T26-6 S. 31, 32, 33, 34 JAN 1922

30 X