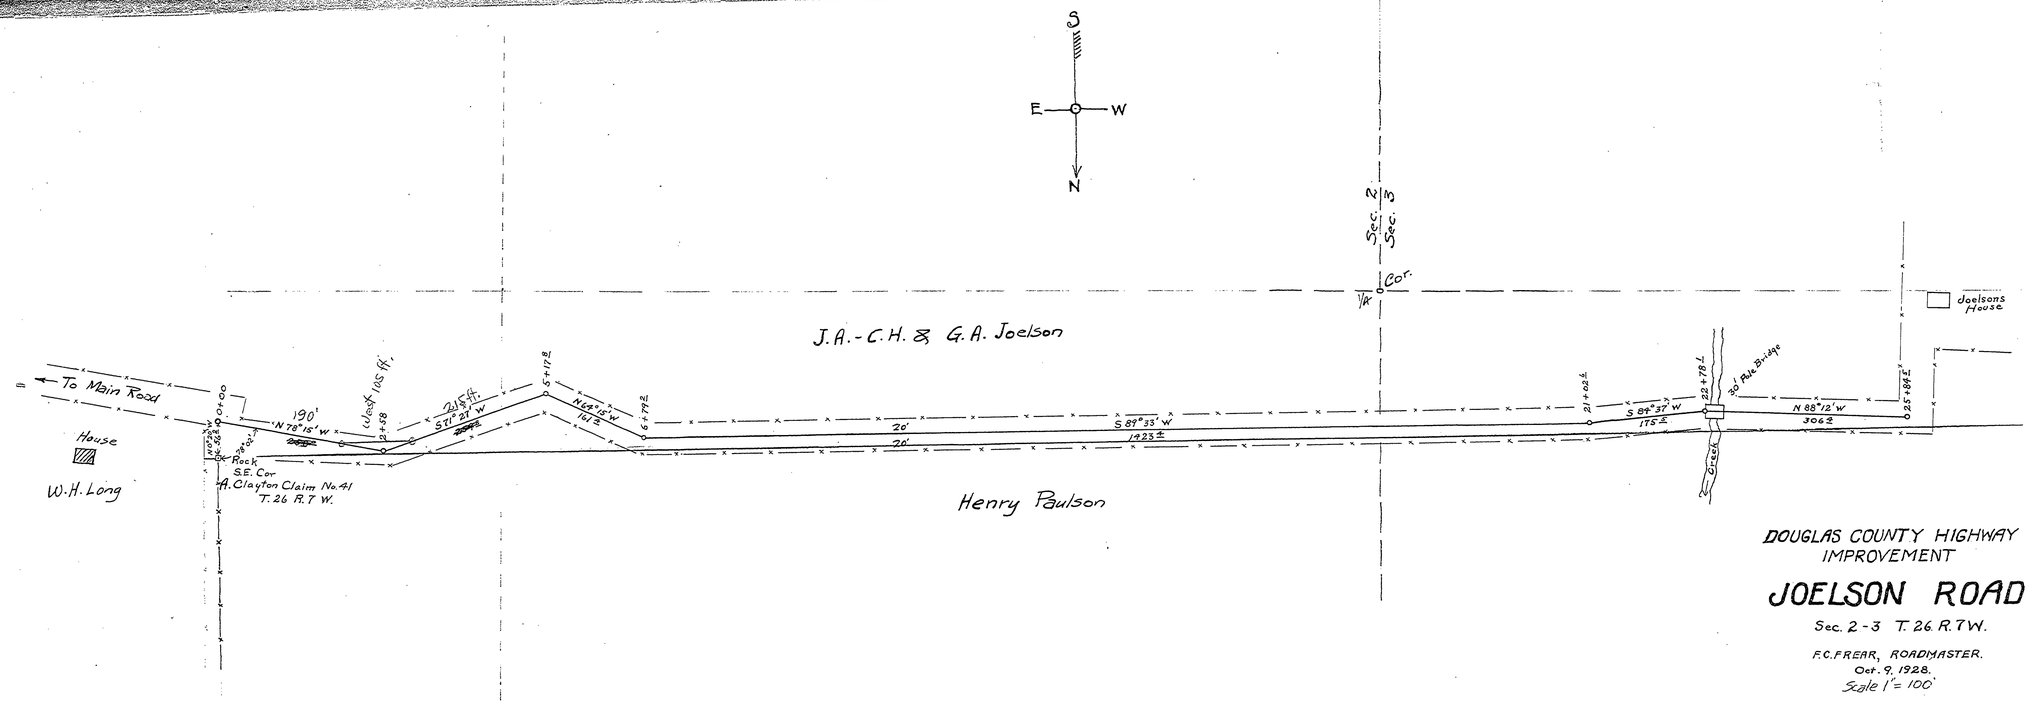

DOUGLAS COUNTY HIGHWAY IMPROVEMENT

JOELSON ROAD

Sec. 2-3 T. 26 R. 7 W.

F.C. FREAR, ROADMASTER.
Oct. 9. 1928.
Scale 1" = 100'

81

00220071

C-81

~ M.P. 0.22 - 0.71

T.26-7 SEC. 2-3 Oct. 1928