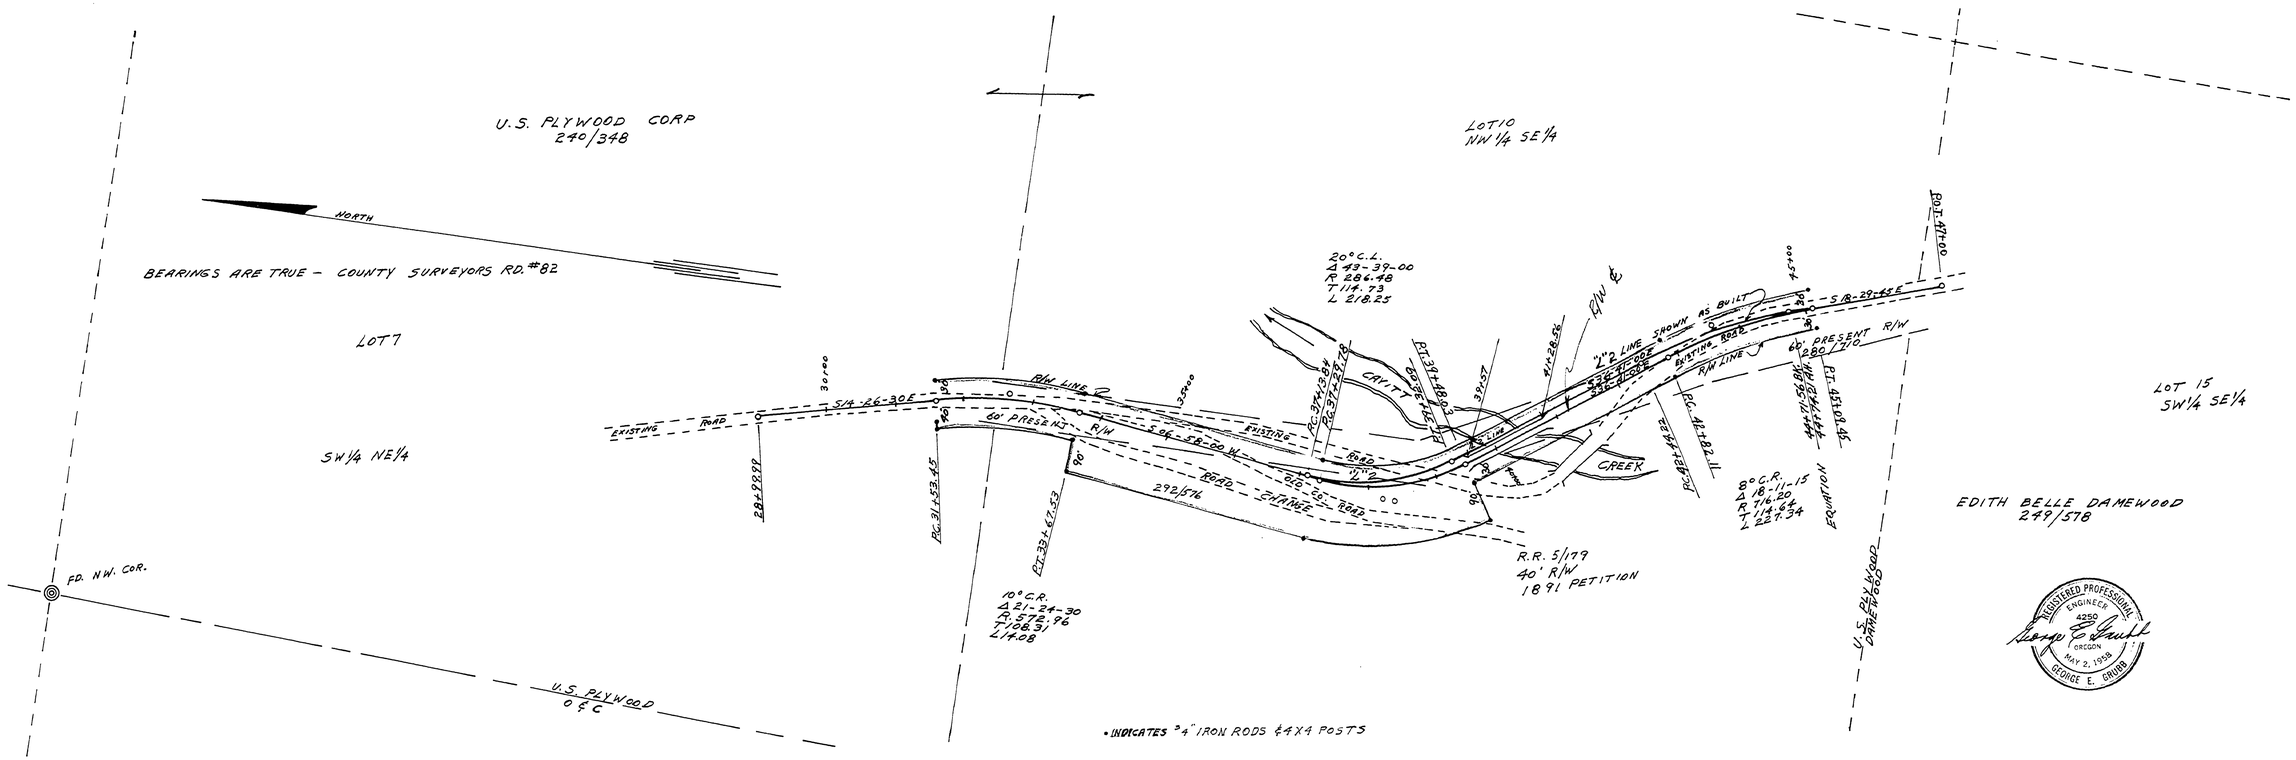

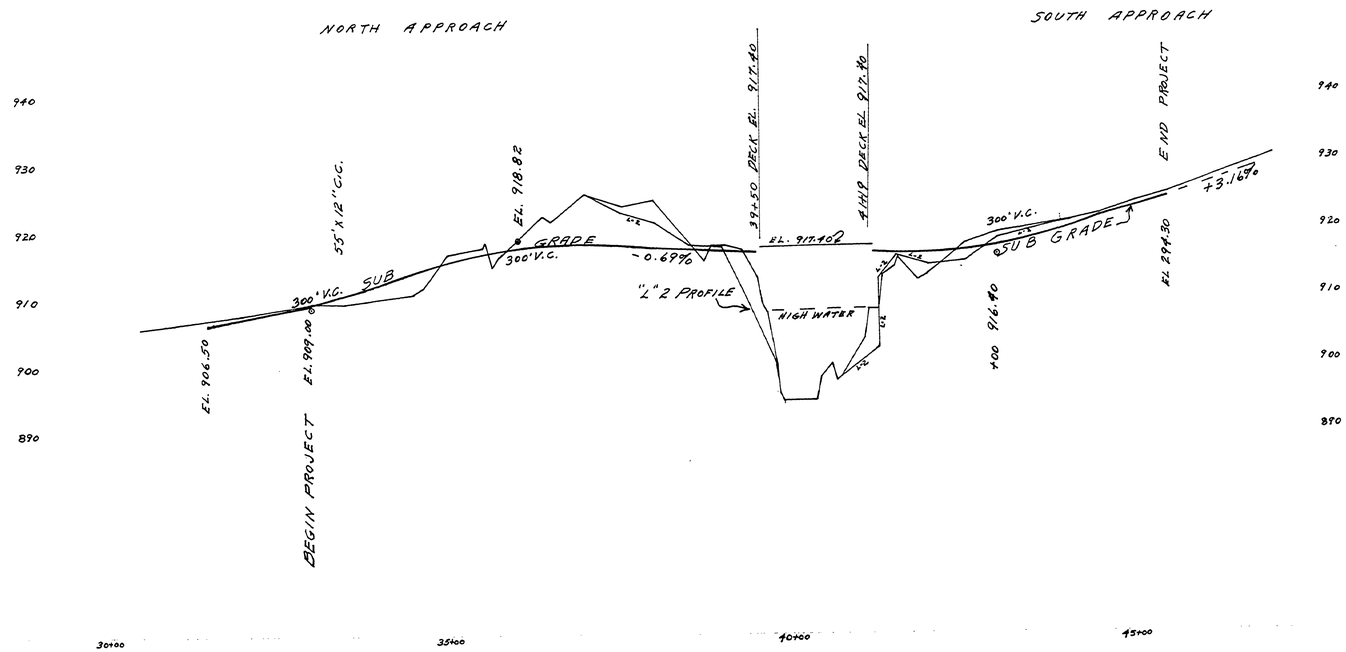

DOUGLAS COUNTY OREGON

CAVITT CREEK BRIDGE NO. 82-1-85

TWP. 27 S NOV. 1958

RNG. 3 W

SEC. 11

SCALES

PROFILE MAP. 1" = 100'

HOR. 1" = 100'

VERT. 1" = 10'

A.H. MAY COUNTY ENGINEER

00690095

FILED
RECEIVED
COUNTY SURVEYOR
DOUGLAS COUNTY, ORE.

M.P. 0.69 - 0.95

Co Rd. #82

Nov. '58

31