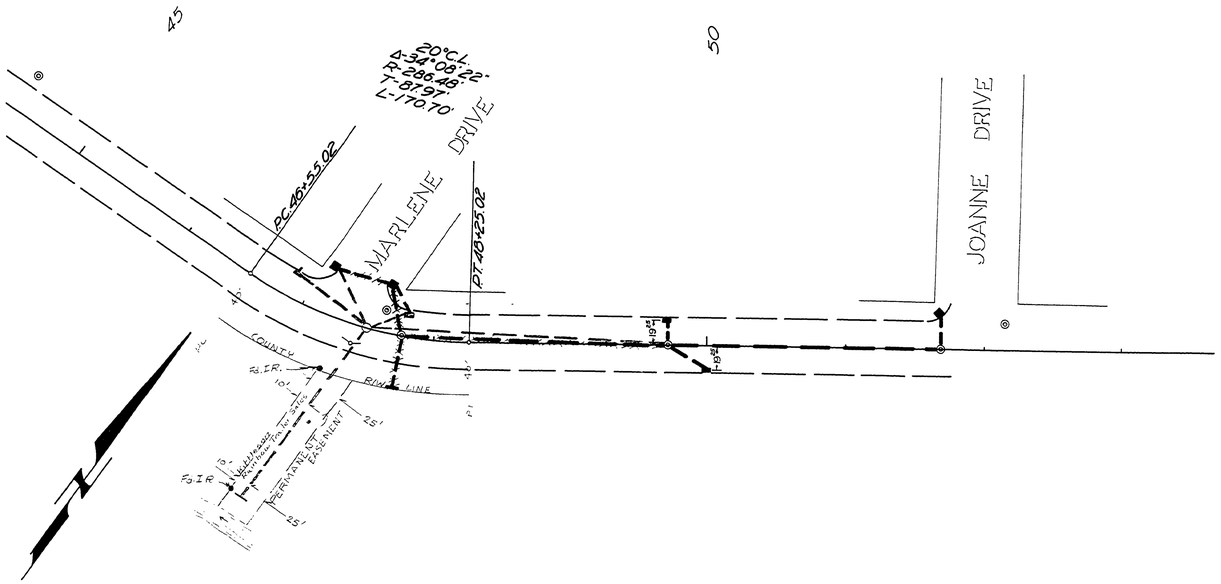


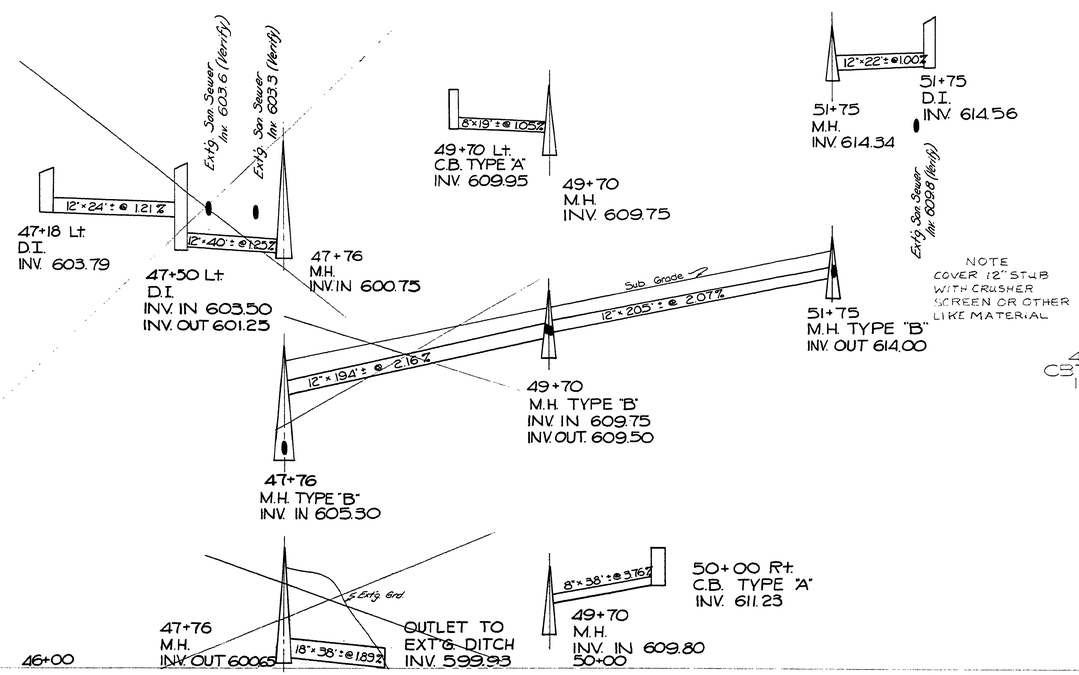


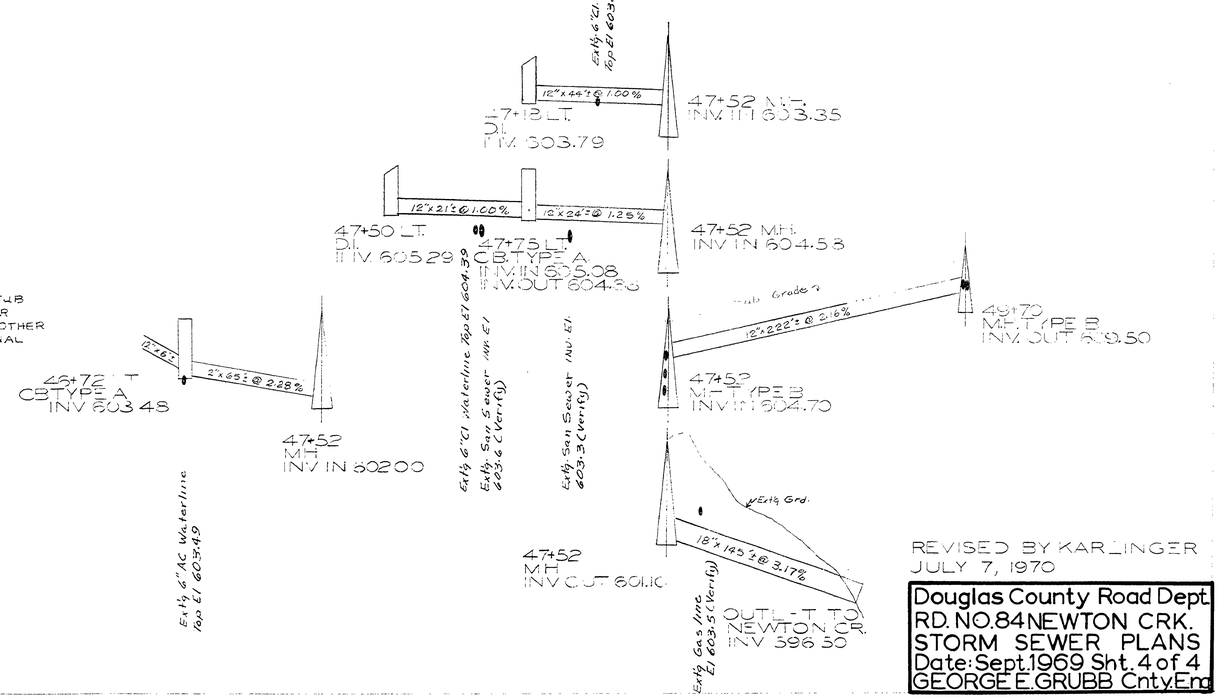


REVISED BY KARLINGER
JULY 7, 1970

**Douglas County Road Dept.**
**RD. NO. 84 NEWTON CRK.**
**STORM SEWER PLANS**
**Date: Sept. 1969 Sht. 4 of 4**
**GEORGE E. GRUBB Cnty. Eng**

00730087

M.P. 0.73 - 0.86

Co. Rd #84 Sept 69 Sht. 4 of 4