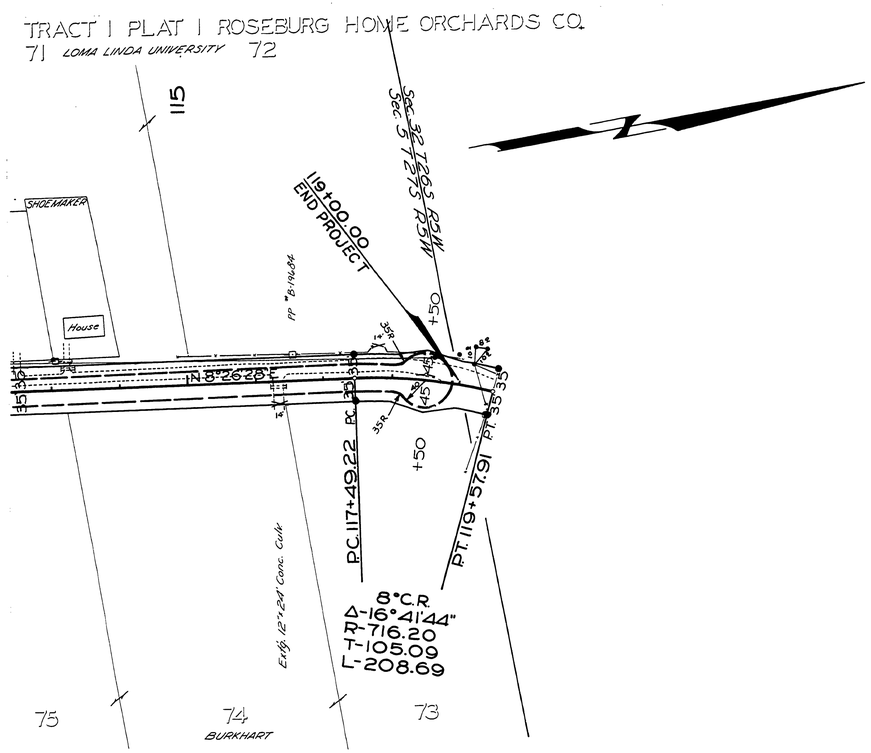

● INDICATES 5/8" IRON R/W PIN

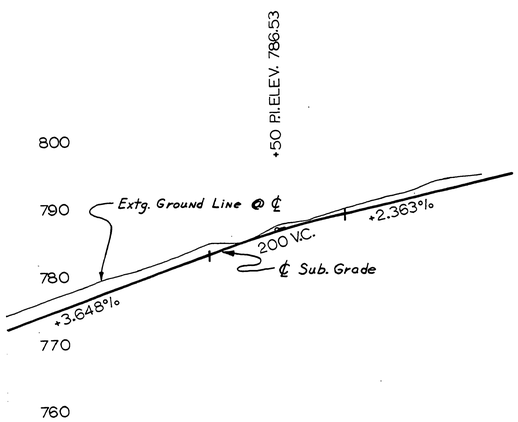

NOT REVISED
AS CONSTRUCTED

02070215

DOUGLAS COUNTY ROAD DEPT.
NEWTON CREEK ROAD #84
1972 SHT. 4
GEORGE E. GRUBB COUNTY ENGR.

M.P. 2.07-2.15

1972
C. Rd. # 84 sht. 4

59