Copy

87

Map of the Townsite of
WINCHESTER BAY
DOUGLAS COUNTY
OREGON.
T. 22-12.
Scale-200 ft. to inch.

Vol. 94-56
Doug. Co.
TIDE LANDS
SEC. 7 & 12
T. 22-12 & 13
LOT. 1 - SEC. 30 - T. 22-12

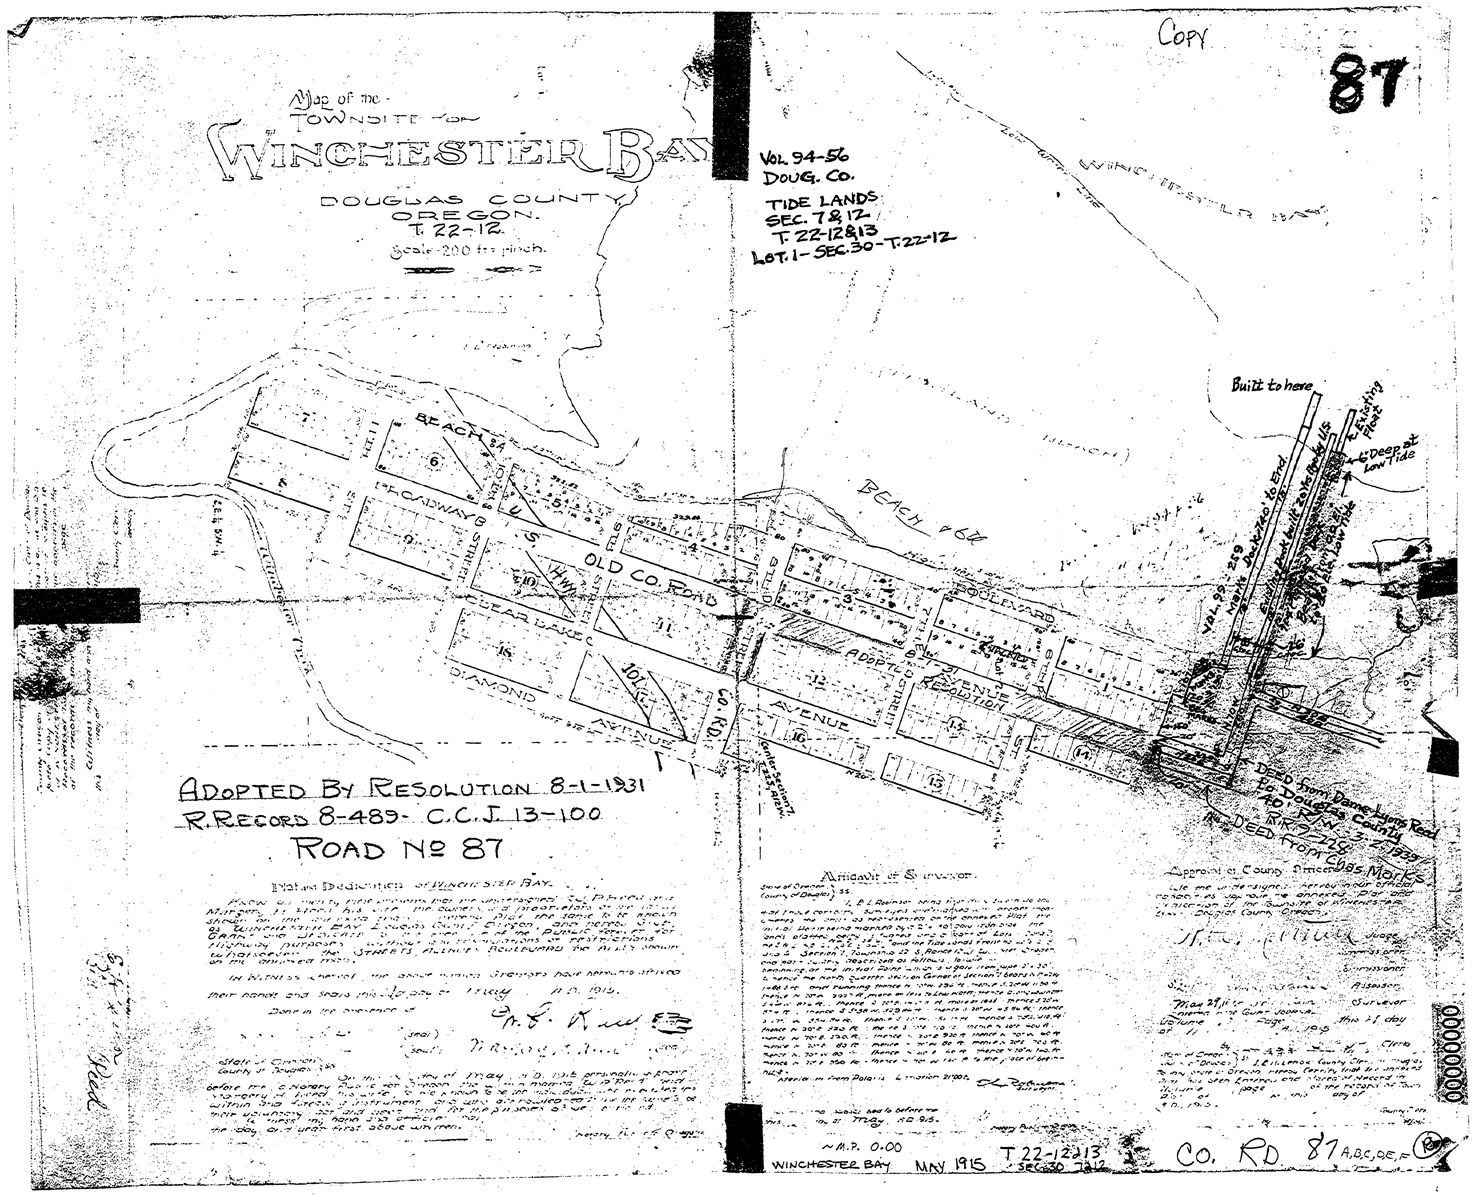

ADOPTED BY RESOLUTION 8-1-1931
R. RECORD 8-489 - C.C.J. 13-100

ROAD № 87

Plat and Dedication of WINCHESTER BAY

Affidavit of Surveyor

Approval of County Officers

M.P. 0.00 T 22-12 & 13
WINCHESTER BAY MAY 1915 SEC. 30 T. 22-12

CO. RD 87 A, B, C, D, E, F