SEC. 3 T29S R6W W.M.

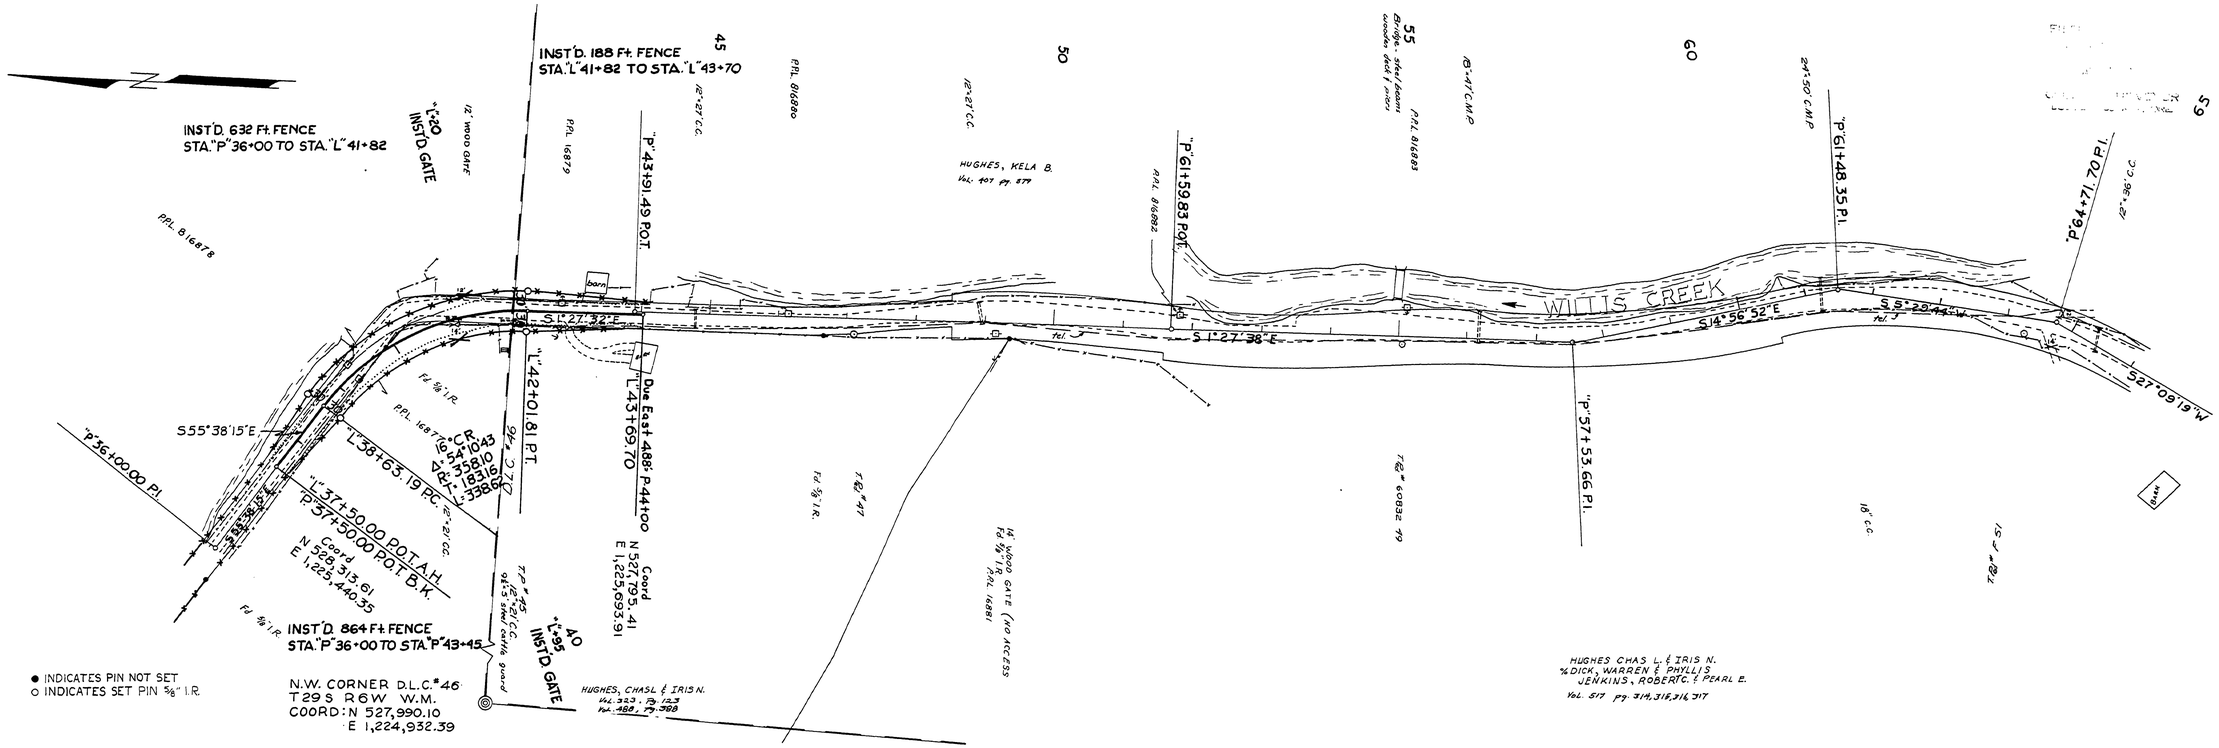

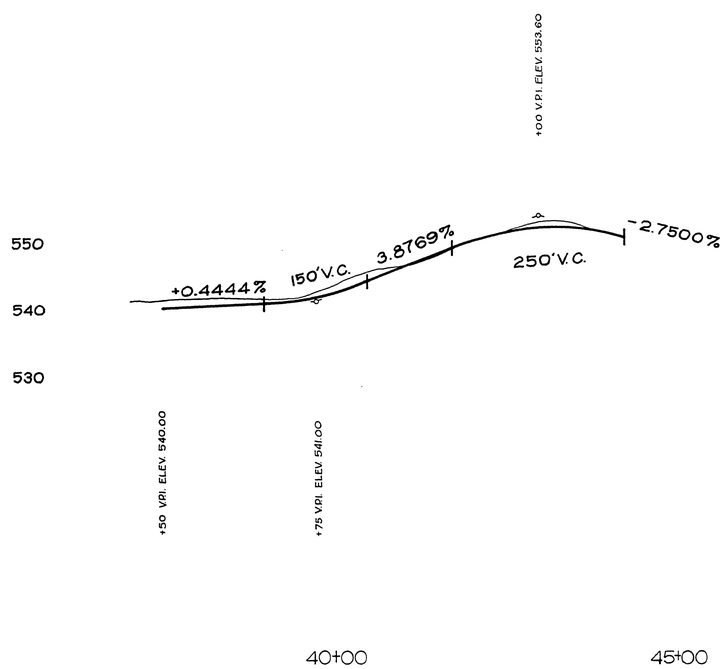

M.P. 0.68 - 1.23

00680123

DOUGLAS COUNTY ROAD DEPT.
WILLIS CREEK ROAD NO. 88
1973 SHT. 2
GEORGE E. GRUBB CNTY. ENGR.

1973
Co. Rd. #88 sht. 2 (65)