RD. 88 SHT. 4

SEC. 9, 10 & 15 T 29S R 6W W.M.

FILED
RECEIVED
... SURVEYOR
... PAGE

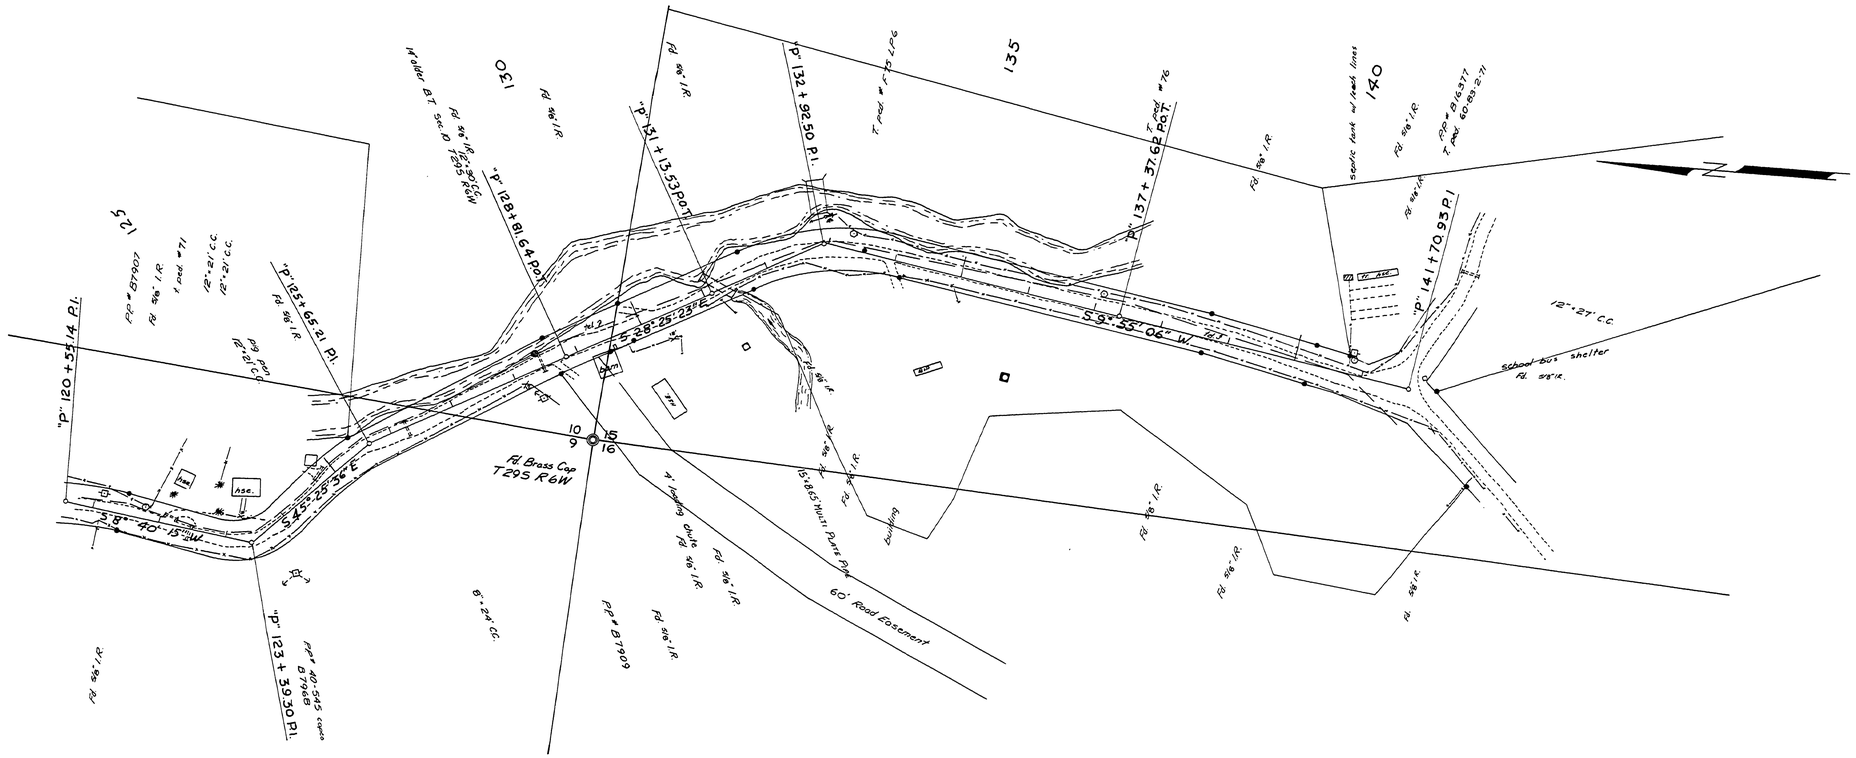

02290268

AS BUILT 7/49

DOUGLAS COUNTY ROAD DEPT.
WILLIS CREEK ROAD NO. 88
1973 SHT 5
GEORGE E. GRUBB CNTY. ENGR.

1973
Co. Rd. 88 sht. 5 (68)

M.P. 2.29 - 2.68