SEC 9 T25S R6W W.M.

MP 2

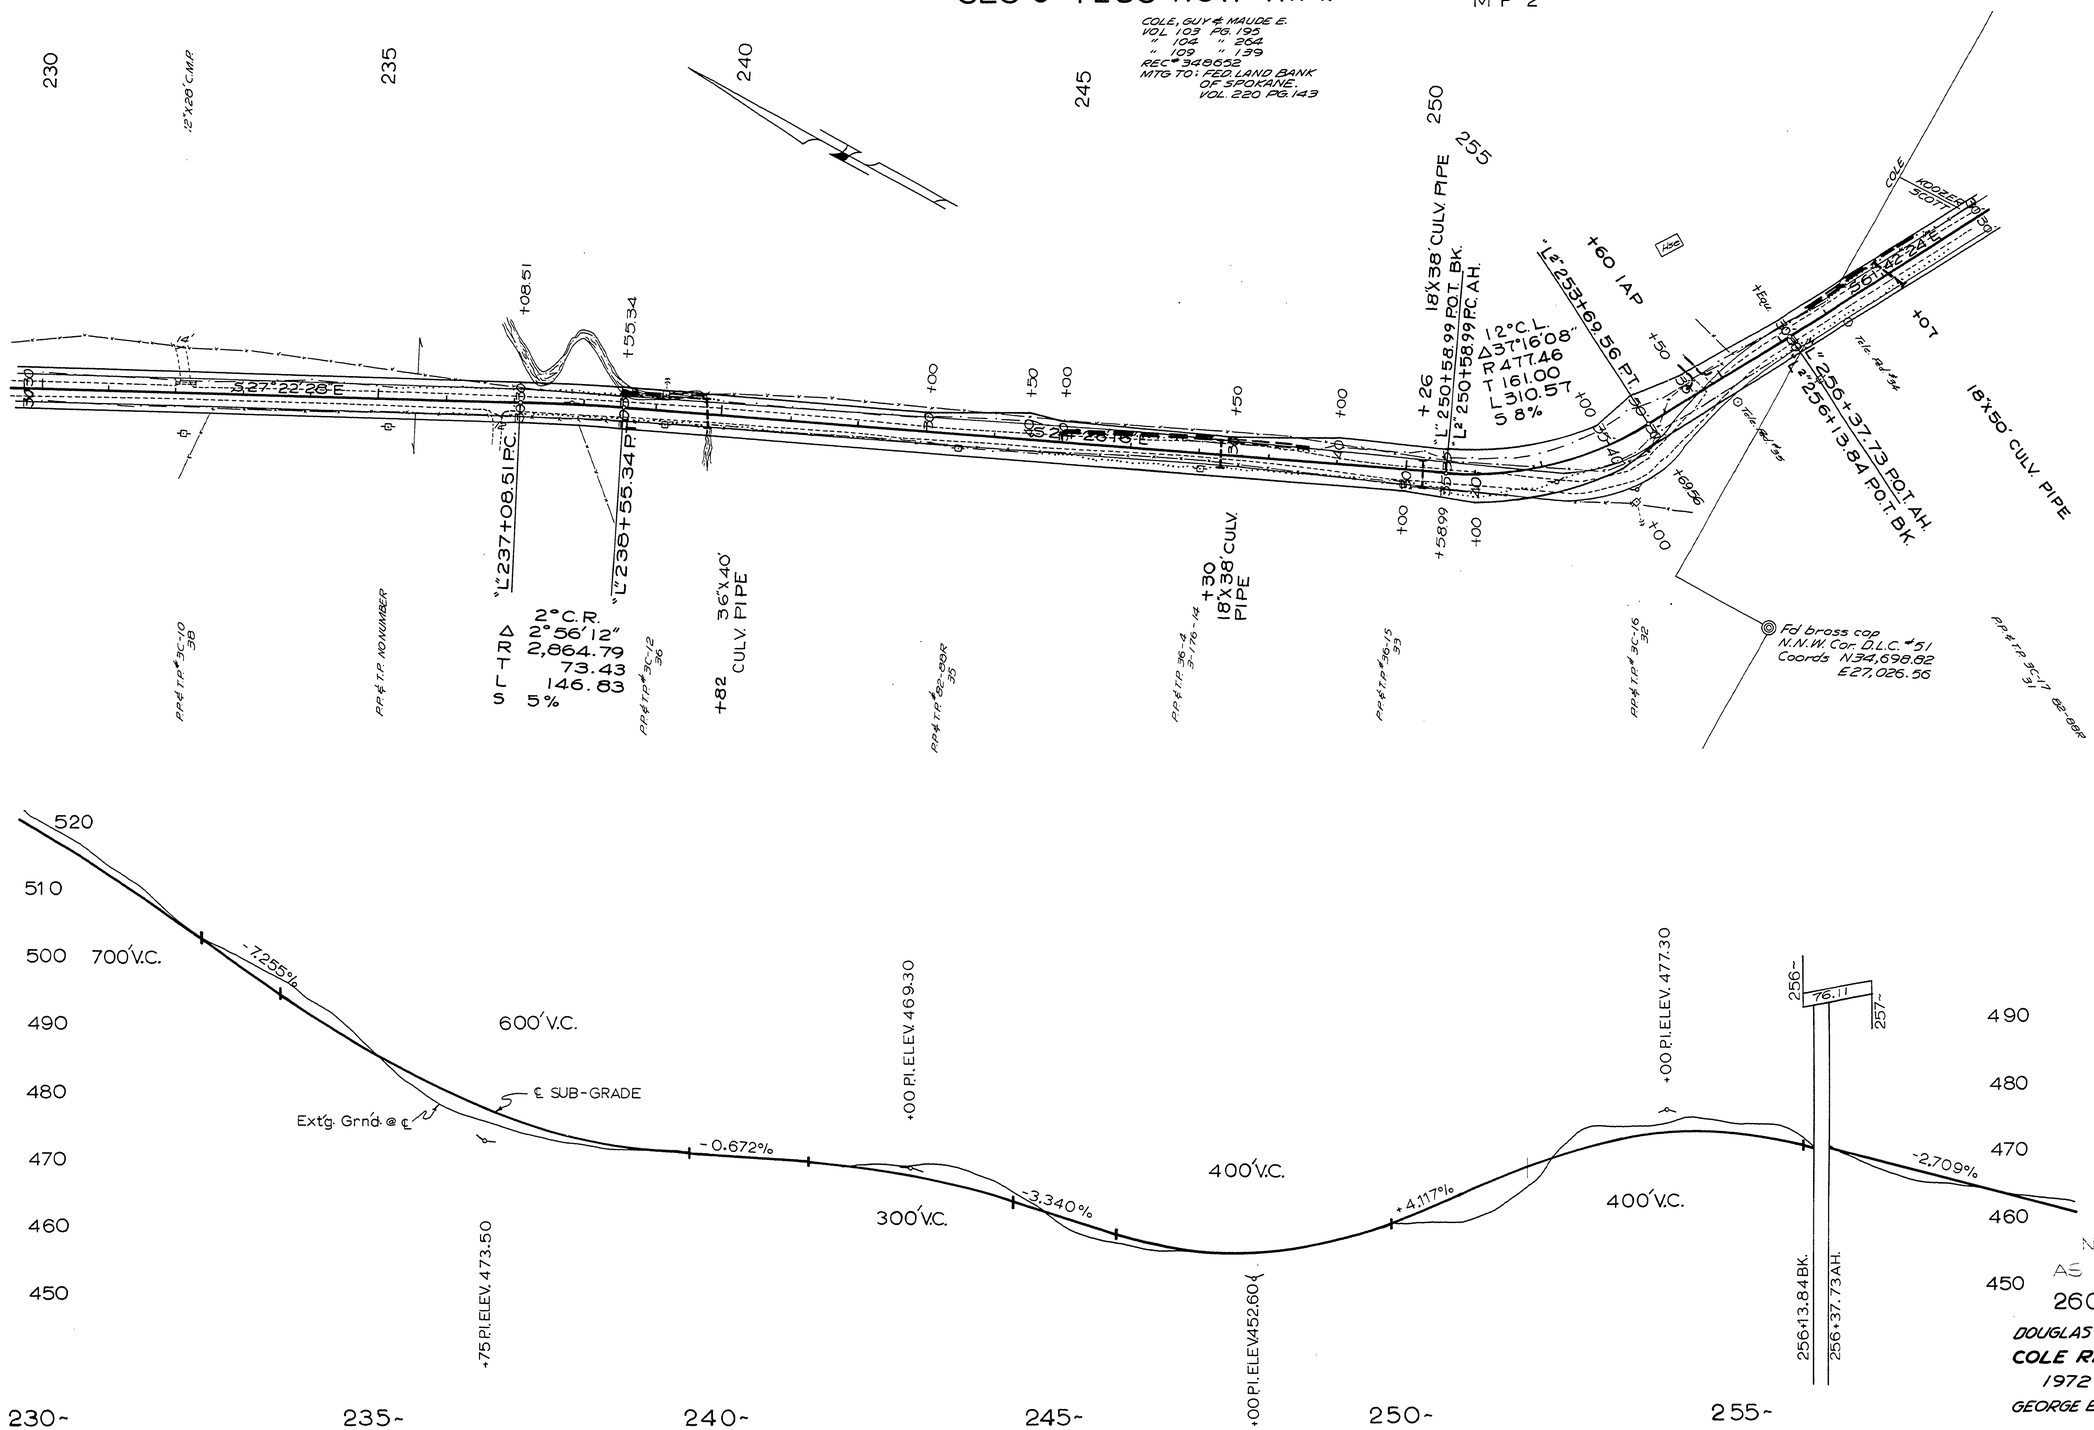

02420187