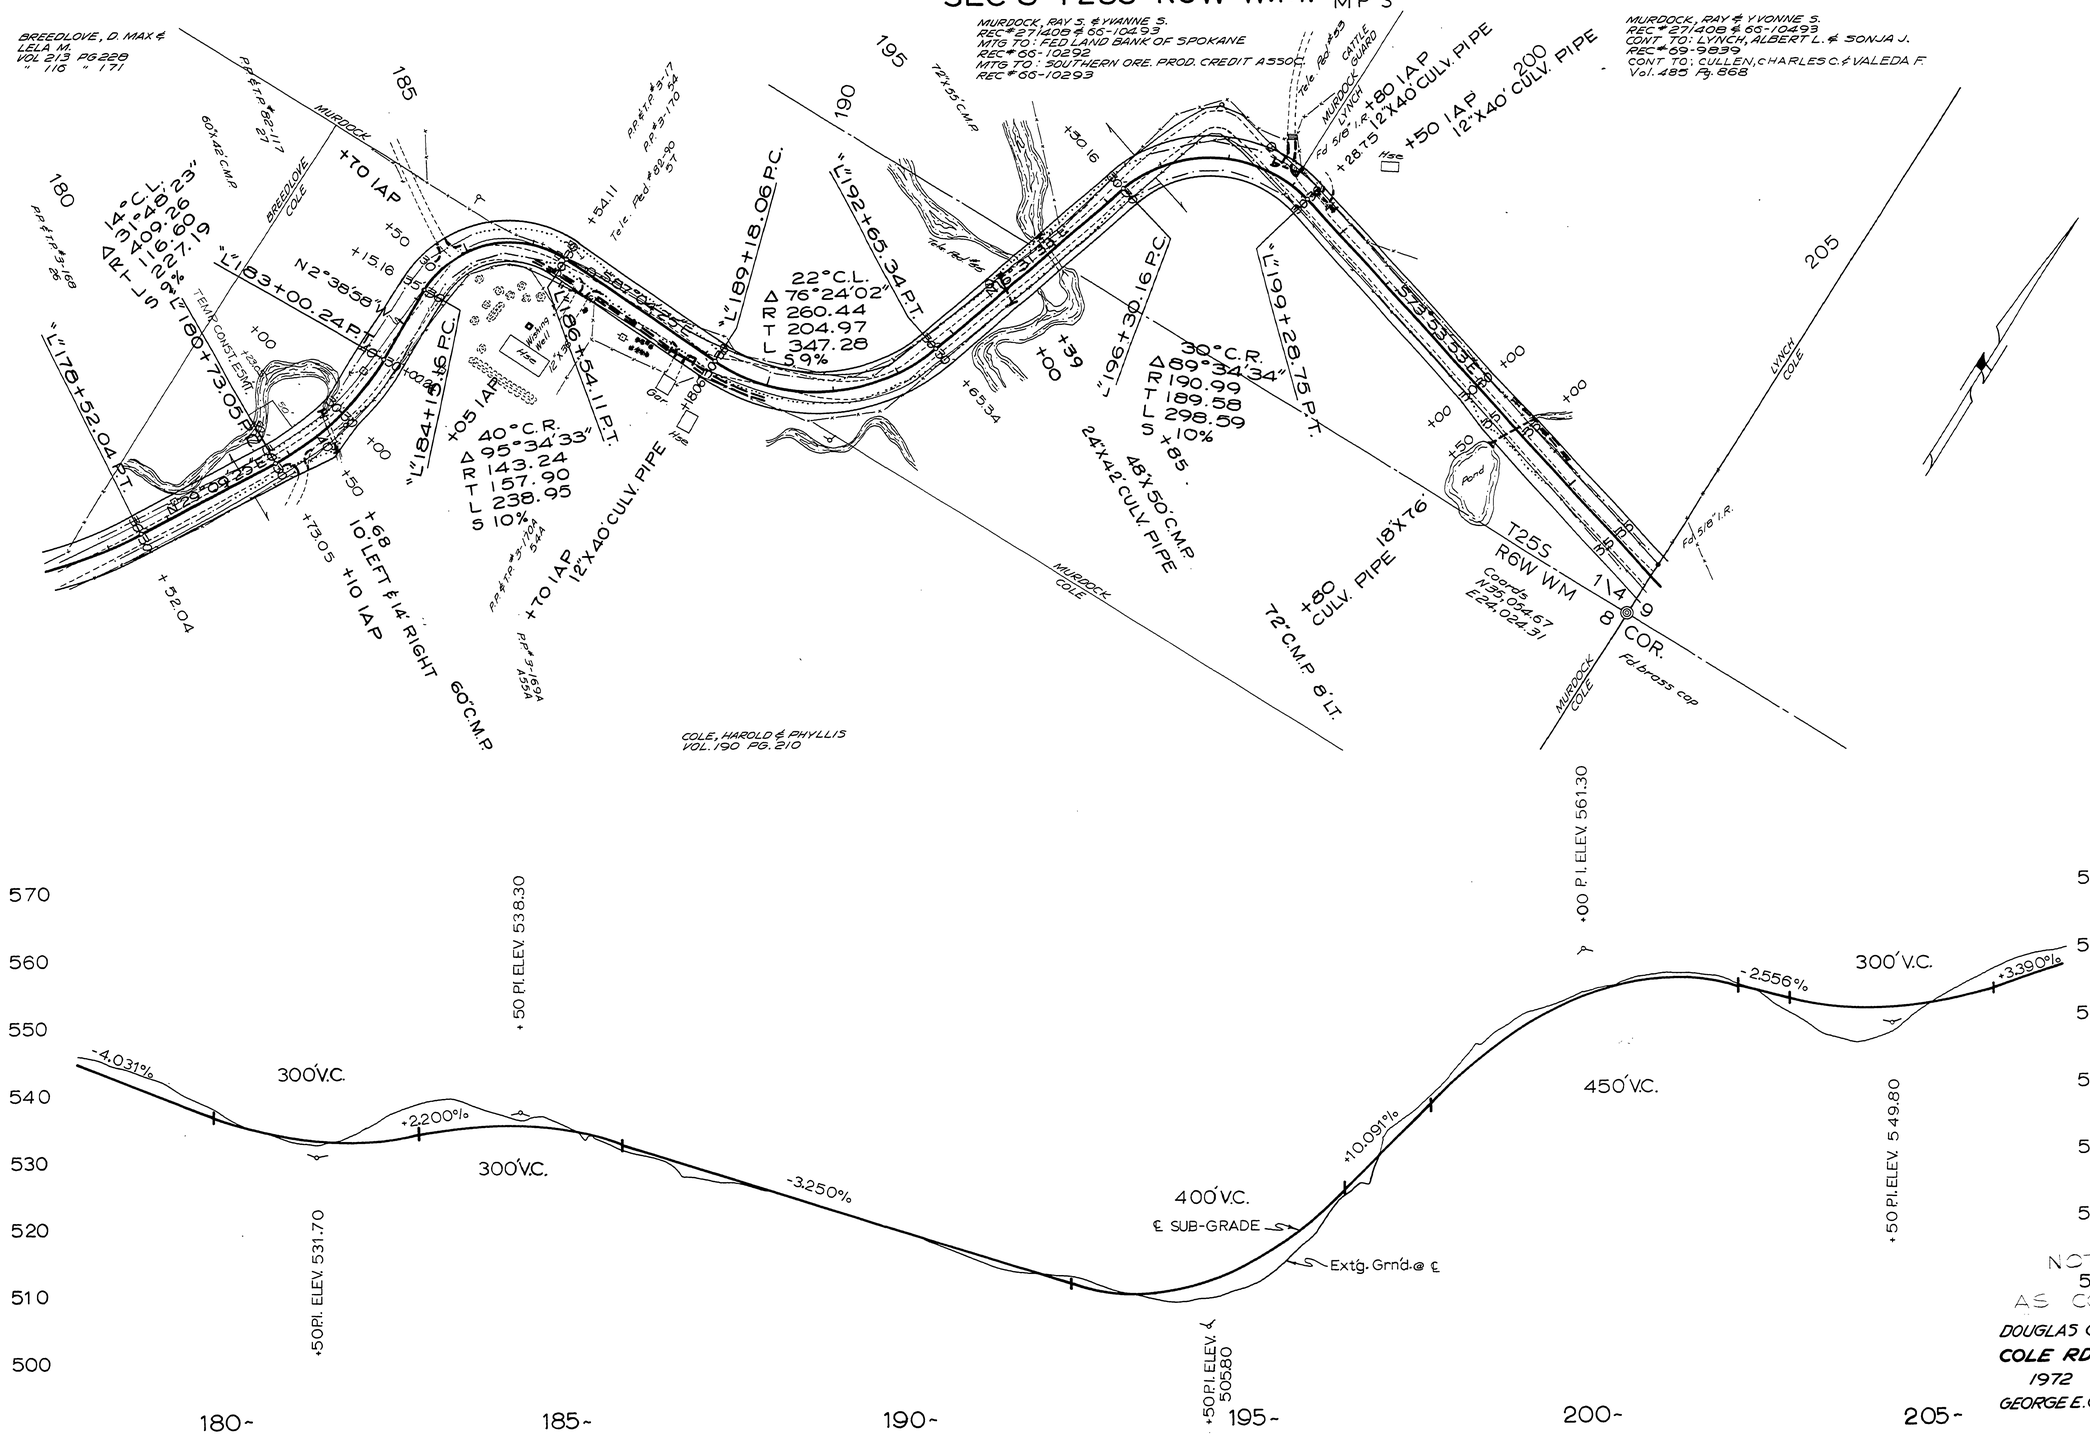# SEC 8 T25S R6W W.M. MP 3