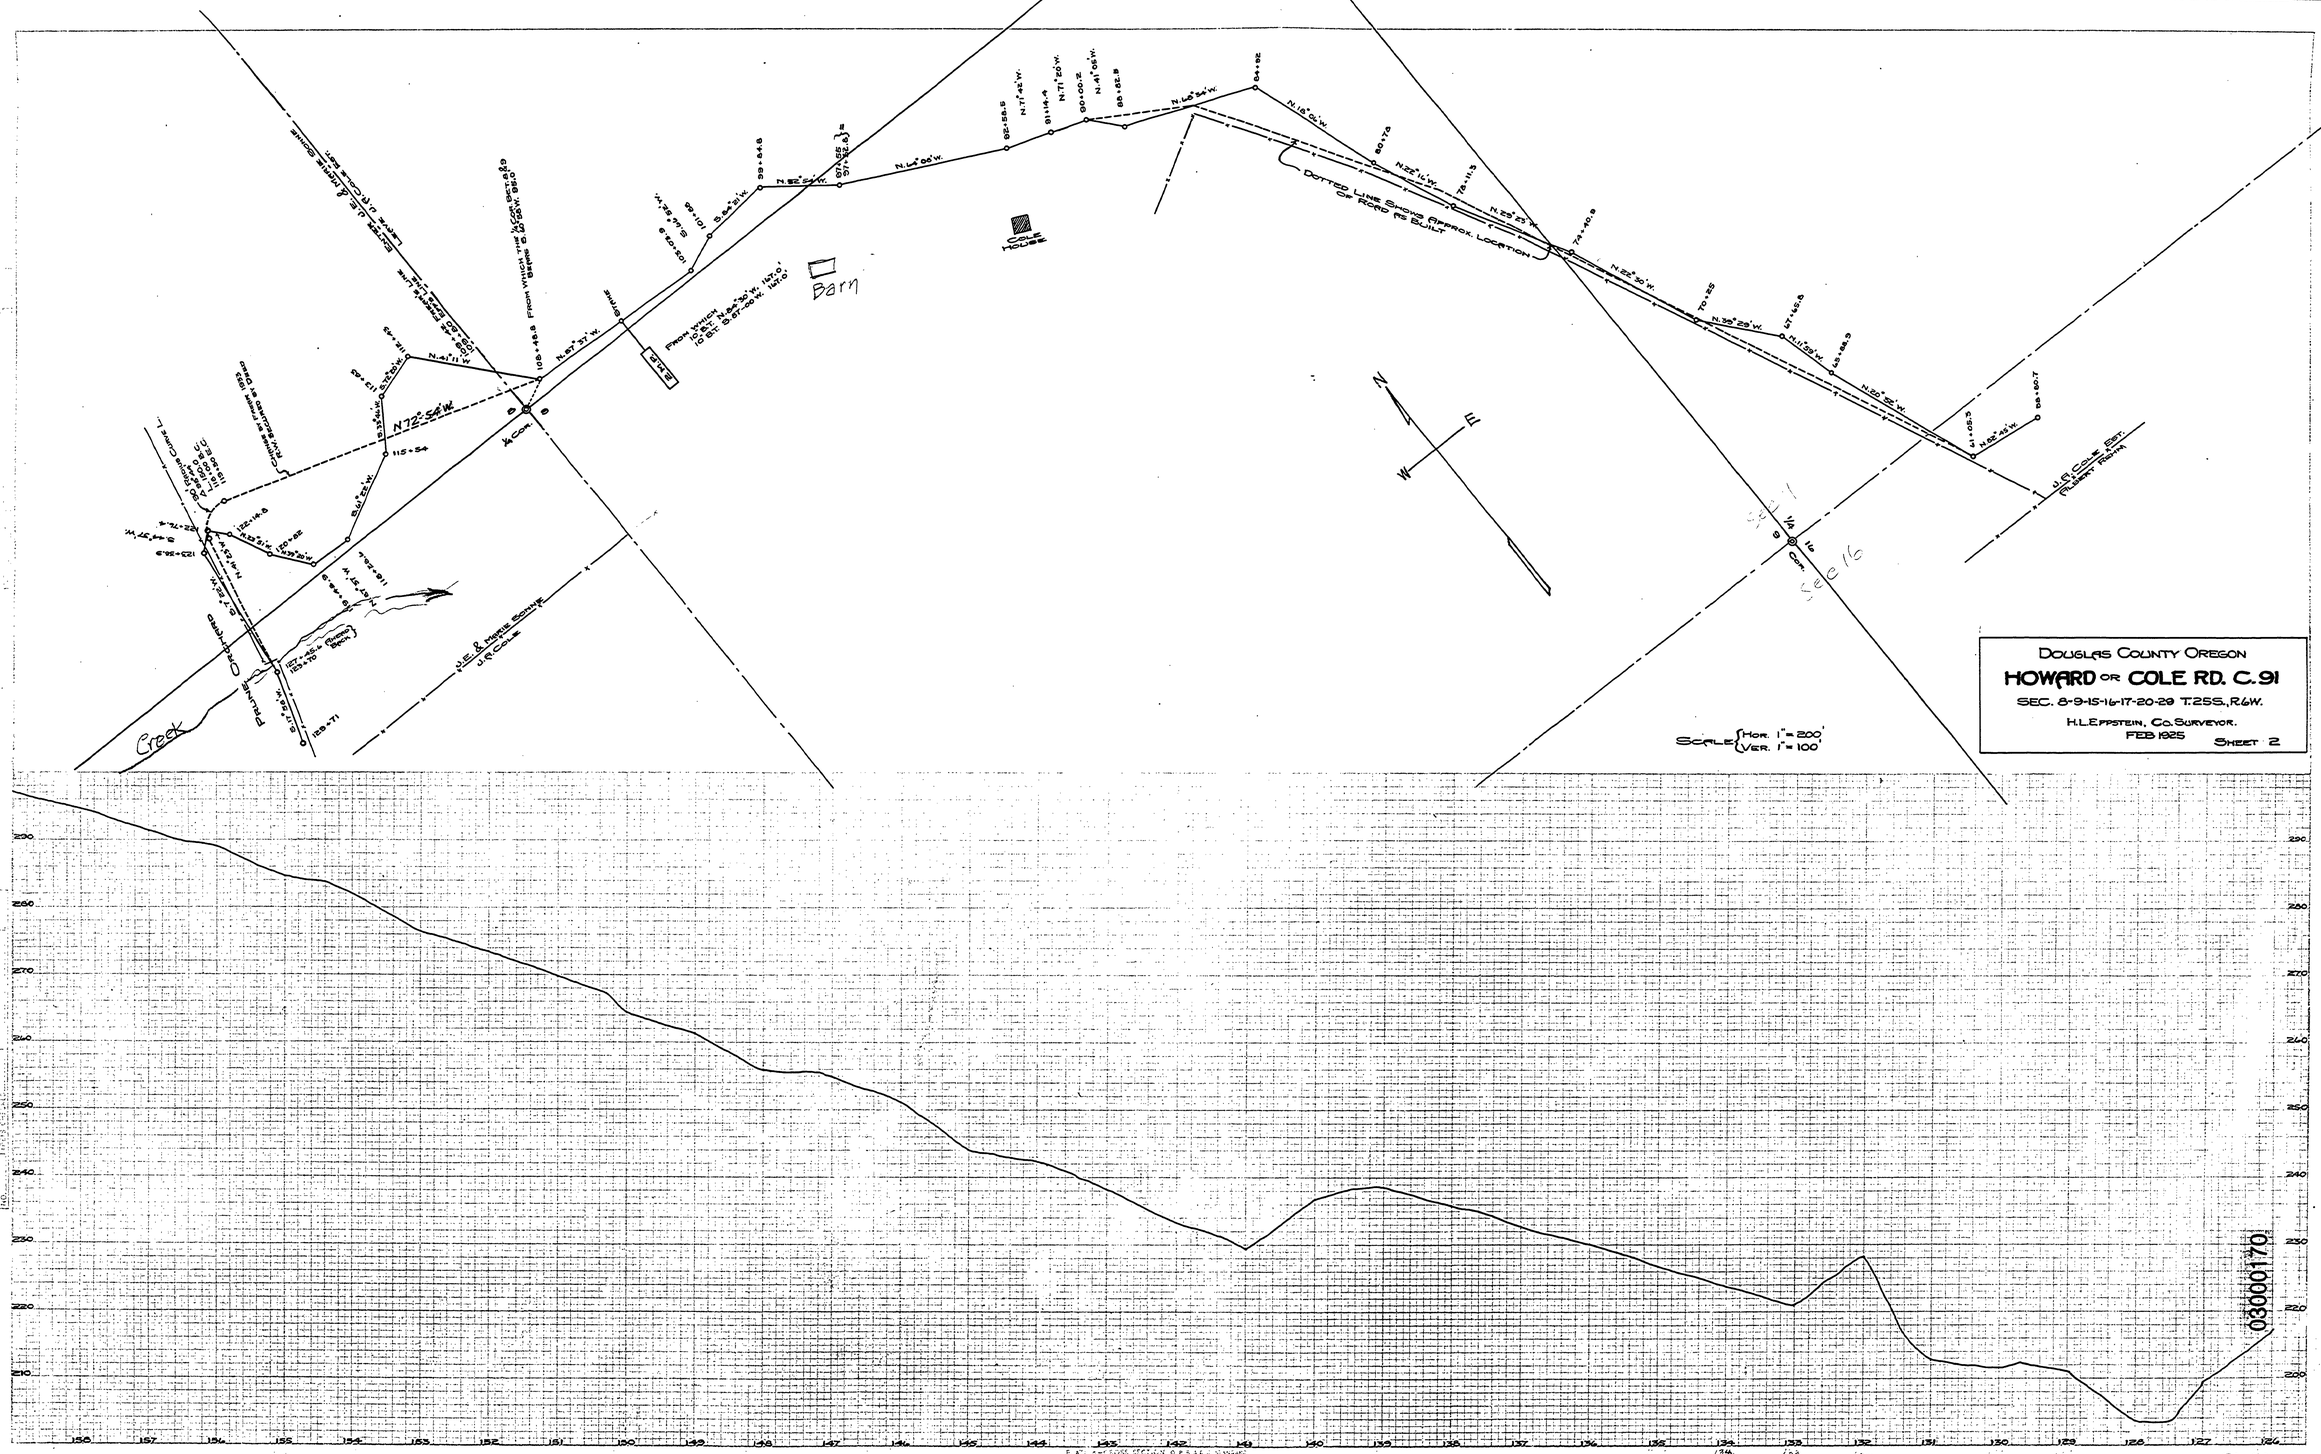
DOUGLAS COUNTY OREGON
HOWARD OR COLE RD. C.91
SEC. 8-9-15-16-17-20-29 T.25S., R.6W.
H.L. EPPSTEIN, CO. SURVEYOR.
FEB 1925
SHEET 2
SCALE { HOR. 1" = 200' VER. 1" = 100'
DOTTED LINE SHOWS APPROX. LOCATION OF ROAD AS BUILT
COLE HOUSE
Barn
Creek
N 72° 54' W
J.E. & MARIE SCHIVE
J.R. COLE
J.R. COLE EST.
(ALBERT ROAD)
N
E
W
S
C.91
03000170