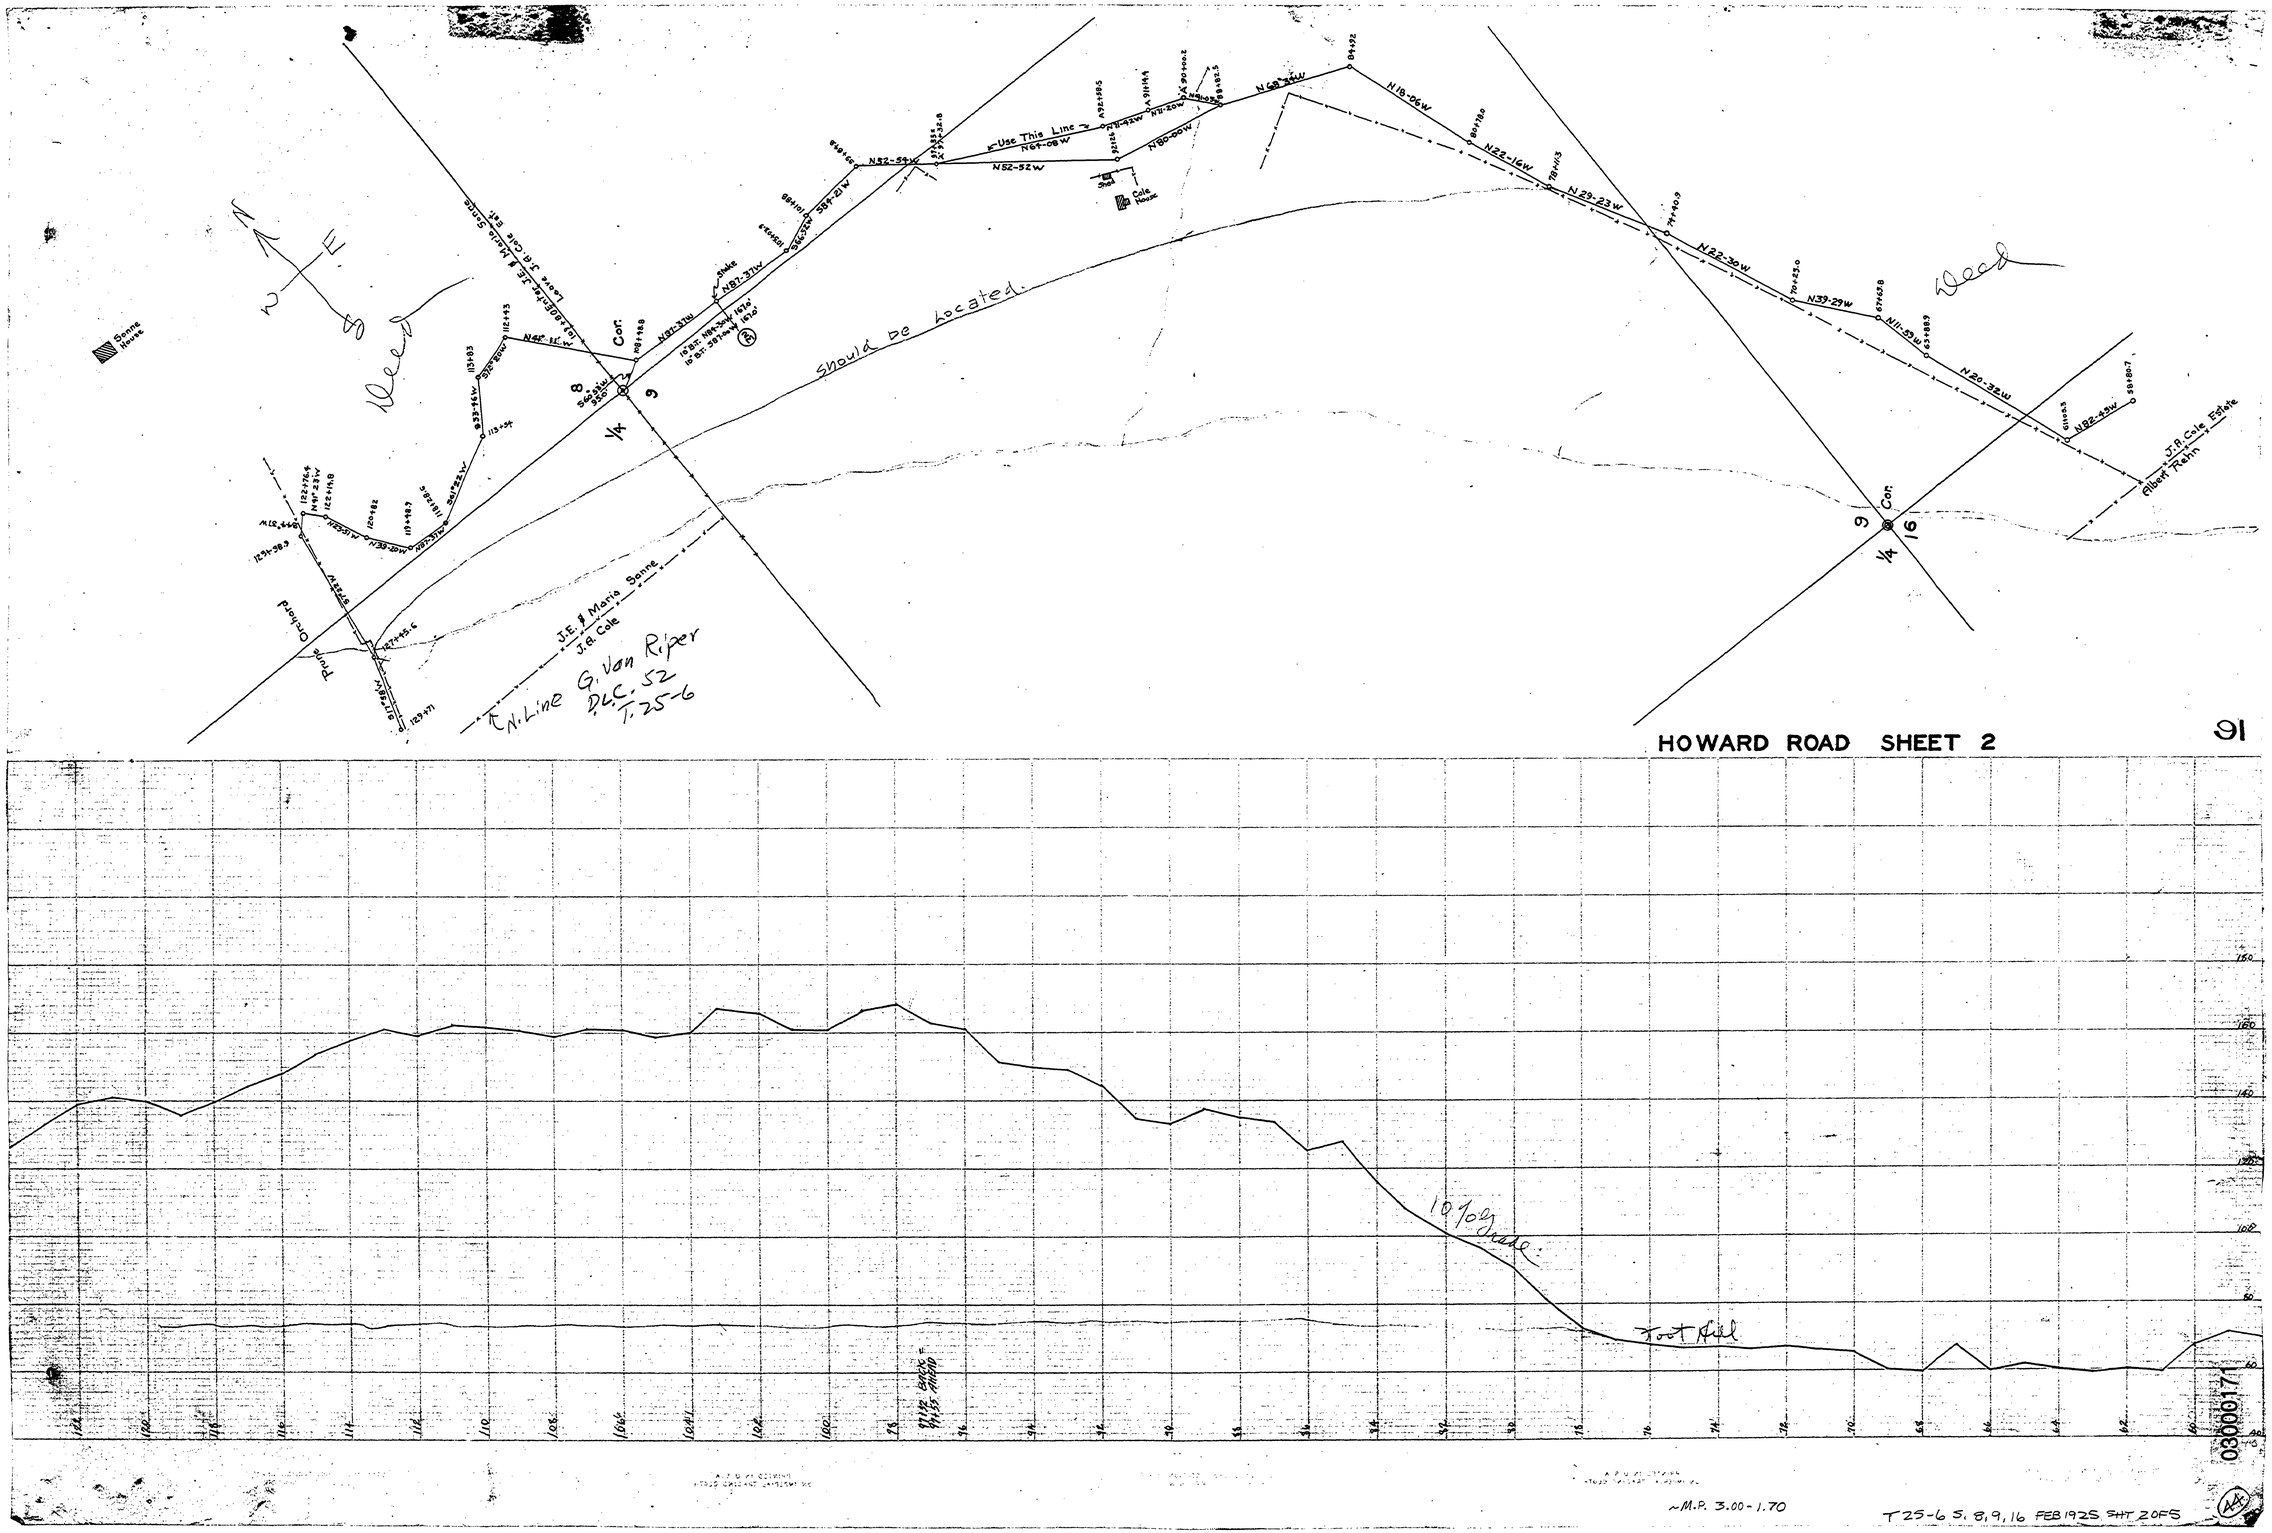
HOWARD ROAD SHEET 2
91
Seine House
Weed
Weed
Should be Located.
Use This Line
Cor.
Cor.
8
9
16
1/4
Stake
Cole House
J.E. & Maria Seine
J.R. Cole
G. Von Riper
N. Line
D.L.C. 52
T. 25-6
J.R. Cole Estate
Gilbert Rahn
10% Grade
Foot Hill
~M.P. 3.00-1.70
T25-6 S. 8, 9, 16 FEB 1925 SHT 2 OF 5
03000171