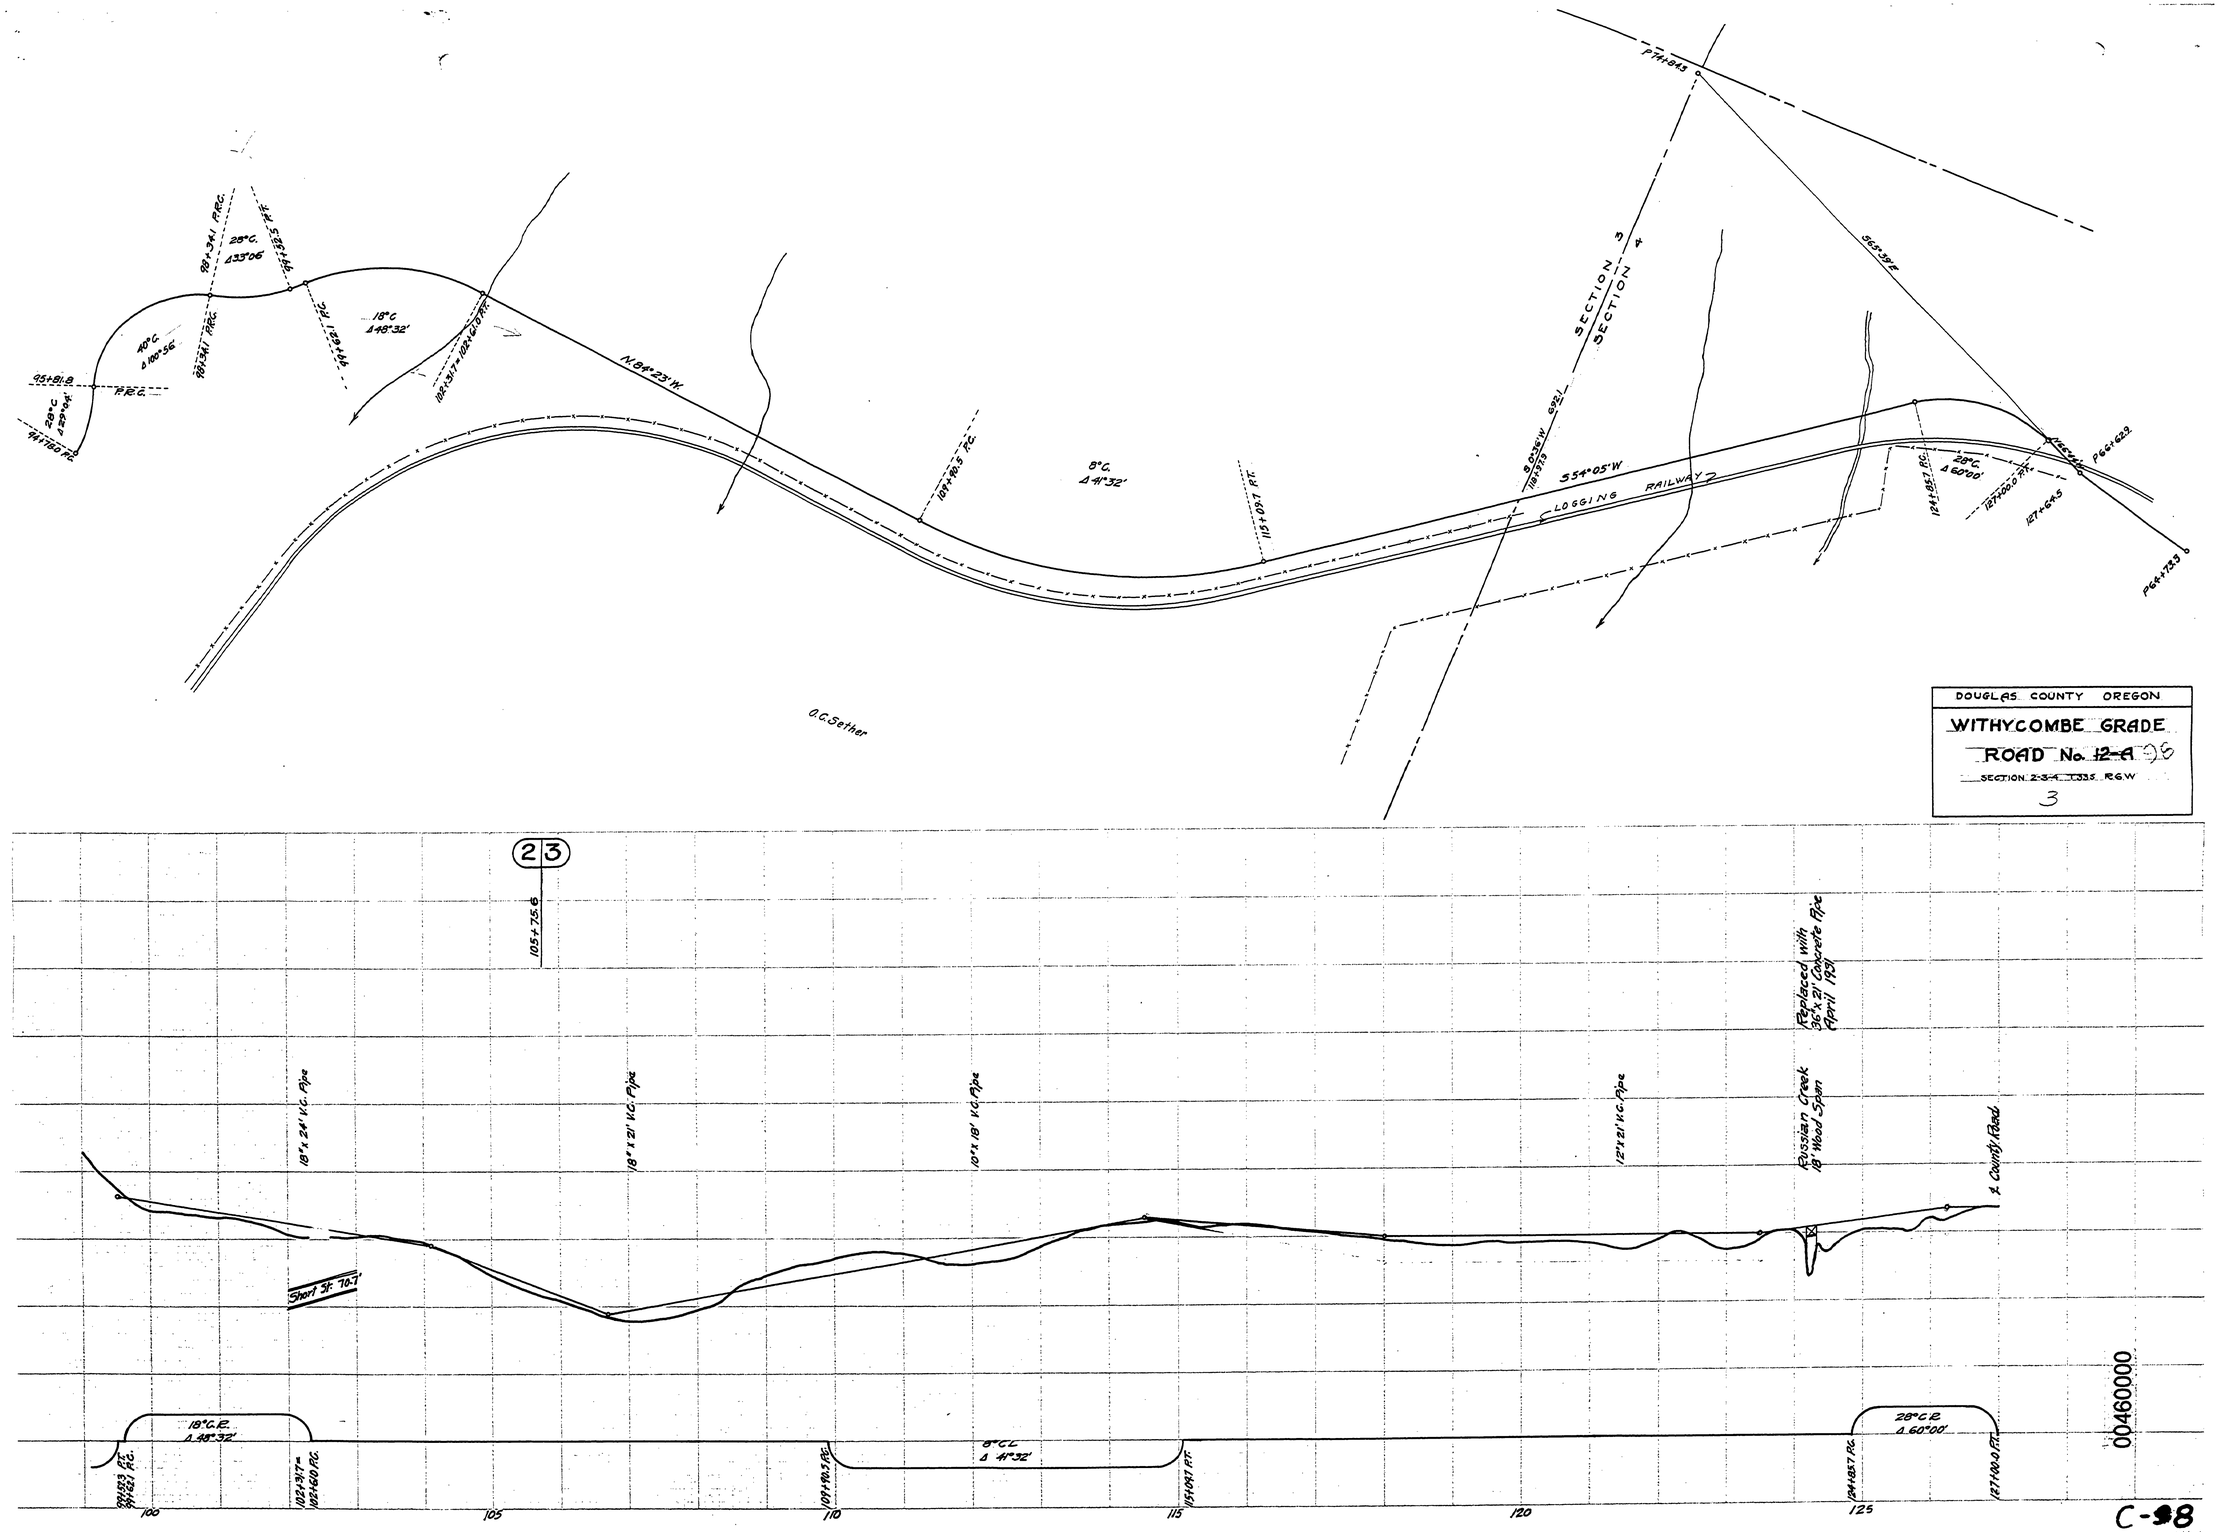
DOUGLAS COUNTY OREGON
WITHYCOMBE GRADE
SECTION 2-3-4 T33S R6W
3
N 84°23' W
S 54°05' W
LOGGING RAILWAY
SECTION 3
SECTION 4
S 63°39' E
28° C.
Δ 33°06'
40° C.
Δ 100°56'
18° C
Δ 48°32'
8° C.
Δ 41°32'
28° C.
Δ 60°00'
P.R.C.
P.T.
O.C. Sether
18" x 24' V.C. Pipe
18" x 21' V.C. Pipe
10" x 18' V.C. Pipe
12" x 21' V.C. Pipe
Russian Creek
18' Wood Span
Replaced with
℄ County Road
Short 3F 70.7'
105+75.6
18° C.R.
Δ 48°32'
8° C.C.
Δ 41°32'
28° C.R.
Δ 60°00'
100
105
110
115
120
125
00460000
C-98
