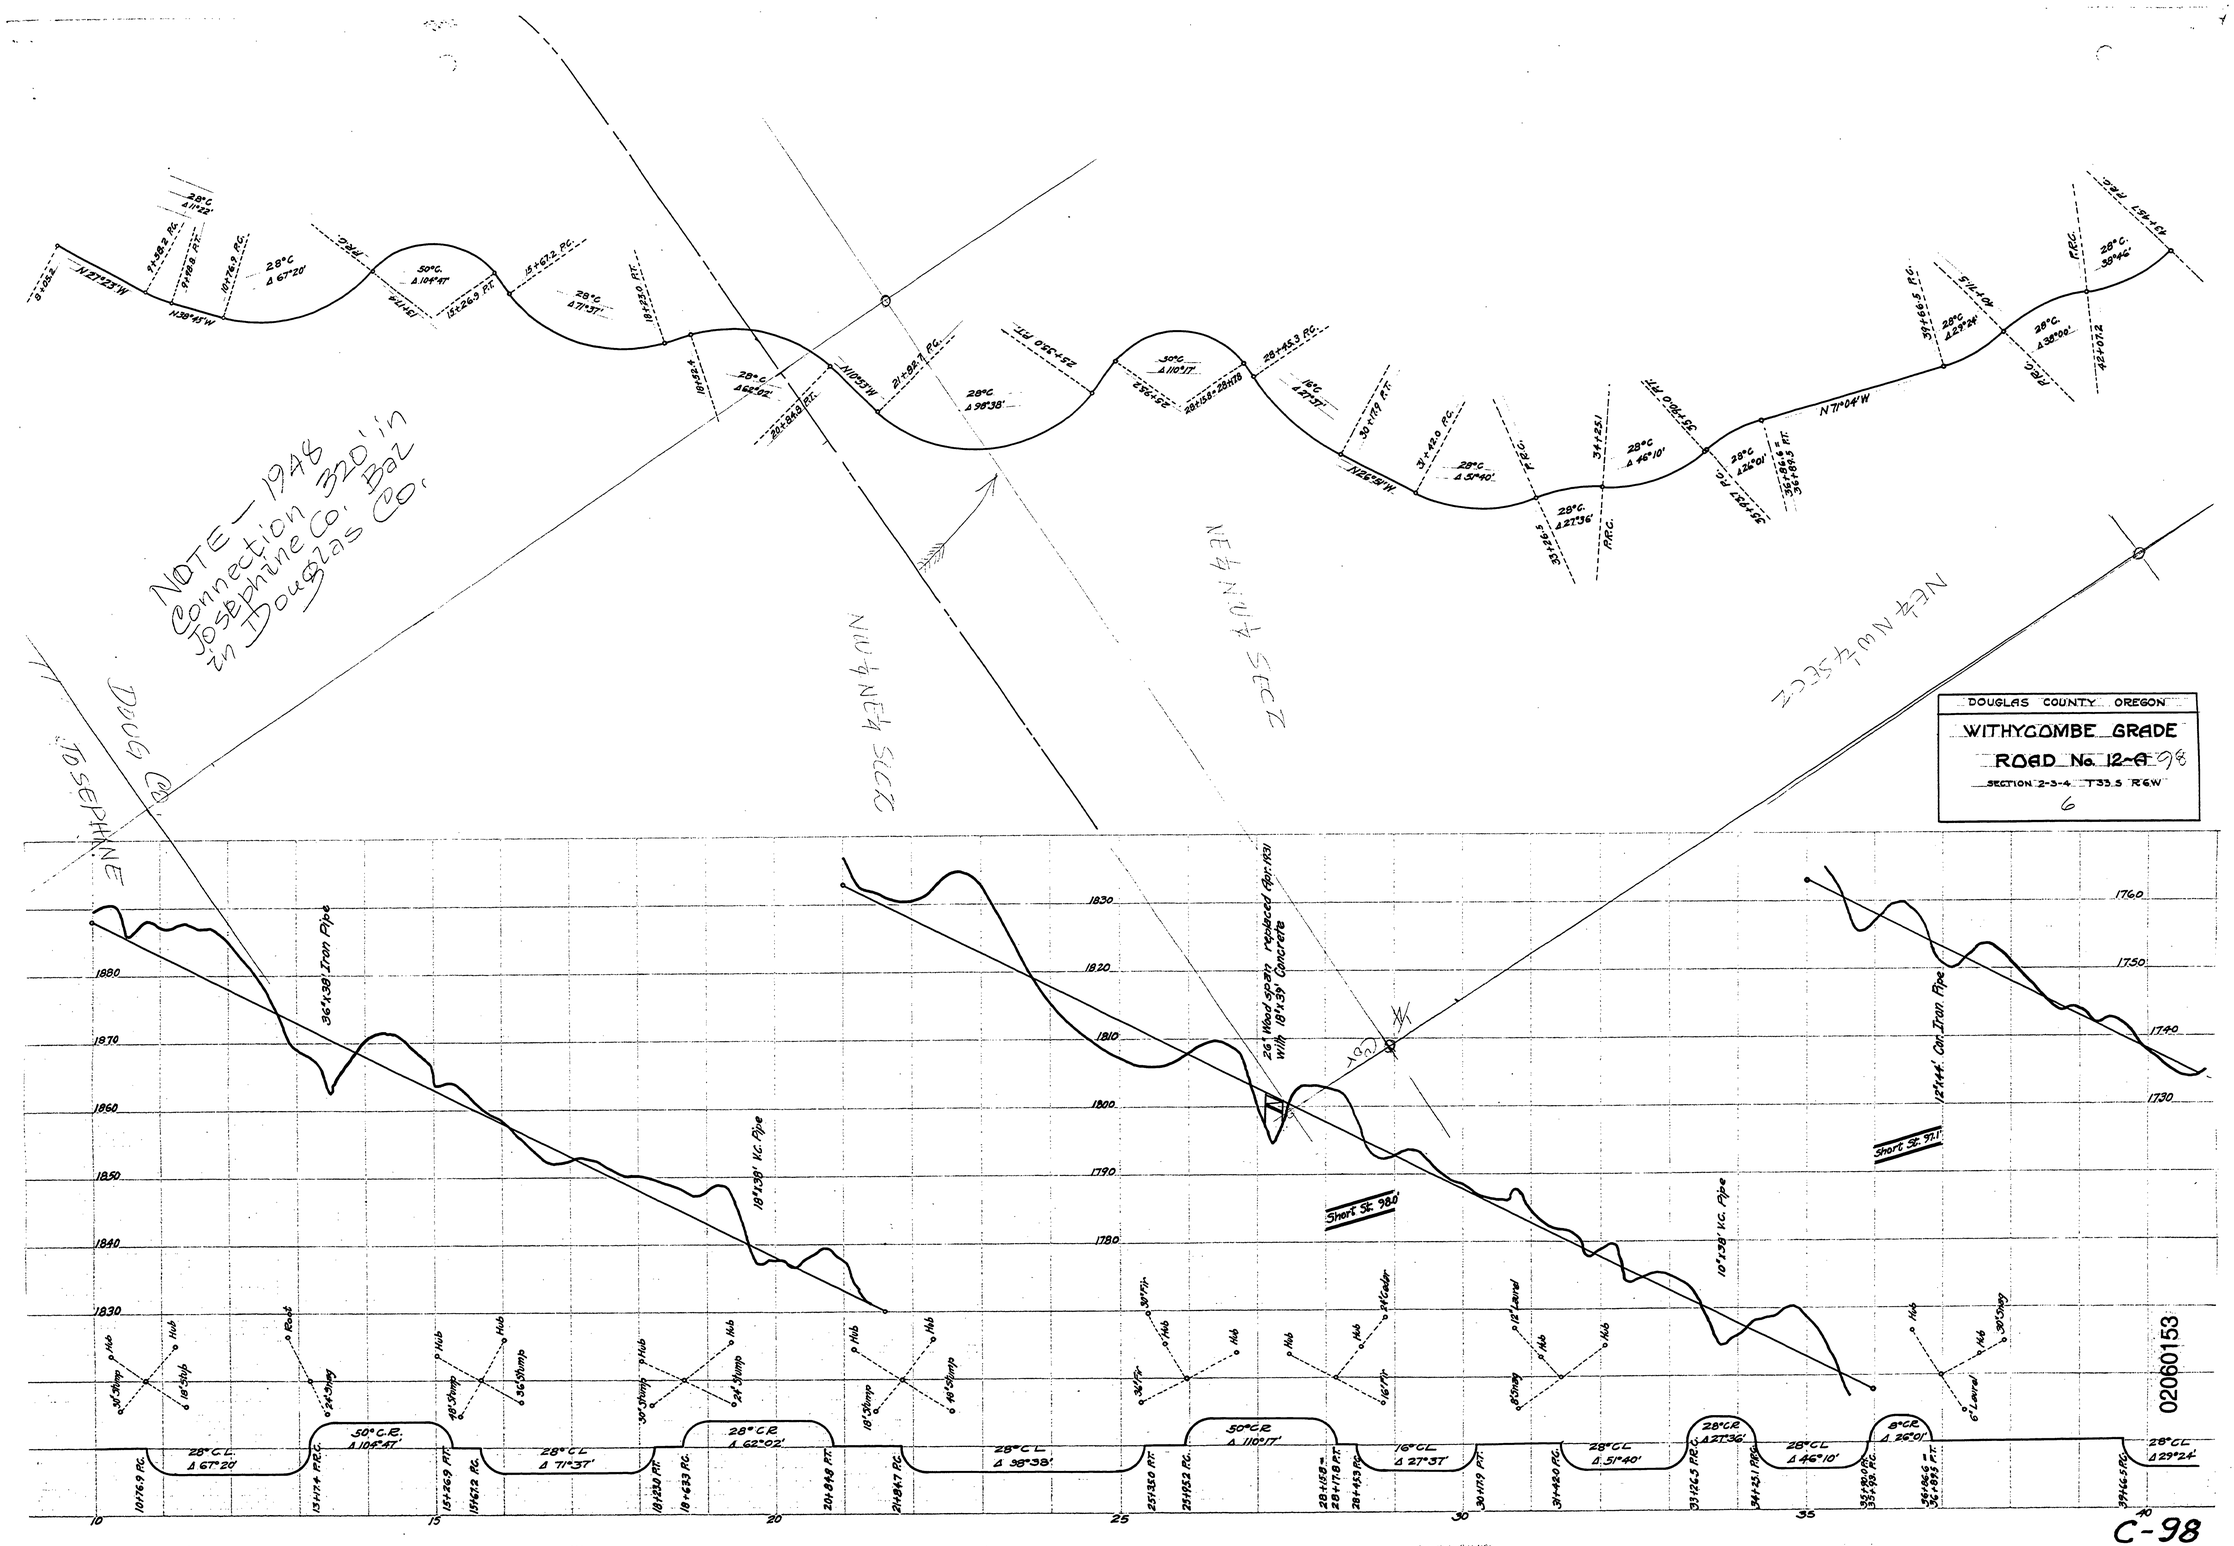
NOTE — 1948
Connection 320' in
Josephine Co. Bal
in Douglas Co.
DOUG Co.
JOSEPHINE
NW¼ NE¼ SEC 2
NE¼ NW¼ SEC 2
NE¼ NW¼ SEC 2
DOUGLAS COUNTY OREGON
WITHYCOMBE GRADE
ROAD No. 12-A 98
SECTION 2-3-4 T33.5 R6W
6
36"x38' Iron Pipe
18"x38' V.C. Pipe
26' Wood spans replaced (Apr. 1931)
with 18"x35' Concrete
Short St. 980'
10"x38' V.C. Pipe
12"x44' Con. Iron Pipe
Short St. 97.1'
02060153
C-98
~ M.P. 7.06 - 1.53