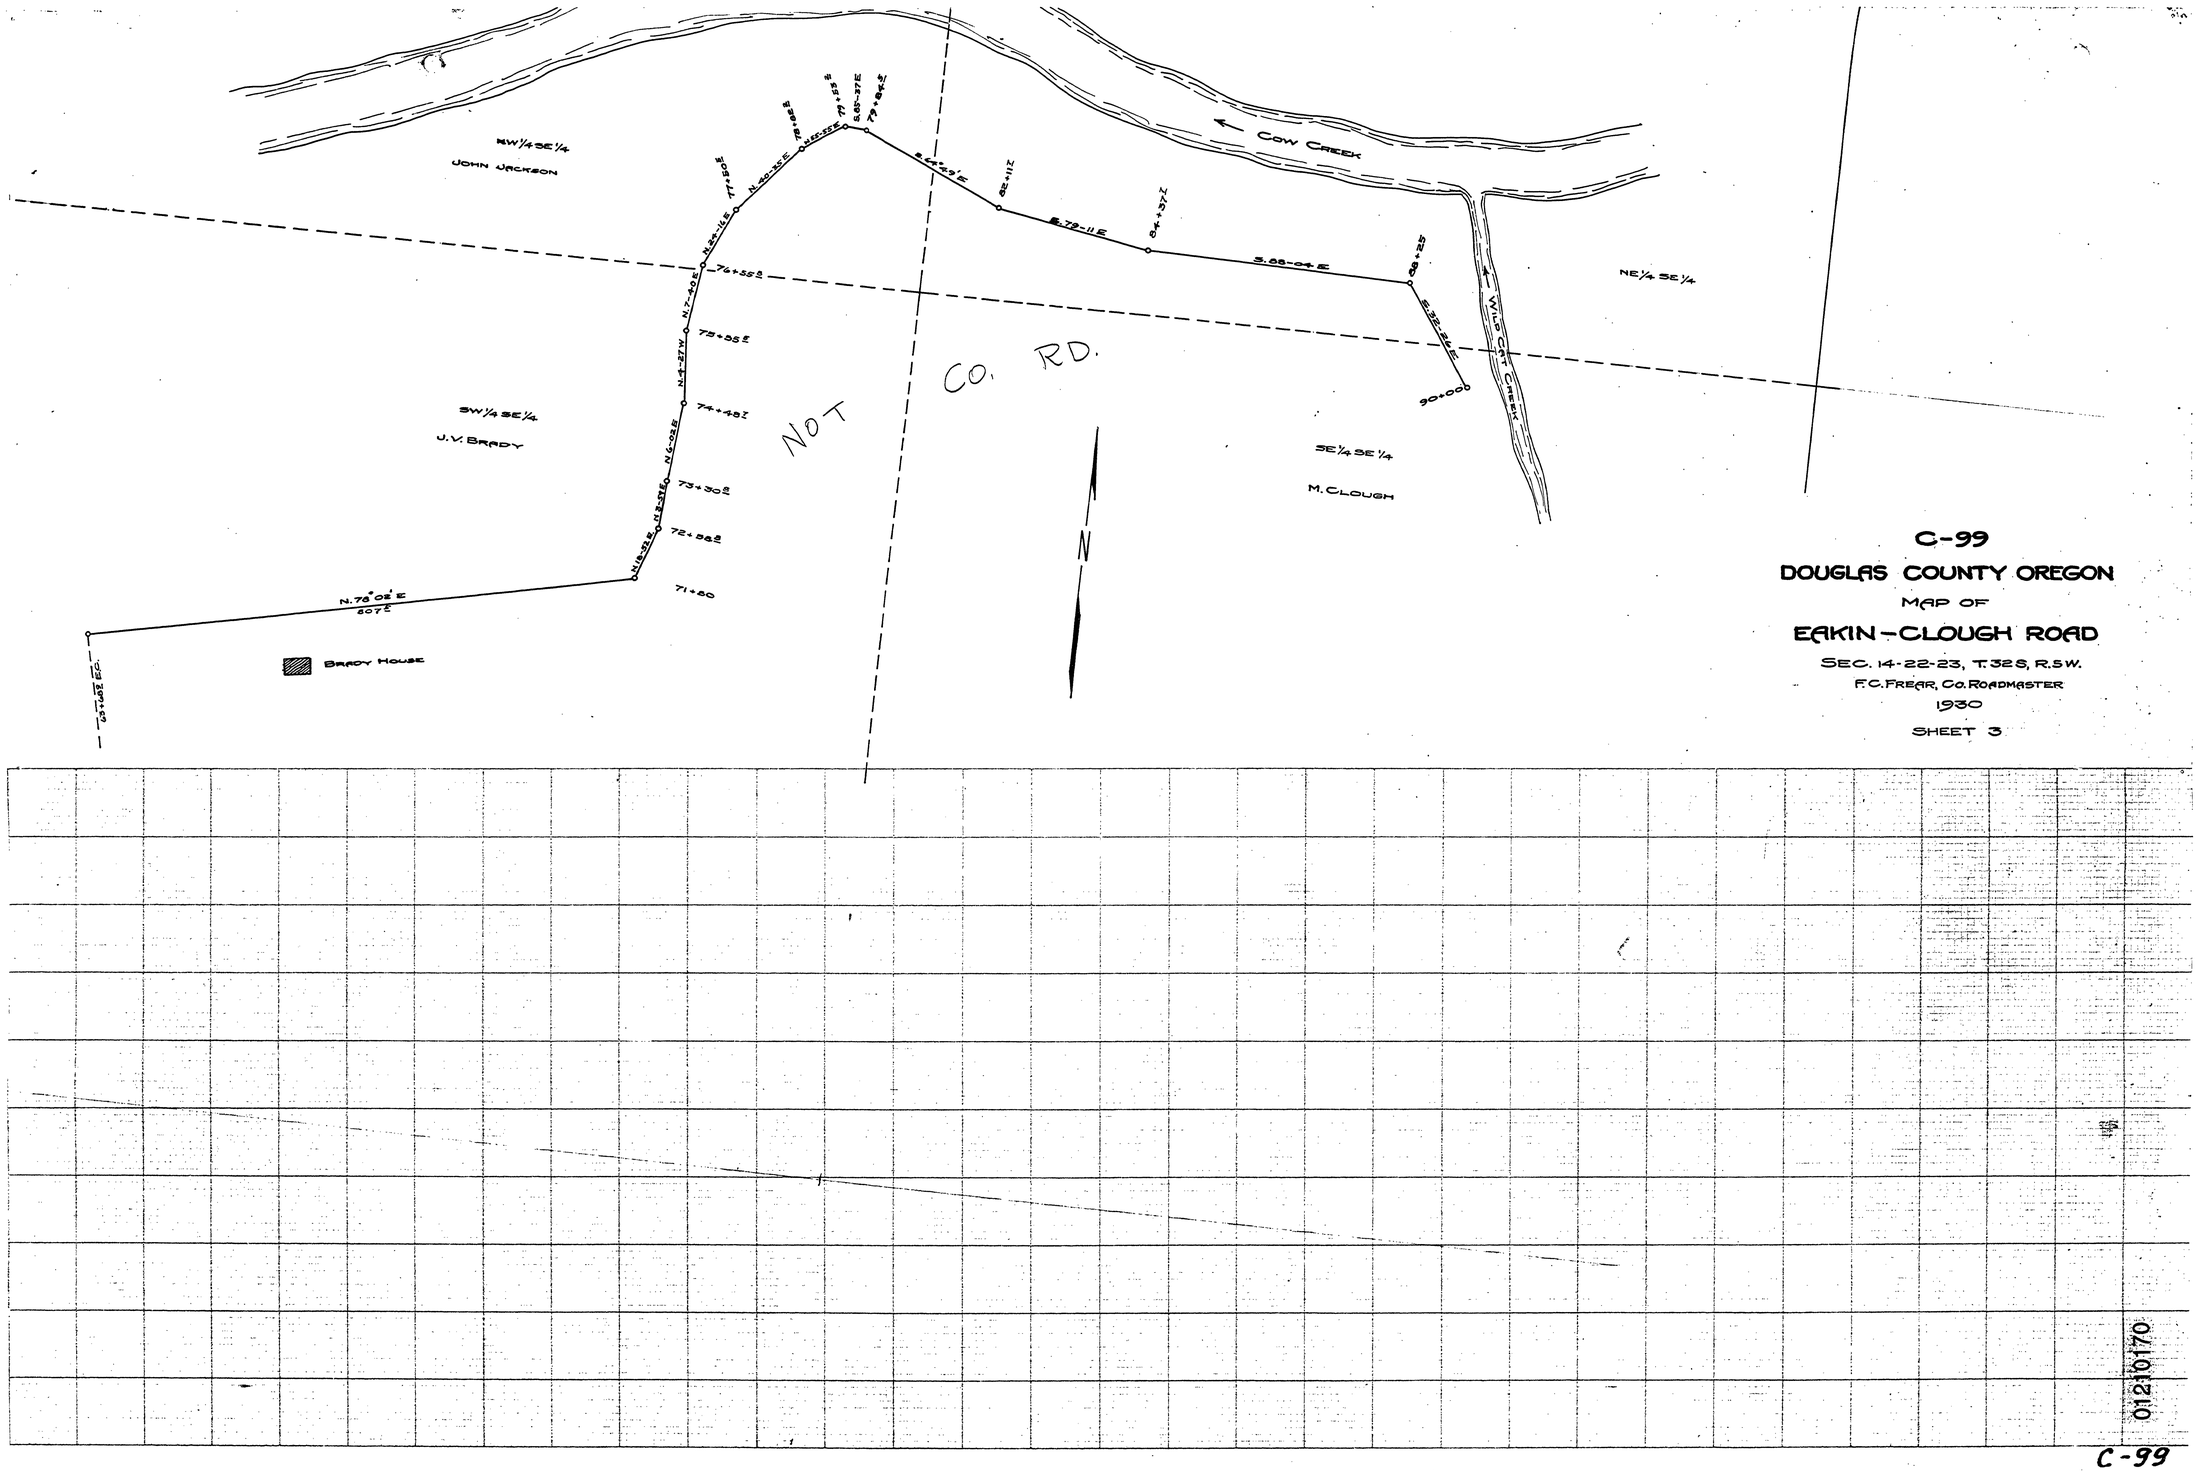

C-99

DOUGLAS COUNTY OREGON

MAP OF

EAKIN-CLOUGH ROAD

SEC. 14-22-23, T. 32 S, R. 5 W.

F. C. FREAR, Co. ROADMASTER

1930

SHEET 3

012101170

C-99

~M.P. 1.21 - 1.70

T32-5 S.14, 22, 23 1930 SHT 3 OF 3