M.P. 0.00

SEC 32 T28S R6W W.M.
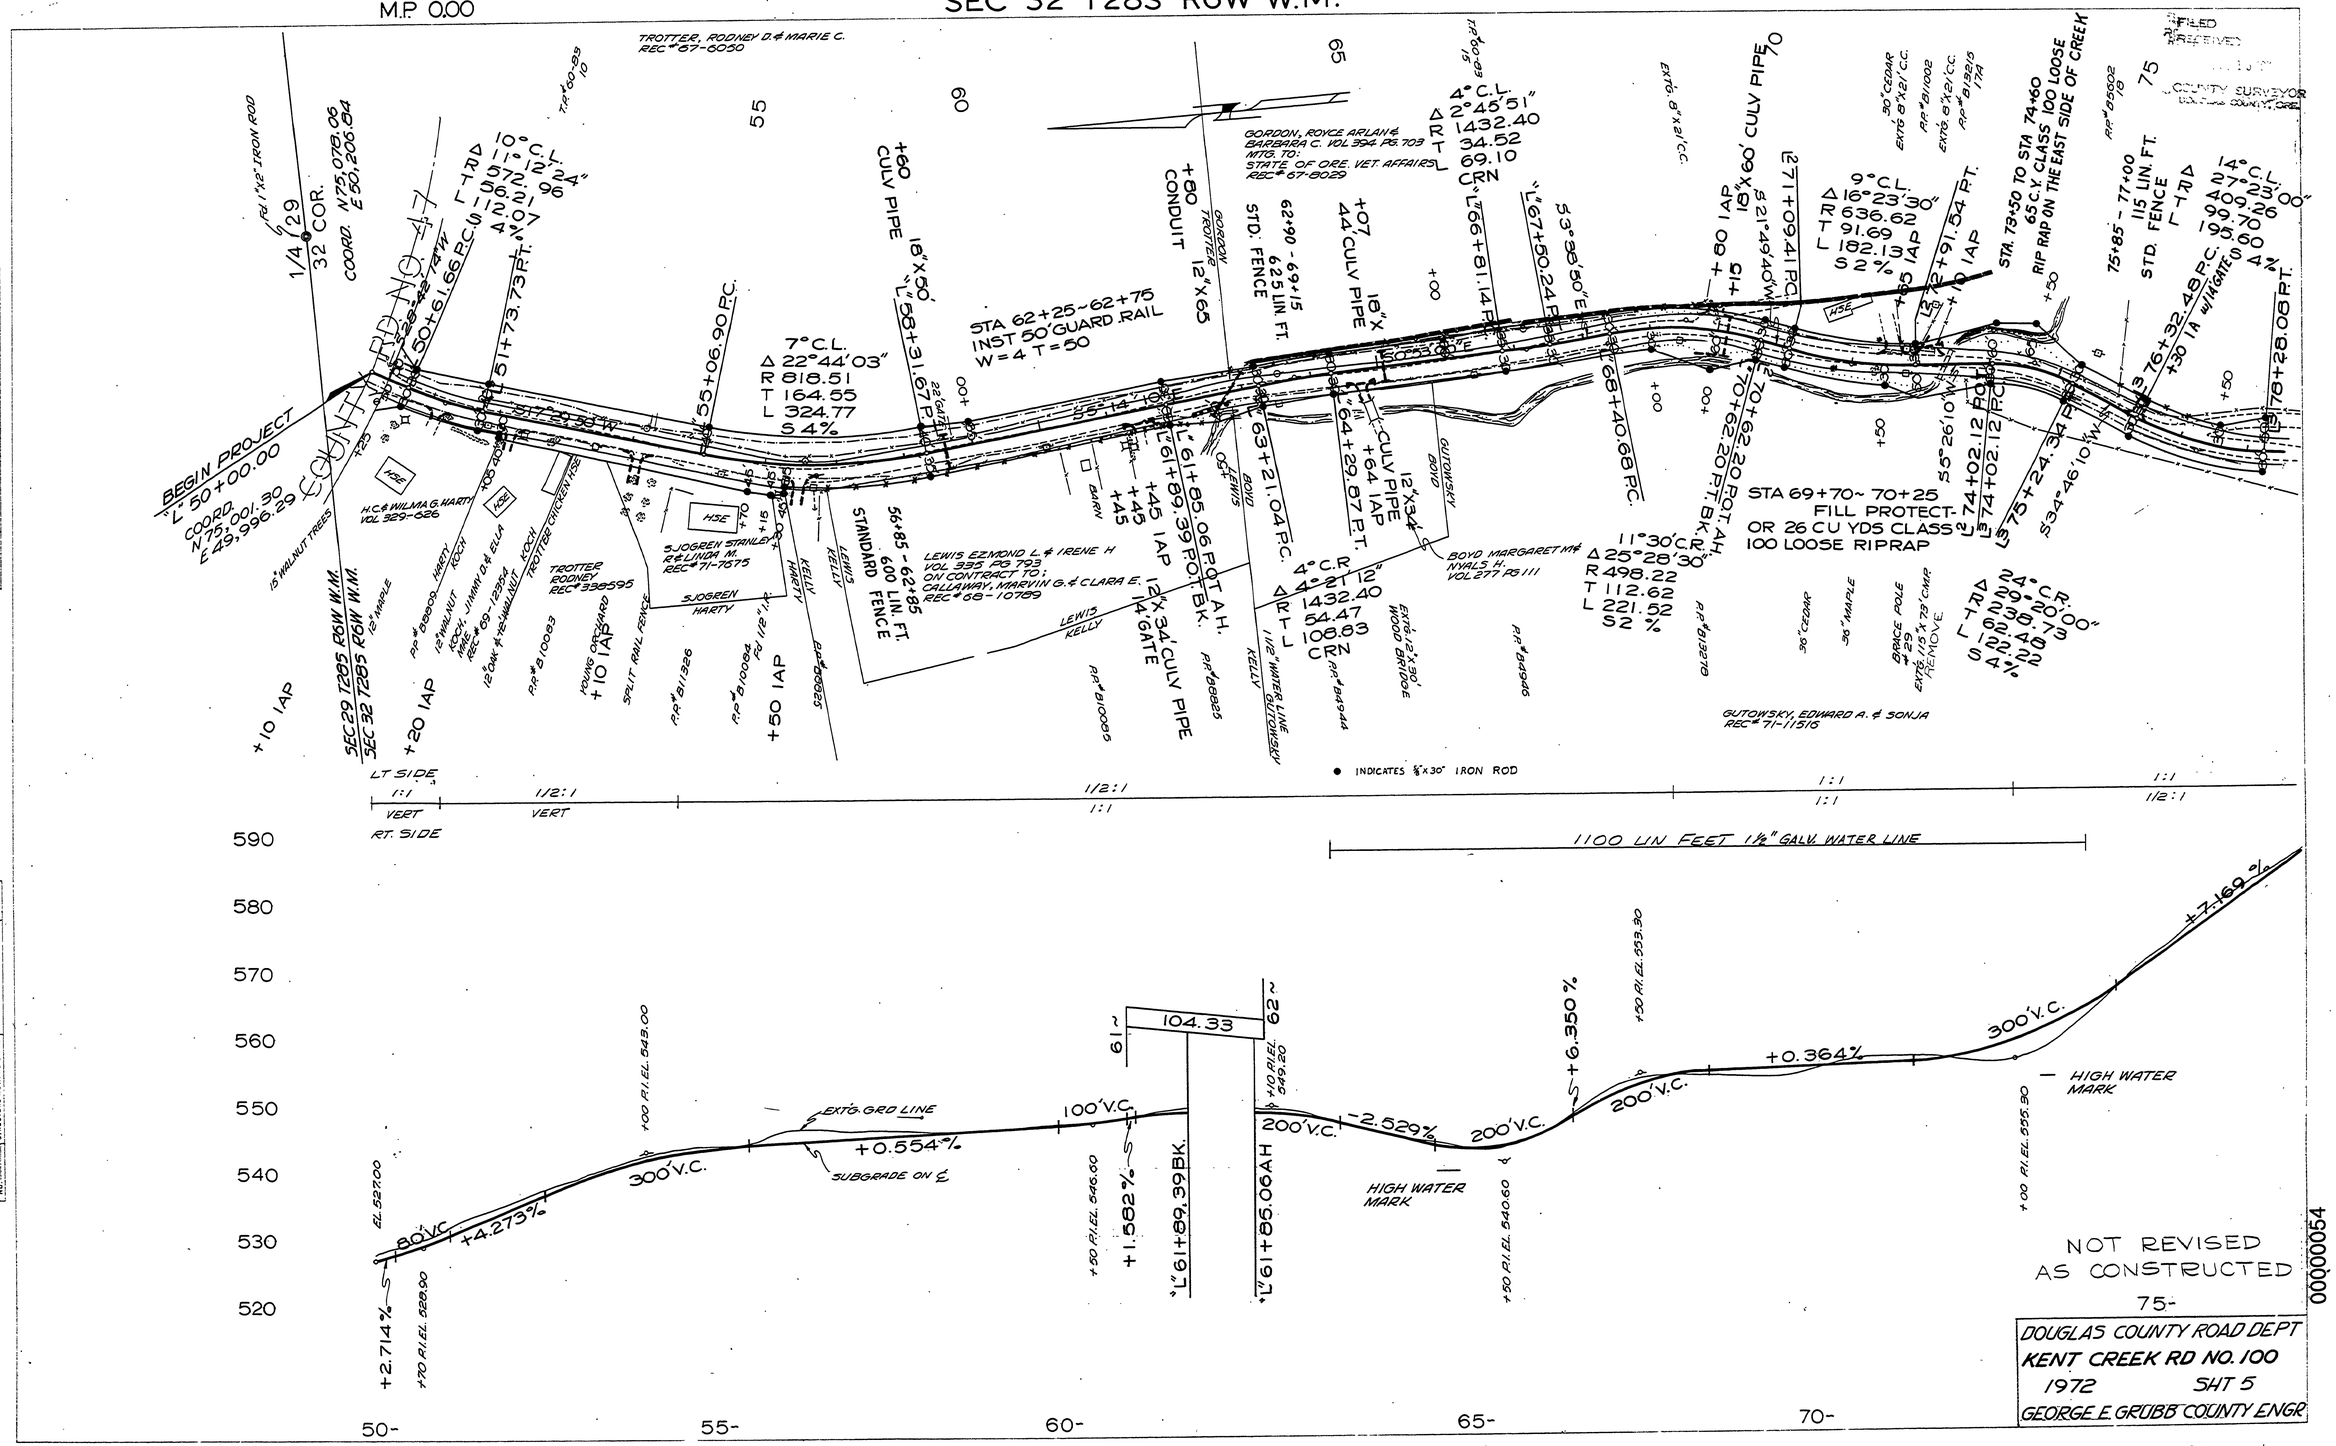
RD 100