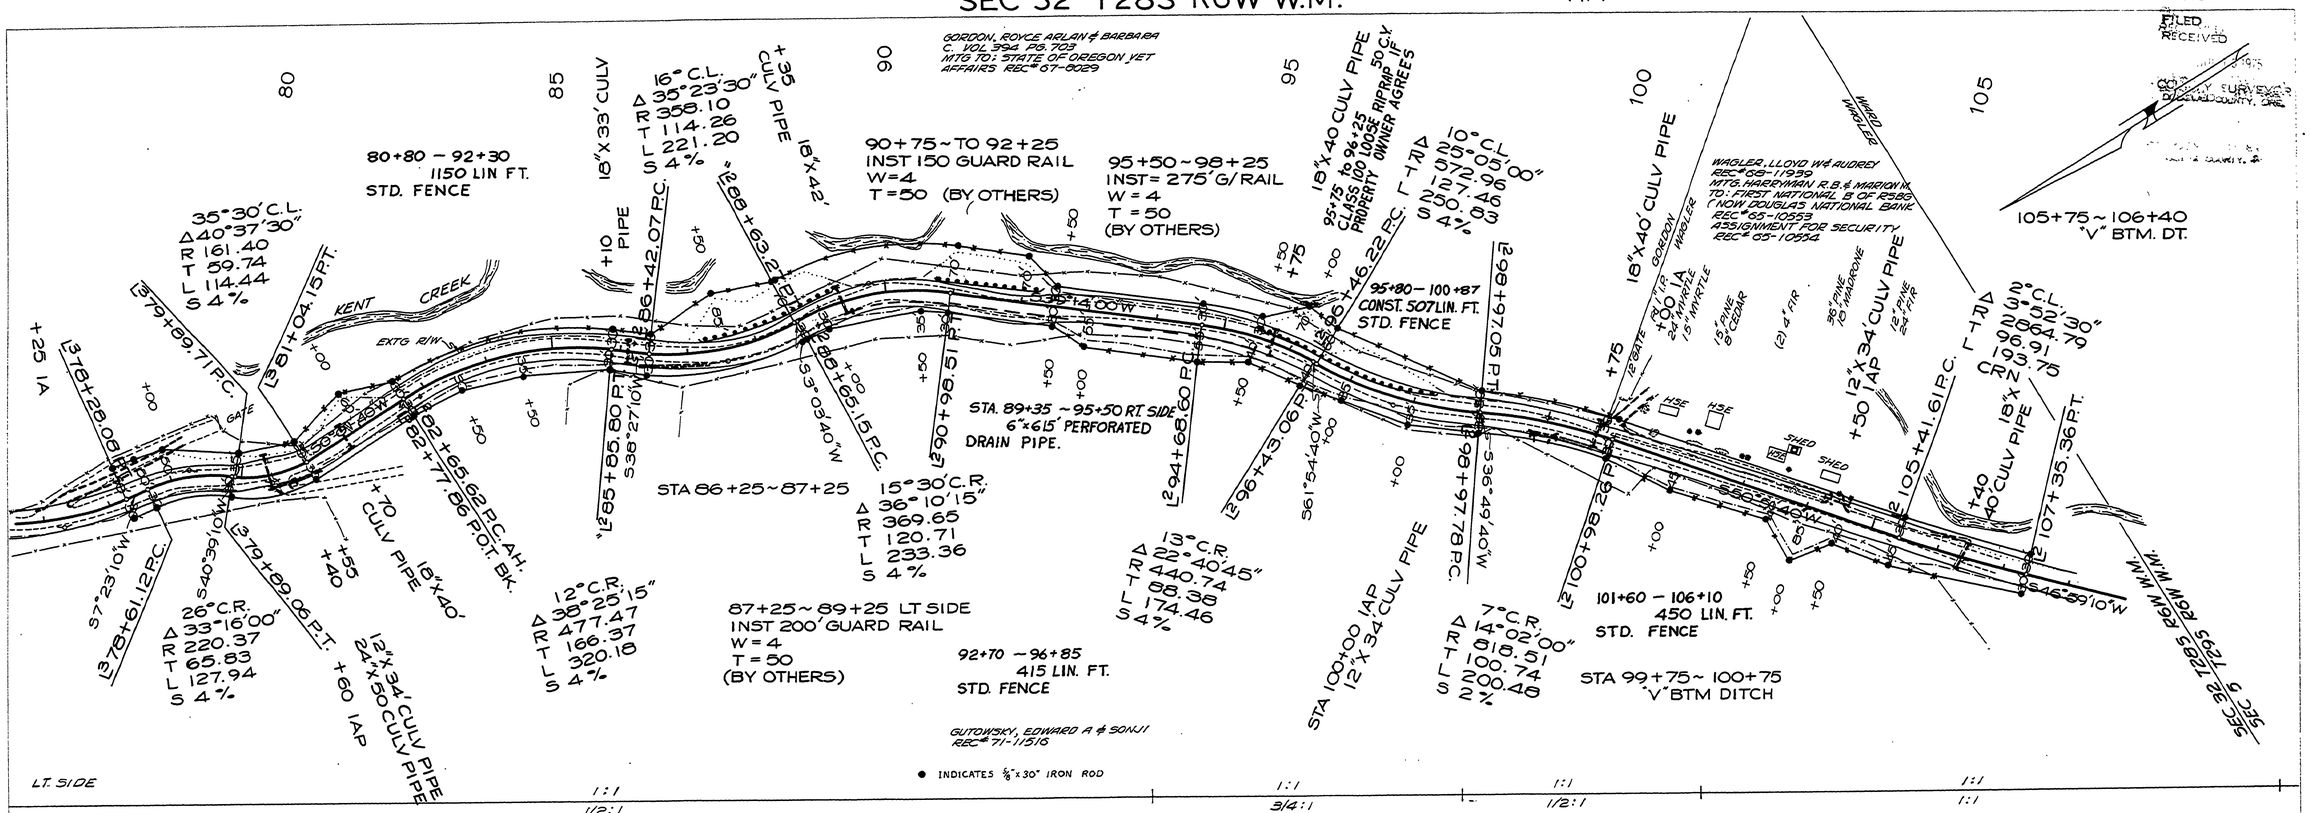

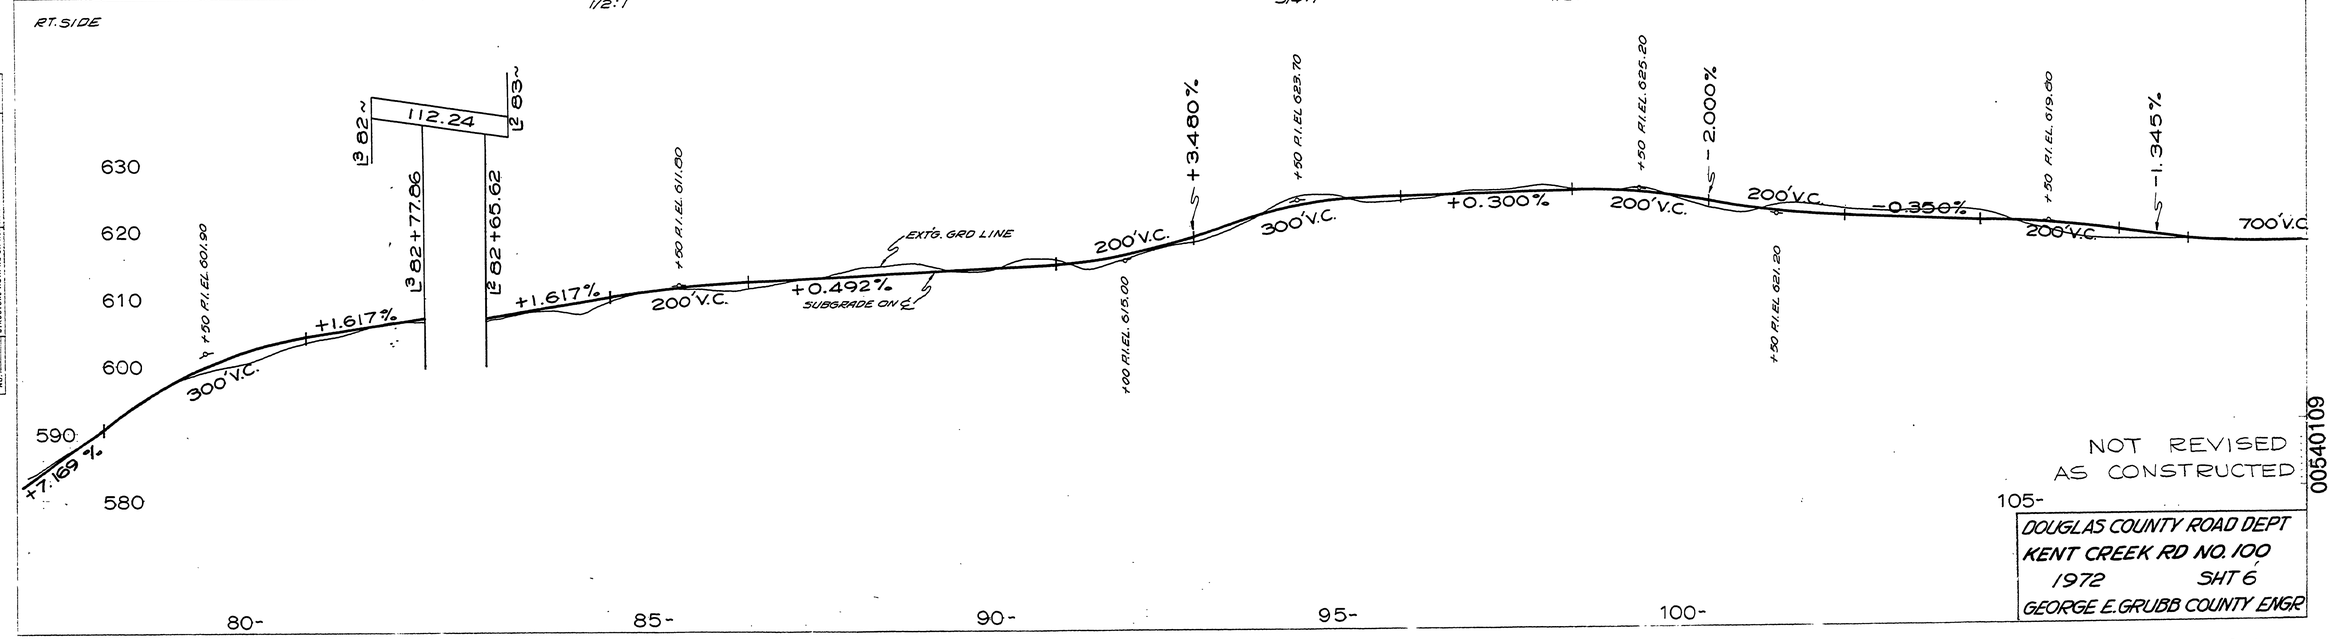

NOT REVISED
AS CONSTRUCTED

00540109

DOUGLAS COUNTY ROAD DEPT
KENT CREEK RD NO. 100
1972 SHT 6
GEORGE E. GRUBB COUNTY ENGR

PLAN — SURVEYED: DRAWN: ALIGNMENT CHECKED: R.L. OF MAP CHECKED: NOTE BOOK NO. — BY — DATE

PROFILE — SURVEYED: DRAWN: GRADE CHECKED: B. M. NOTED: SUBGRADE CHECKED: NOTE BOOK NO. — BY — DATE