S1 T29S R6W W.M.

RD 105

FILED
RECEIVED
AUG 1 1975
COUNTY SURVEYOR
DOUGLAS COUNTY, ORE.

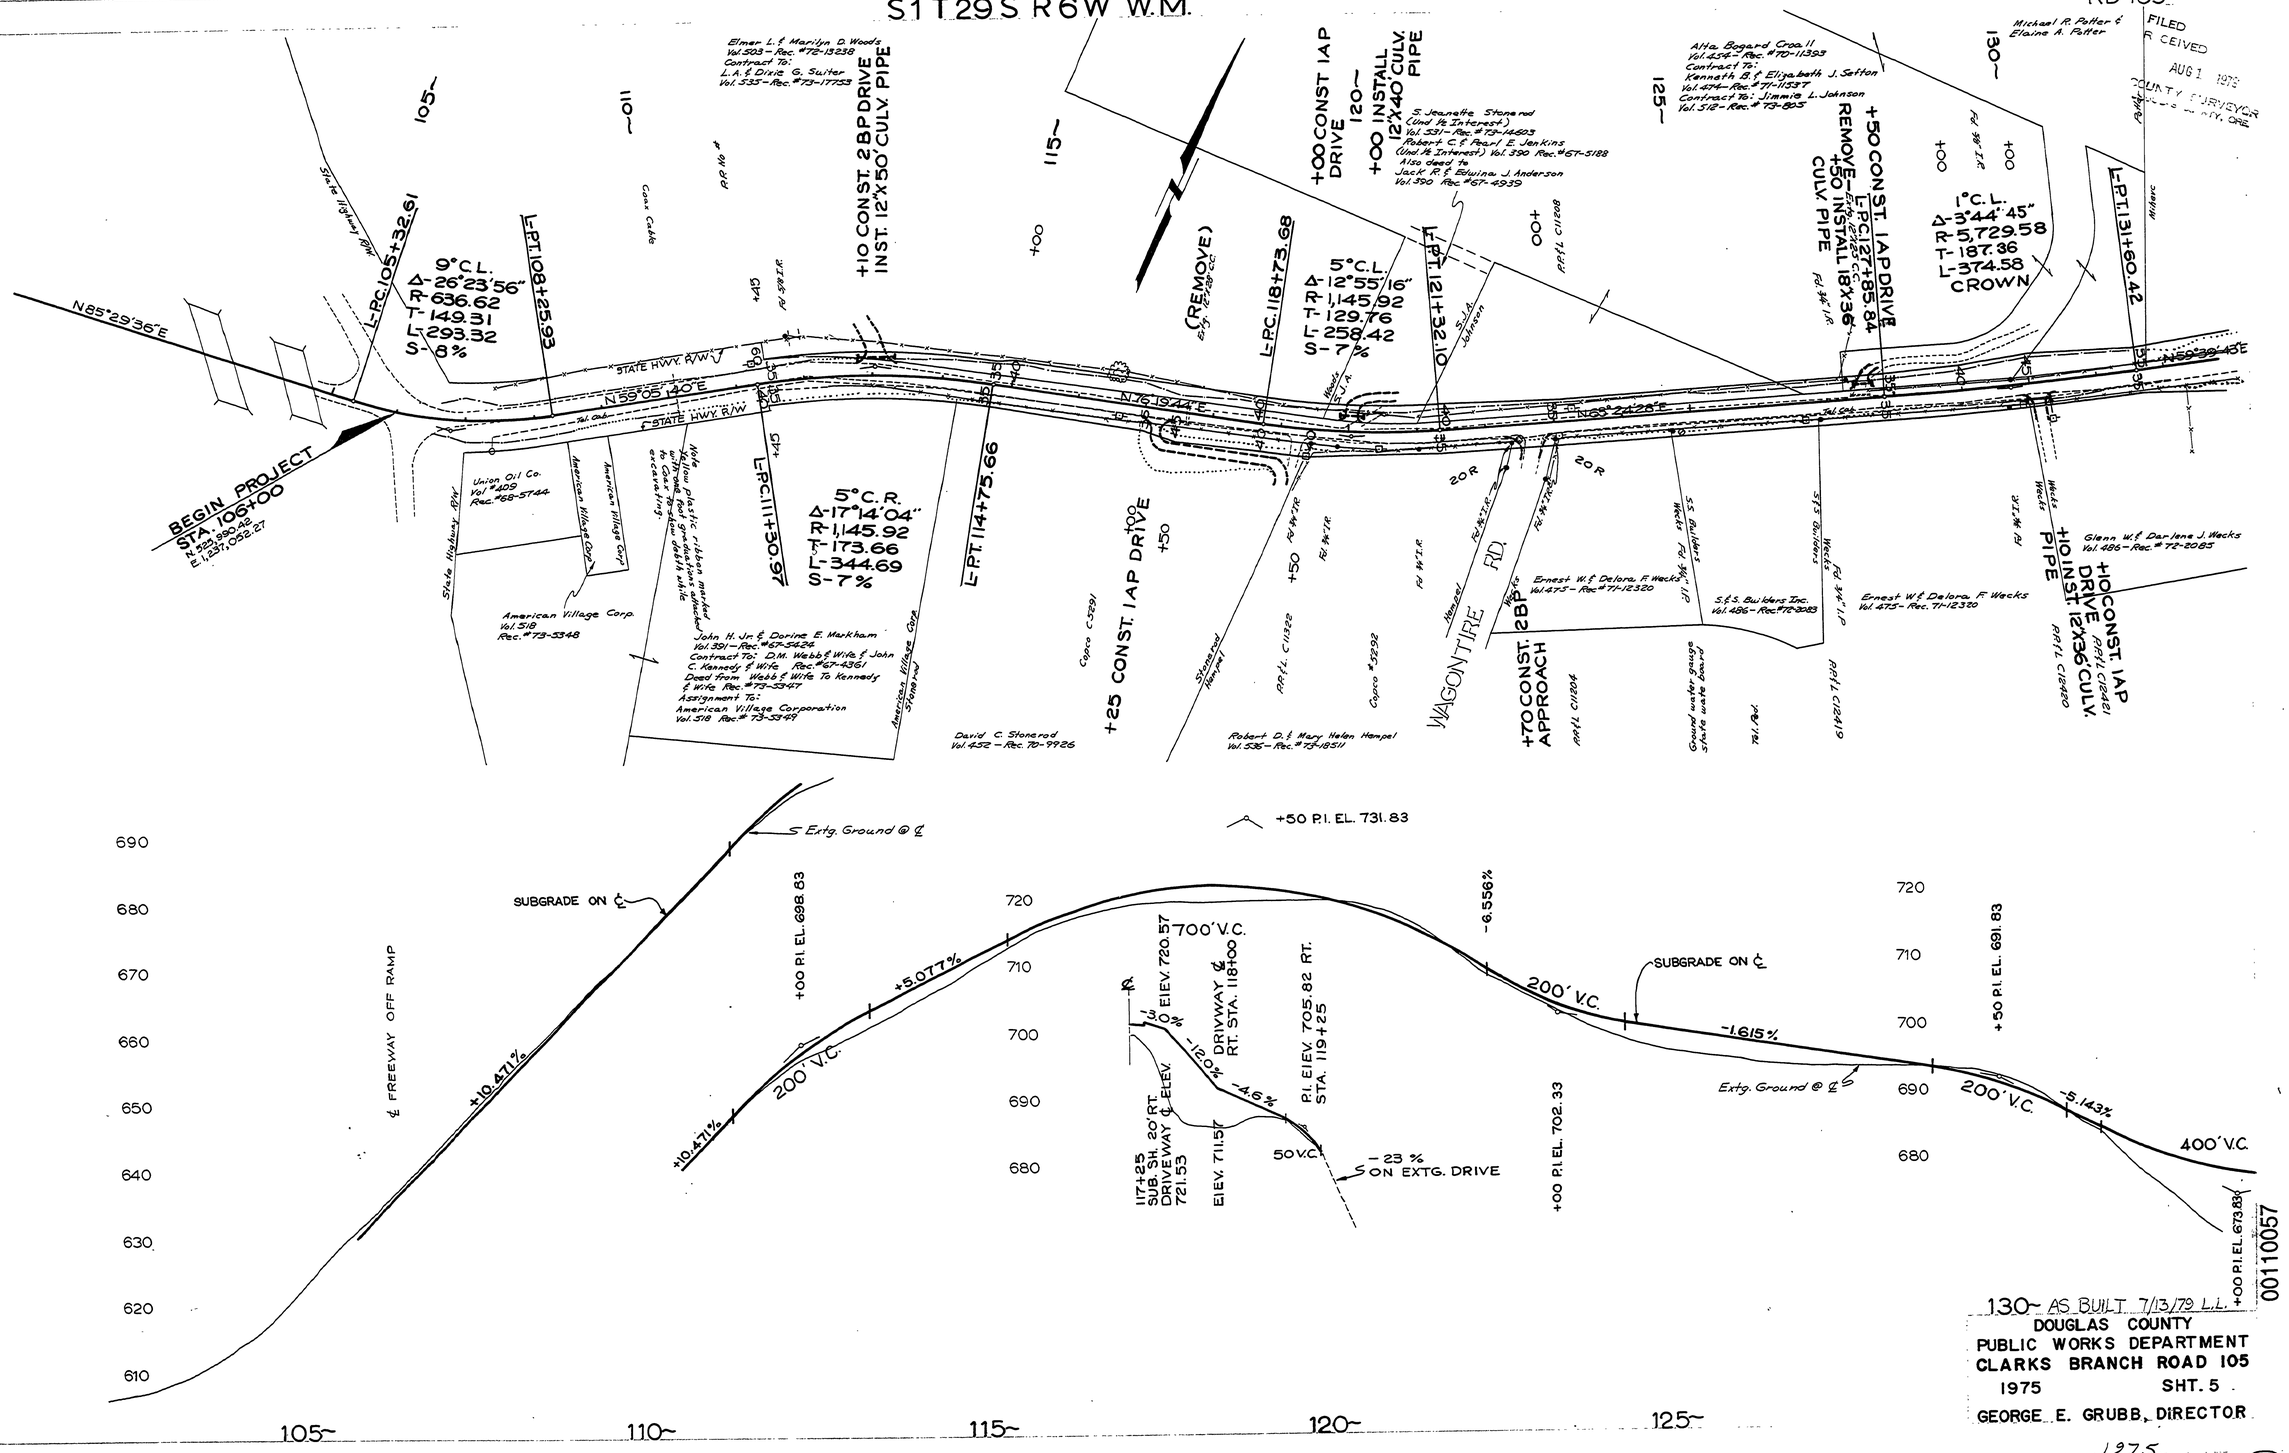

130~ AS BUILT 7/13/79 L.L.

DOUGLAS COUNTY
PUBLIC WORKS DEPARTMENT
CLARKS BRANCH ROAD 105
1975 SHT. 5
GEORGE E. GRUBB, DIRECTOR

00110057

M.P. 0.11 - 0.57

1975
C. Rd. #105 sht. 5 (24)