MP 2

S 31 T28S R5W & S 32 T28S R5W W.M.

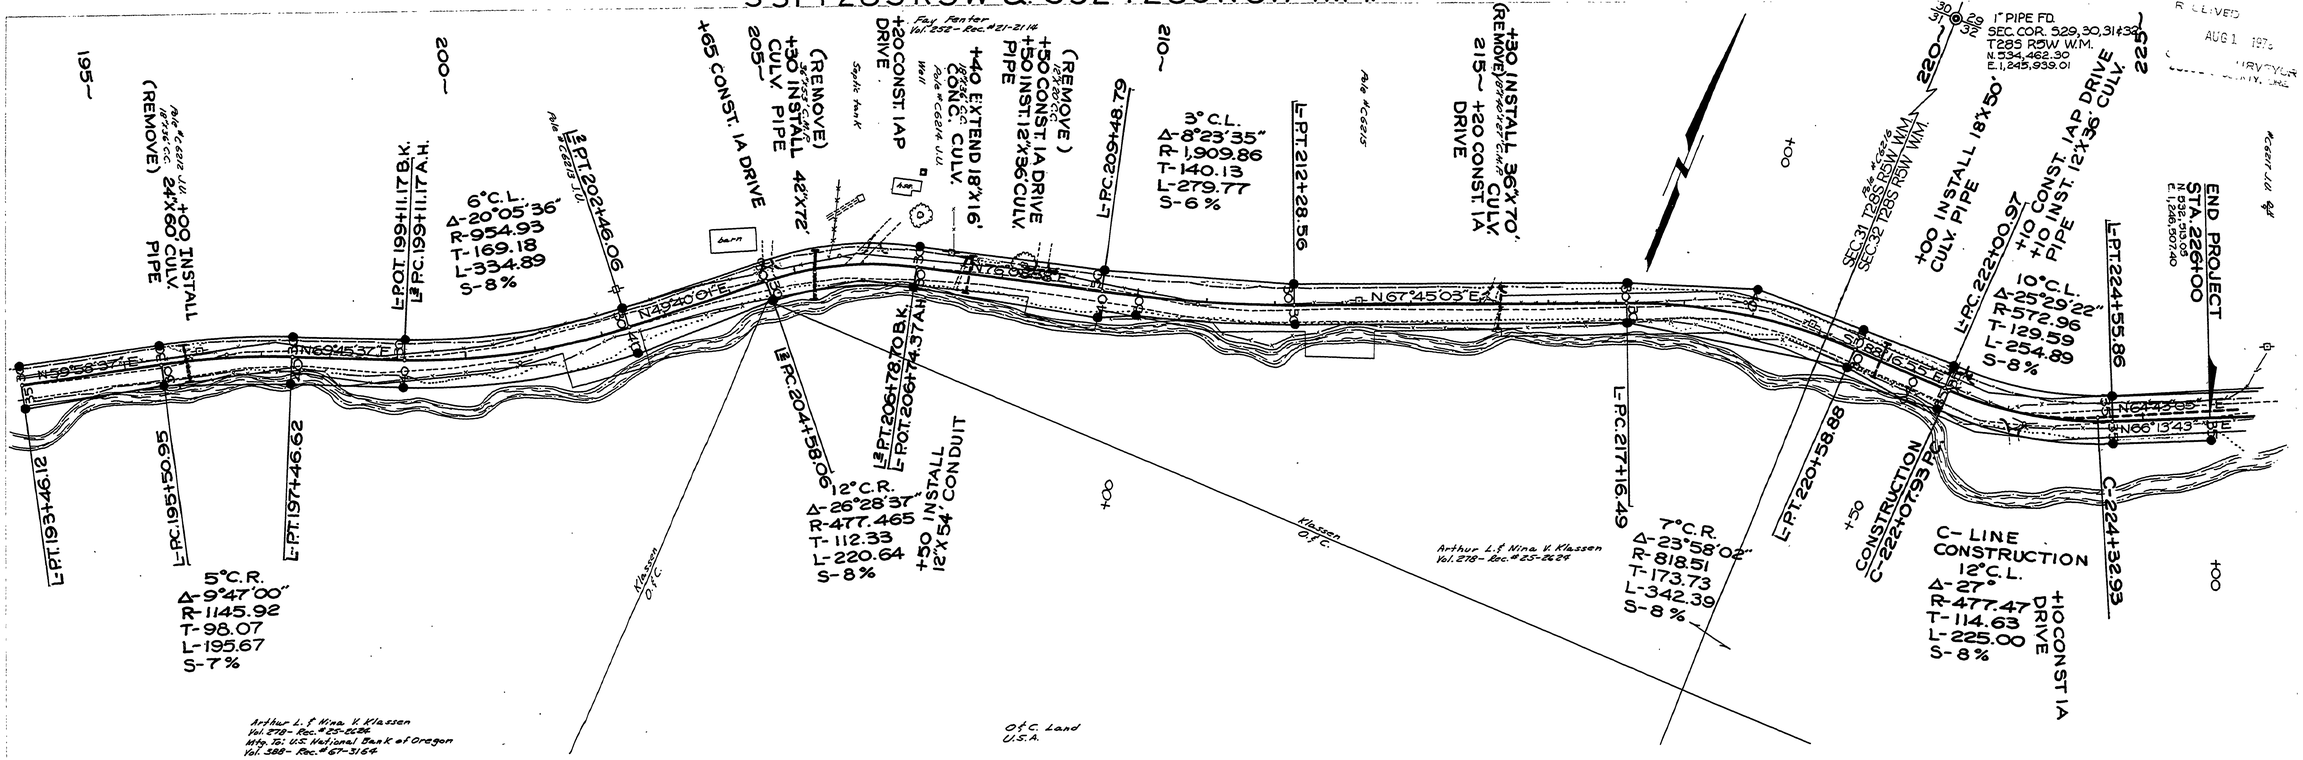

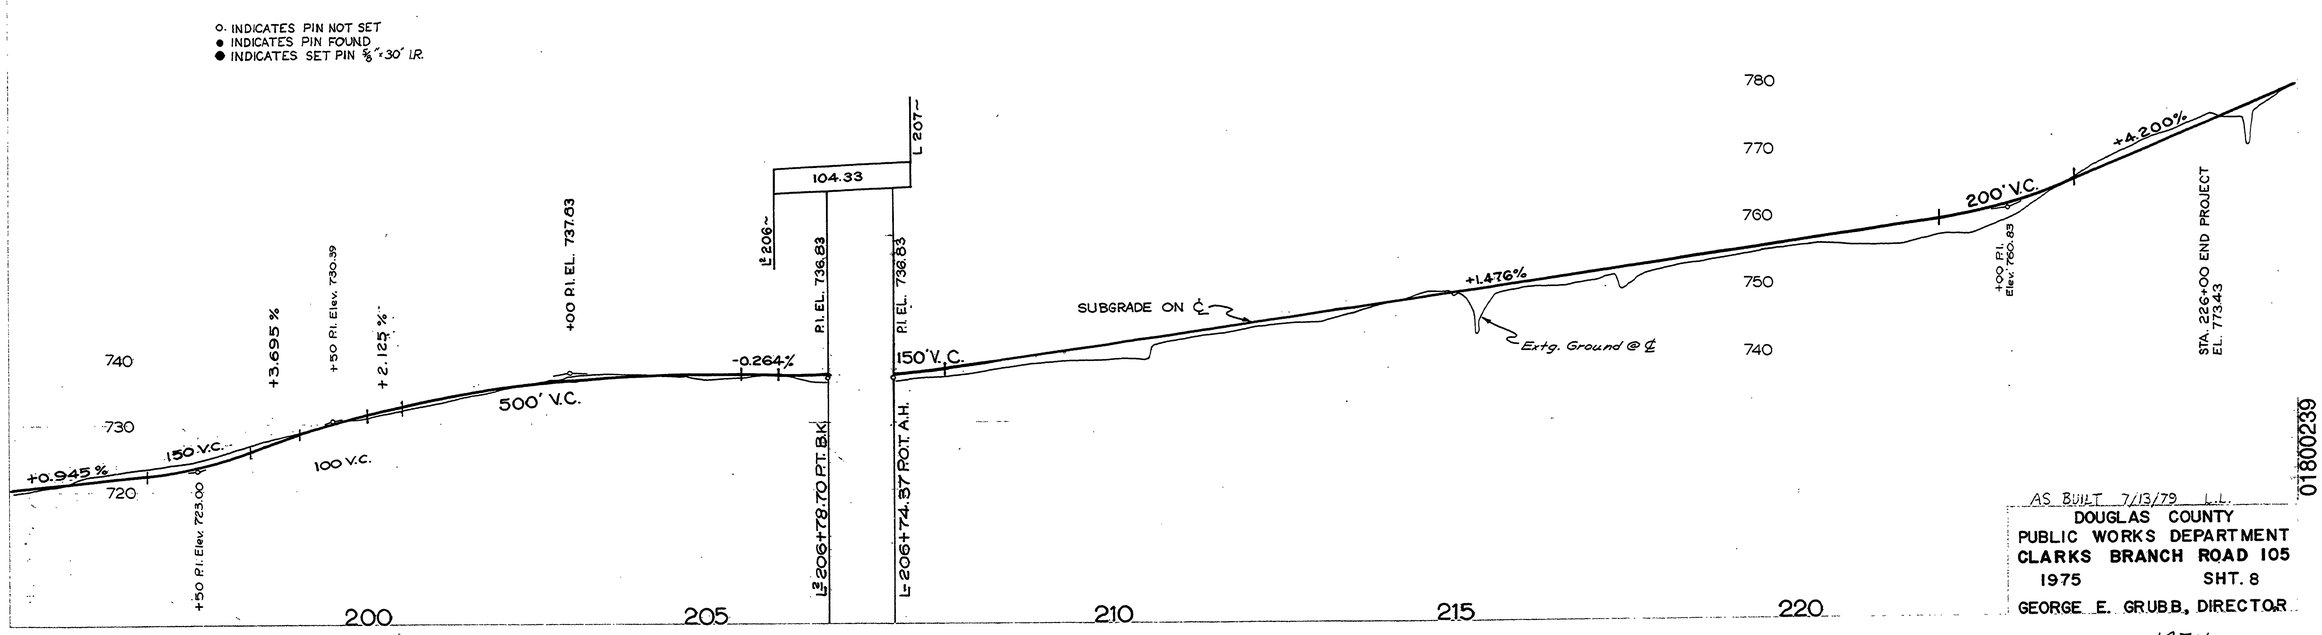

01800239

AS BUILT 7/13/79 L.L.

DOUGLAS COUNTY
PUBLIC WORKS DEPARTMENT
CLARKS BRANCH ROAD 105
1975 SHT. 8
GEORGE E. GRUBB, DIRECTOR

1975

M.P. 1.80-2.39

C. Rd #105 Sht. 8

27