SEC. 16 & 21 T28S R6W W.M.

RD. NO. 107

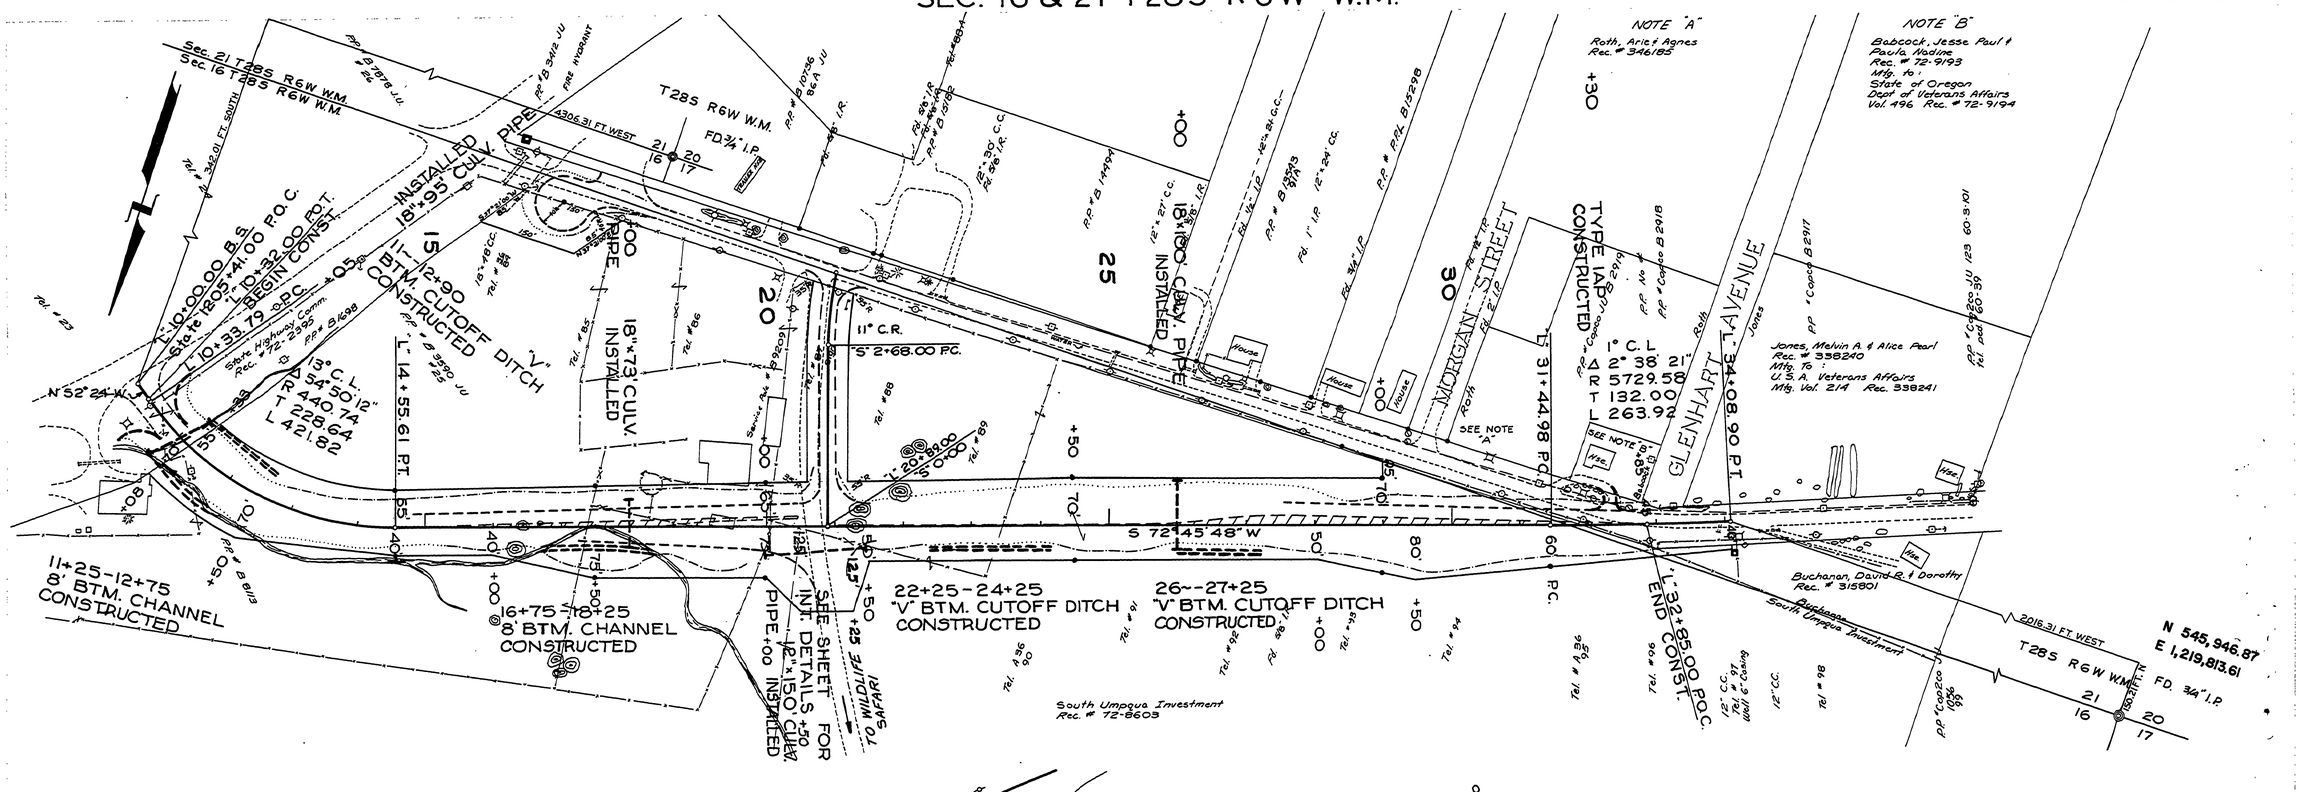

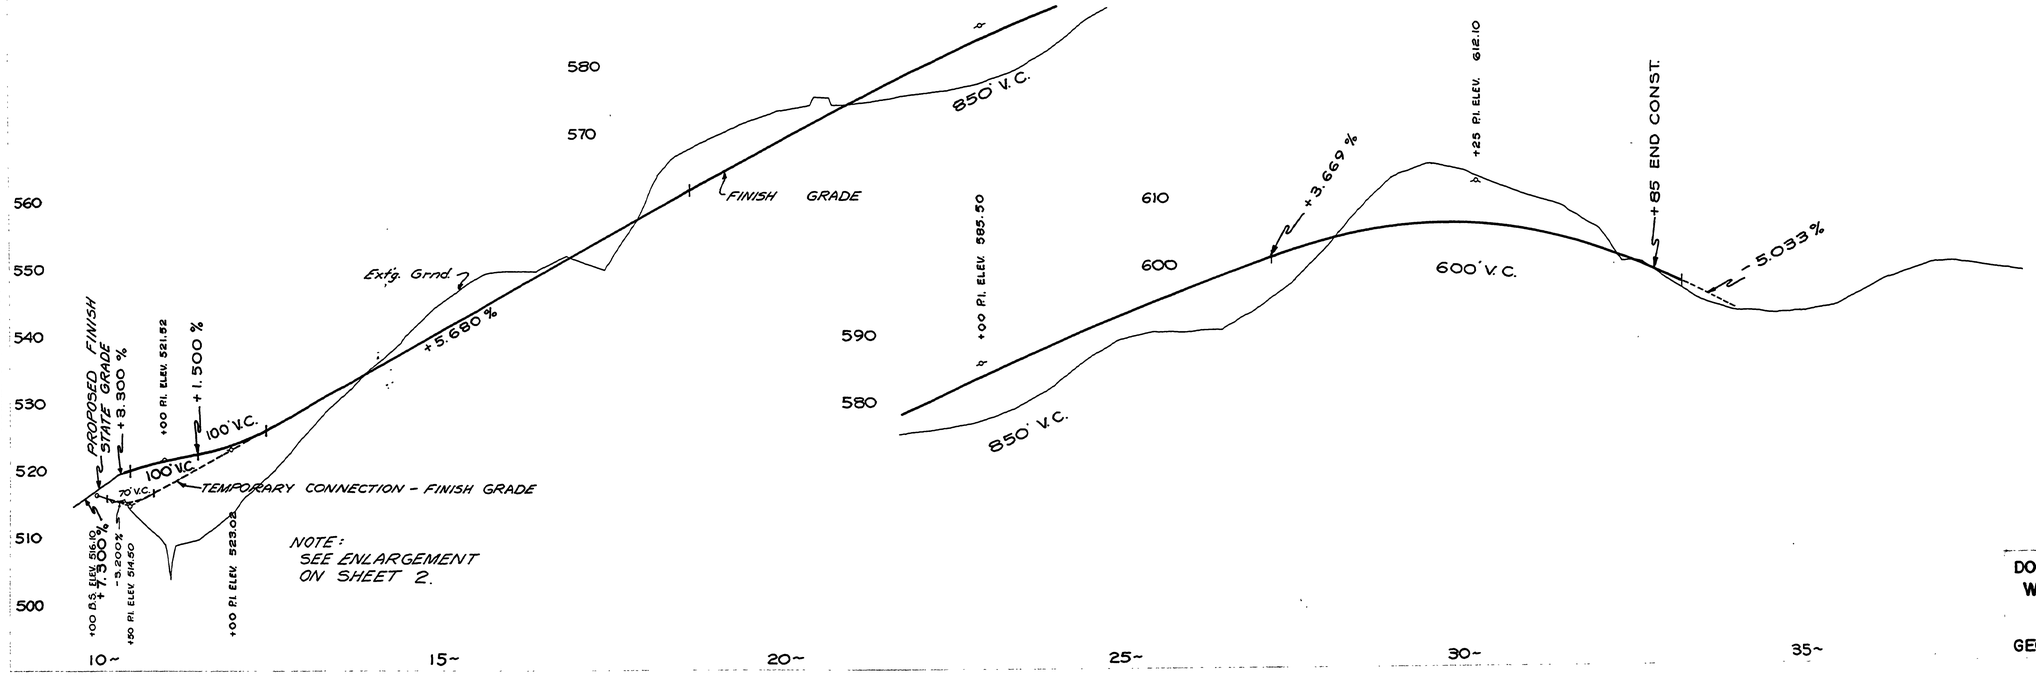

REVISED 8/7/74 P.H.

DOUGLAS COUNTY ROAD DEPT.
WINSTON ROAD NO. 107
1973 SHT. 3
GEORGE E. GRUBB, COUNTY ENG'R.

00620107

M.P. 0.62 - 1.07

1973
C.Rd #107. sht. 3 (31)