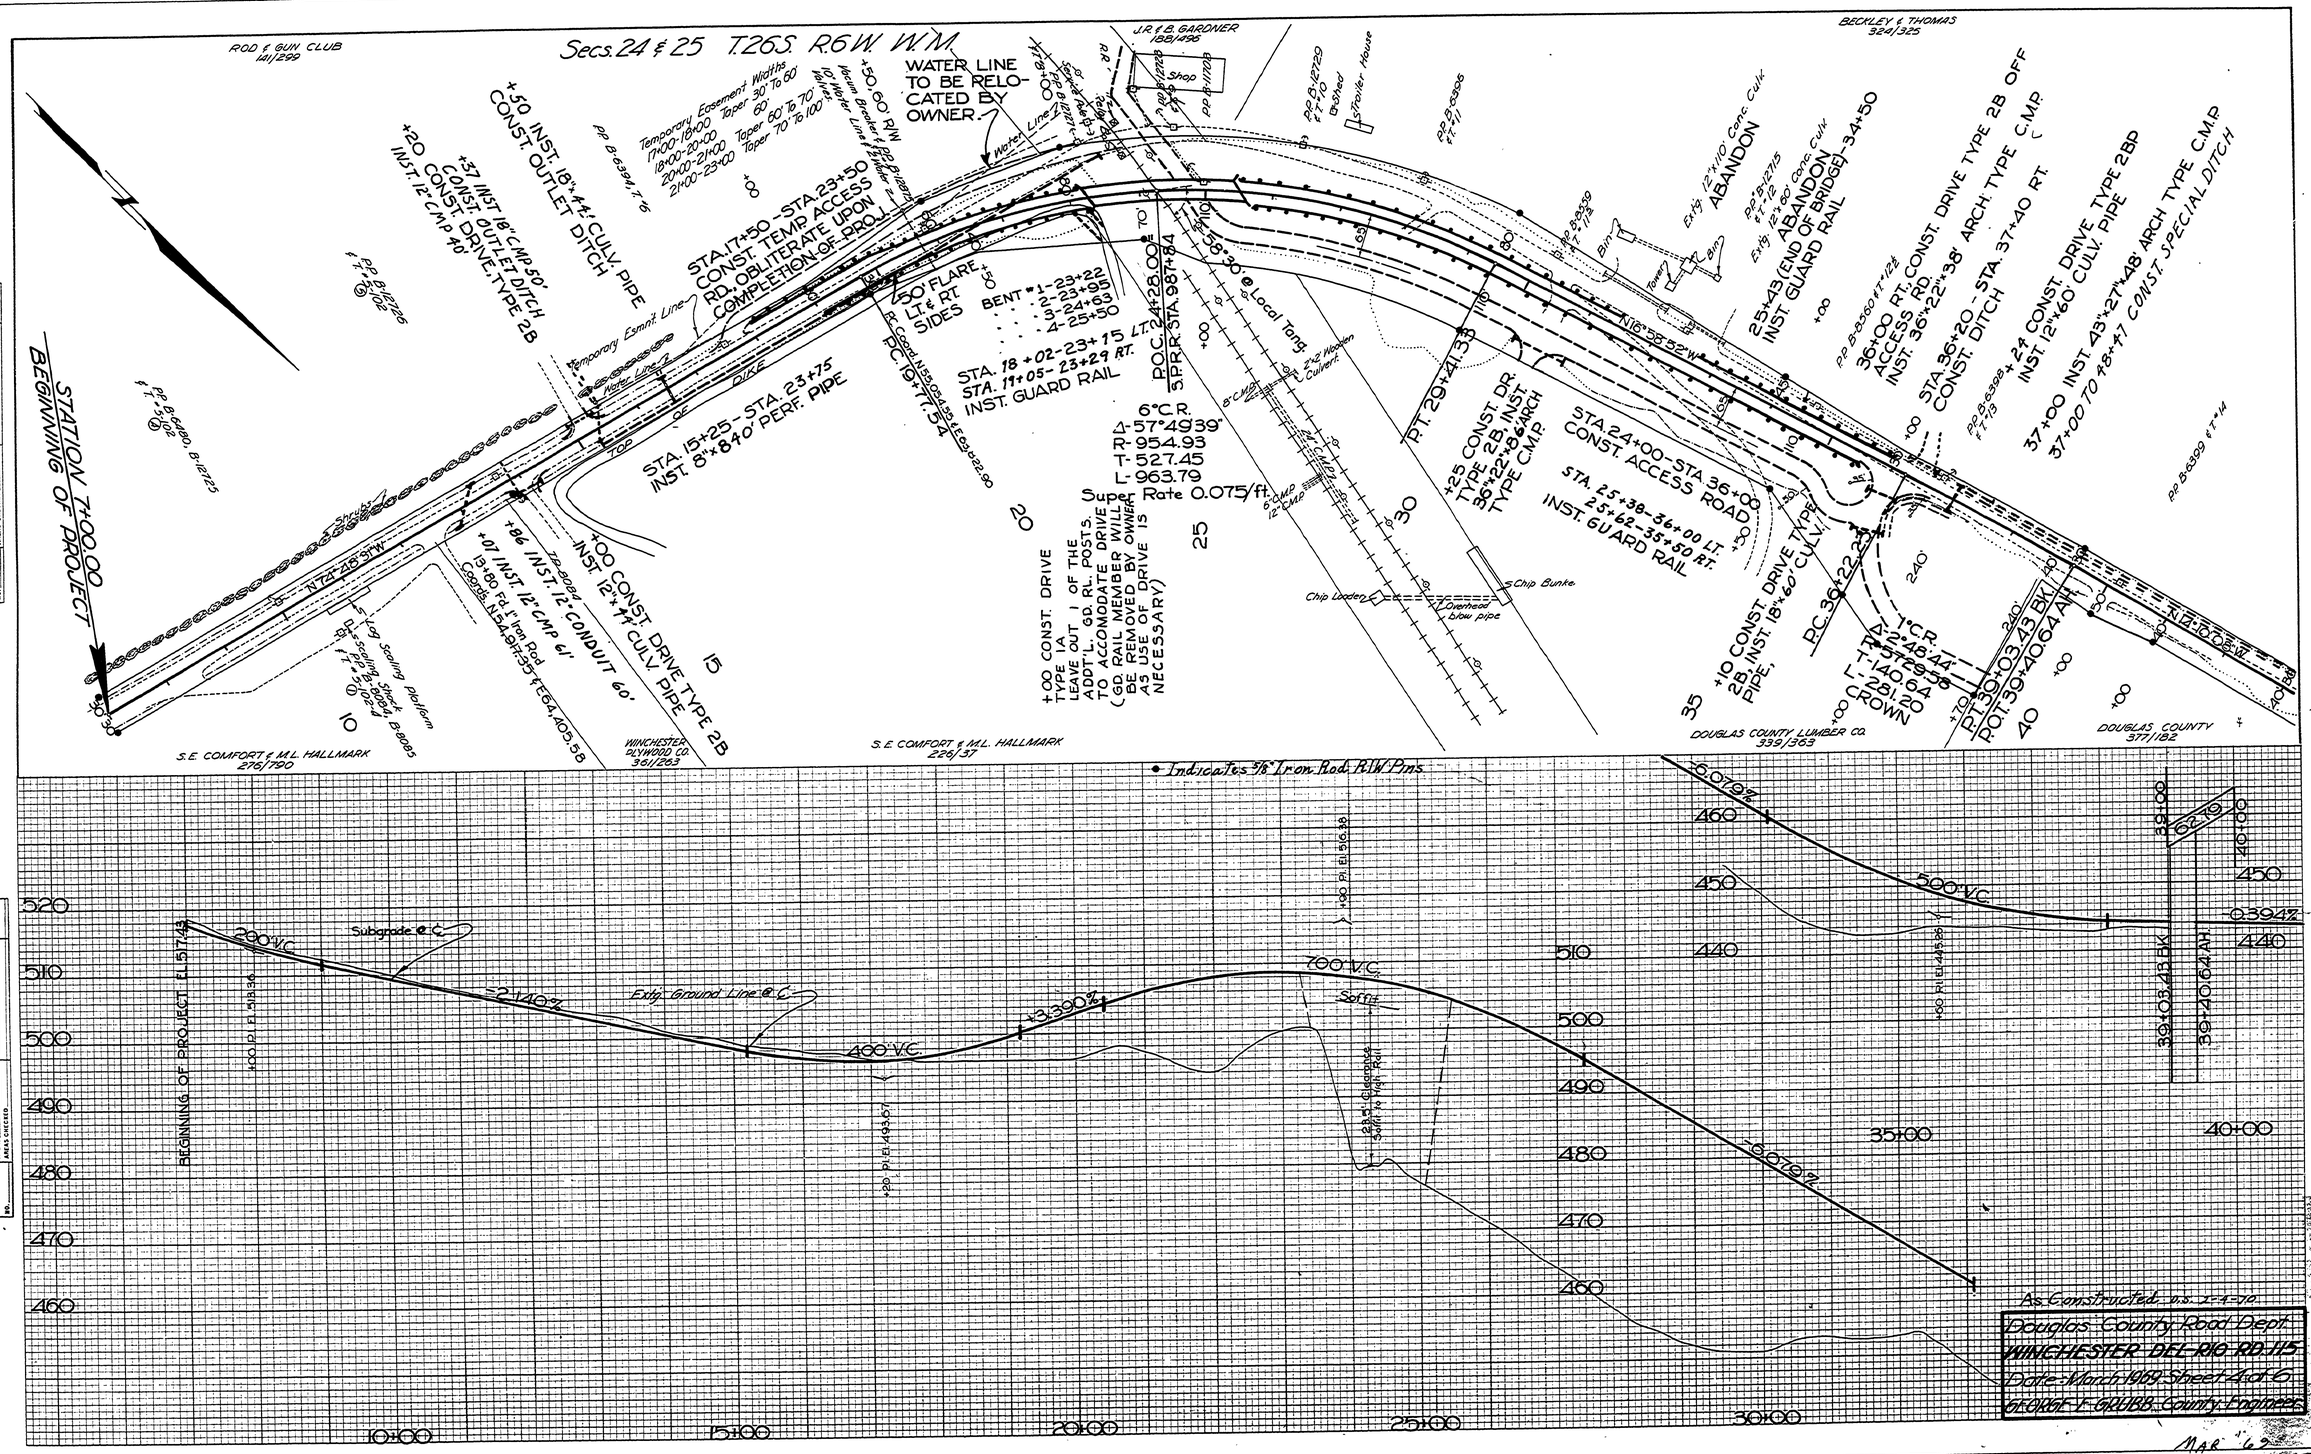

2 4 6 . 2 7 02 M.20 0.14 - 0.77