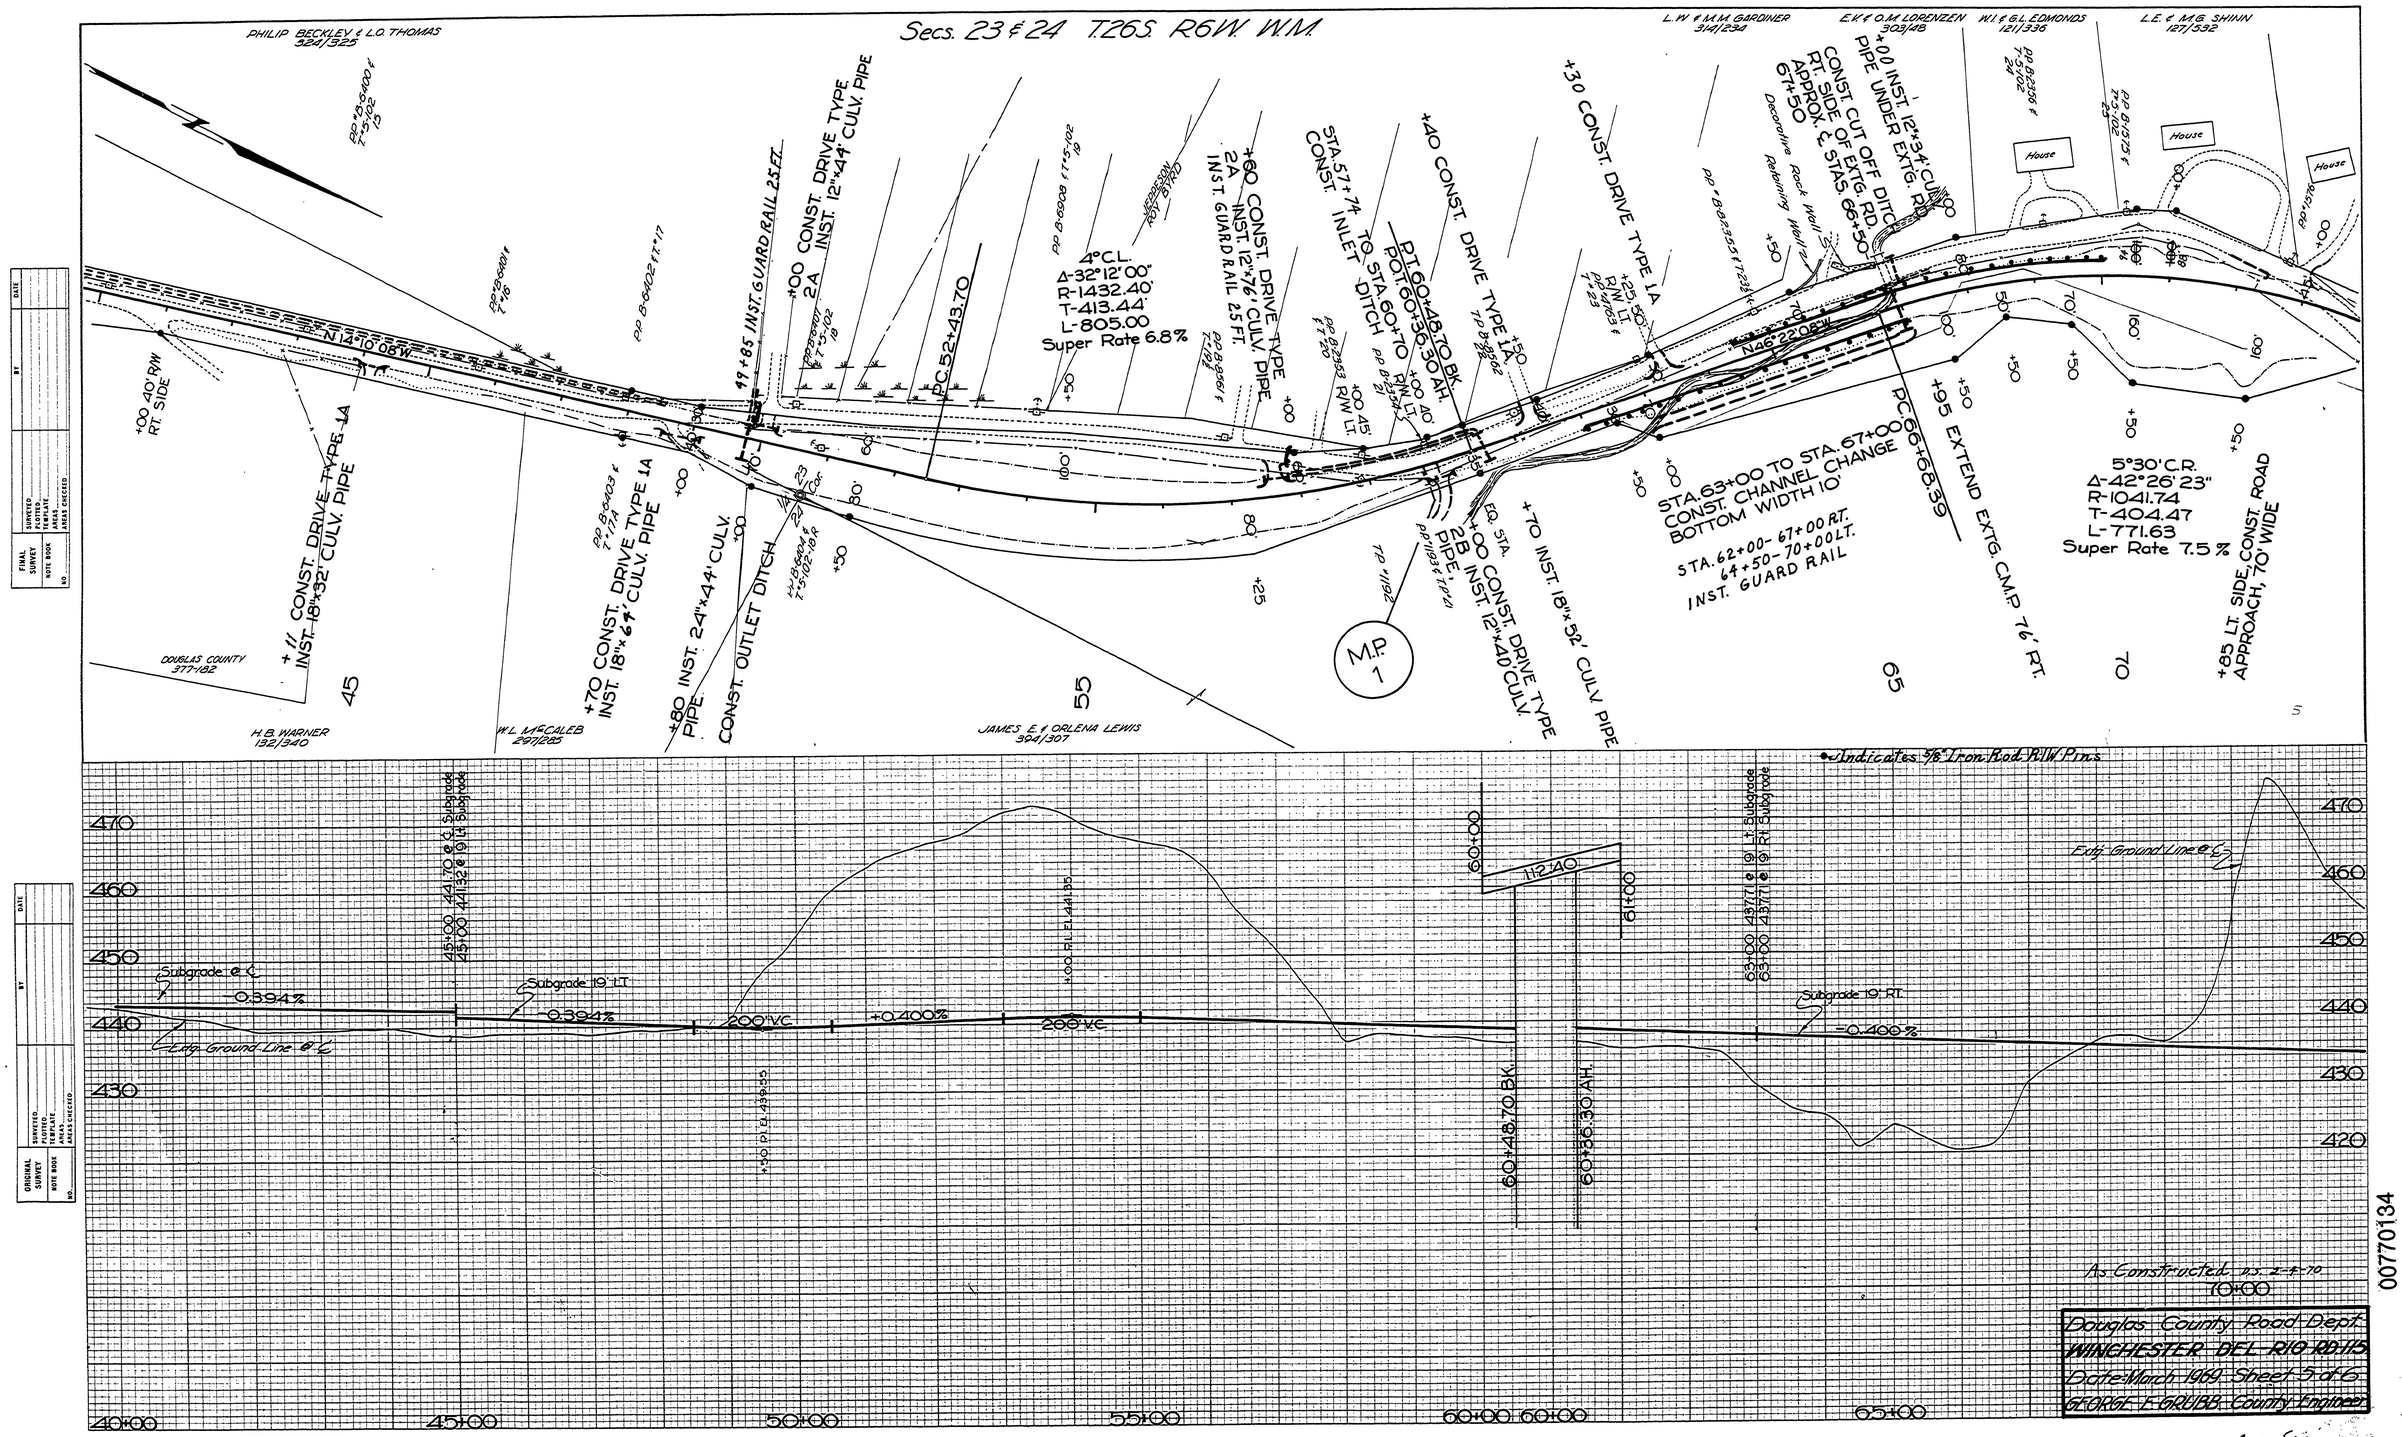

00770134

M.P. 0.77 - 1.34

C. Rd. # 115 Mar. '69 sht. 5 of 6 (44)