DOUGLAS COUNTY OREGON

PLANS FOR PROPOSED PROJECT

AS CONSTRUCTED

PAGE ROAD SECTION

COUNTY ROAD # 115-A

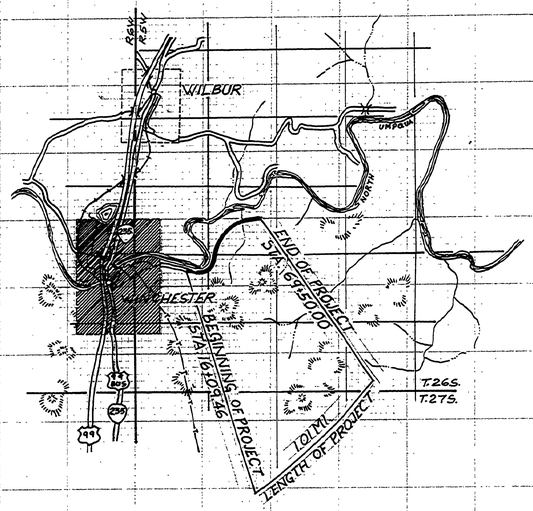

VICINITY MAP

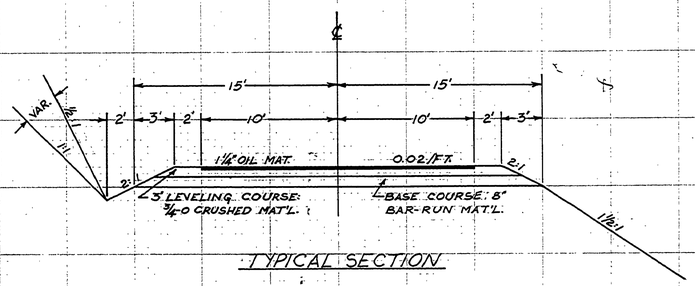

TYPICAL SECTION

REGISTERED PROFESSIONAL ENGINEER
GEORGE E. GRUBB
OREGON
MAY 2, 1958

Approved by Lyle E. Smith Nov. 24, 1964
Asst. Co. Engineer

Adopted by Resolution of the County Court, this 15th day of June 1962

V. T. Jackson
Judge

E. Pintar
Commissioner

Ray Dickson
Commissioner

FILED
RECEIVED
1963
COUNTY SURVEYOR
DOUGLAS COUNTY, ORE.

FILED
RECEIVED
FEB 15 1963
COUNTY SURVEYOR
DOUGLAS COUNTY, ORE.

01490250

no date

Co. Rd. # 115-A