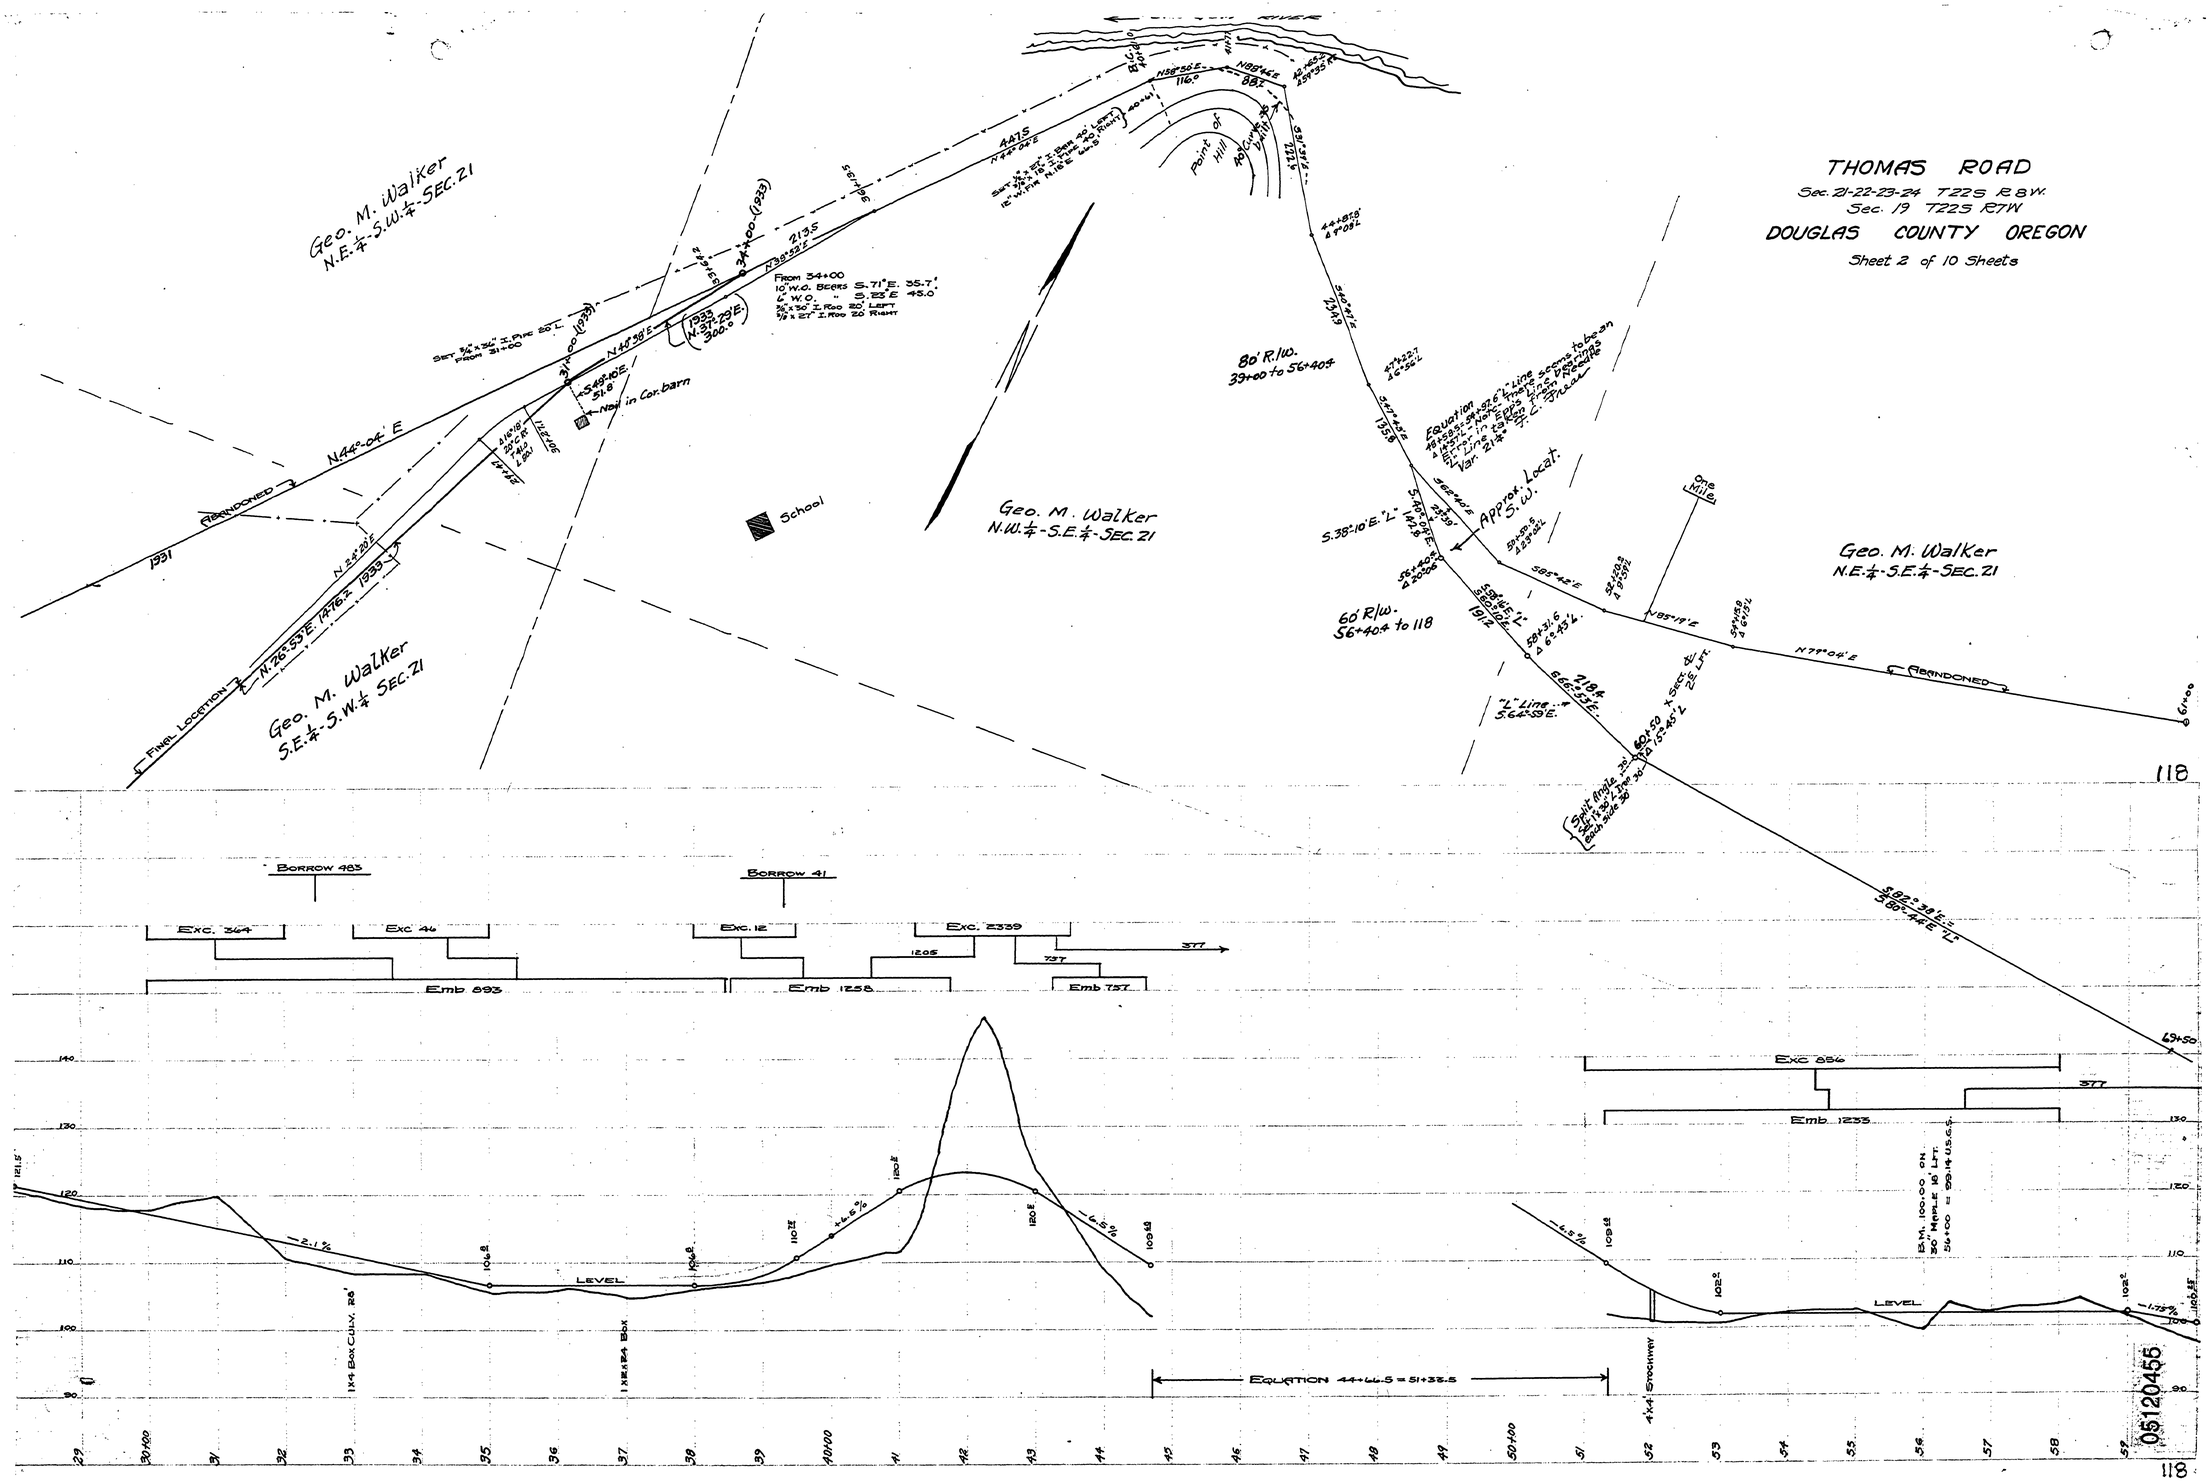

N.M.P. 5.12 - 4.55

T 22-8 S. 21, 22, 23, & 24
T 22-7 S. 19

17