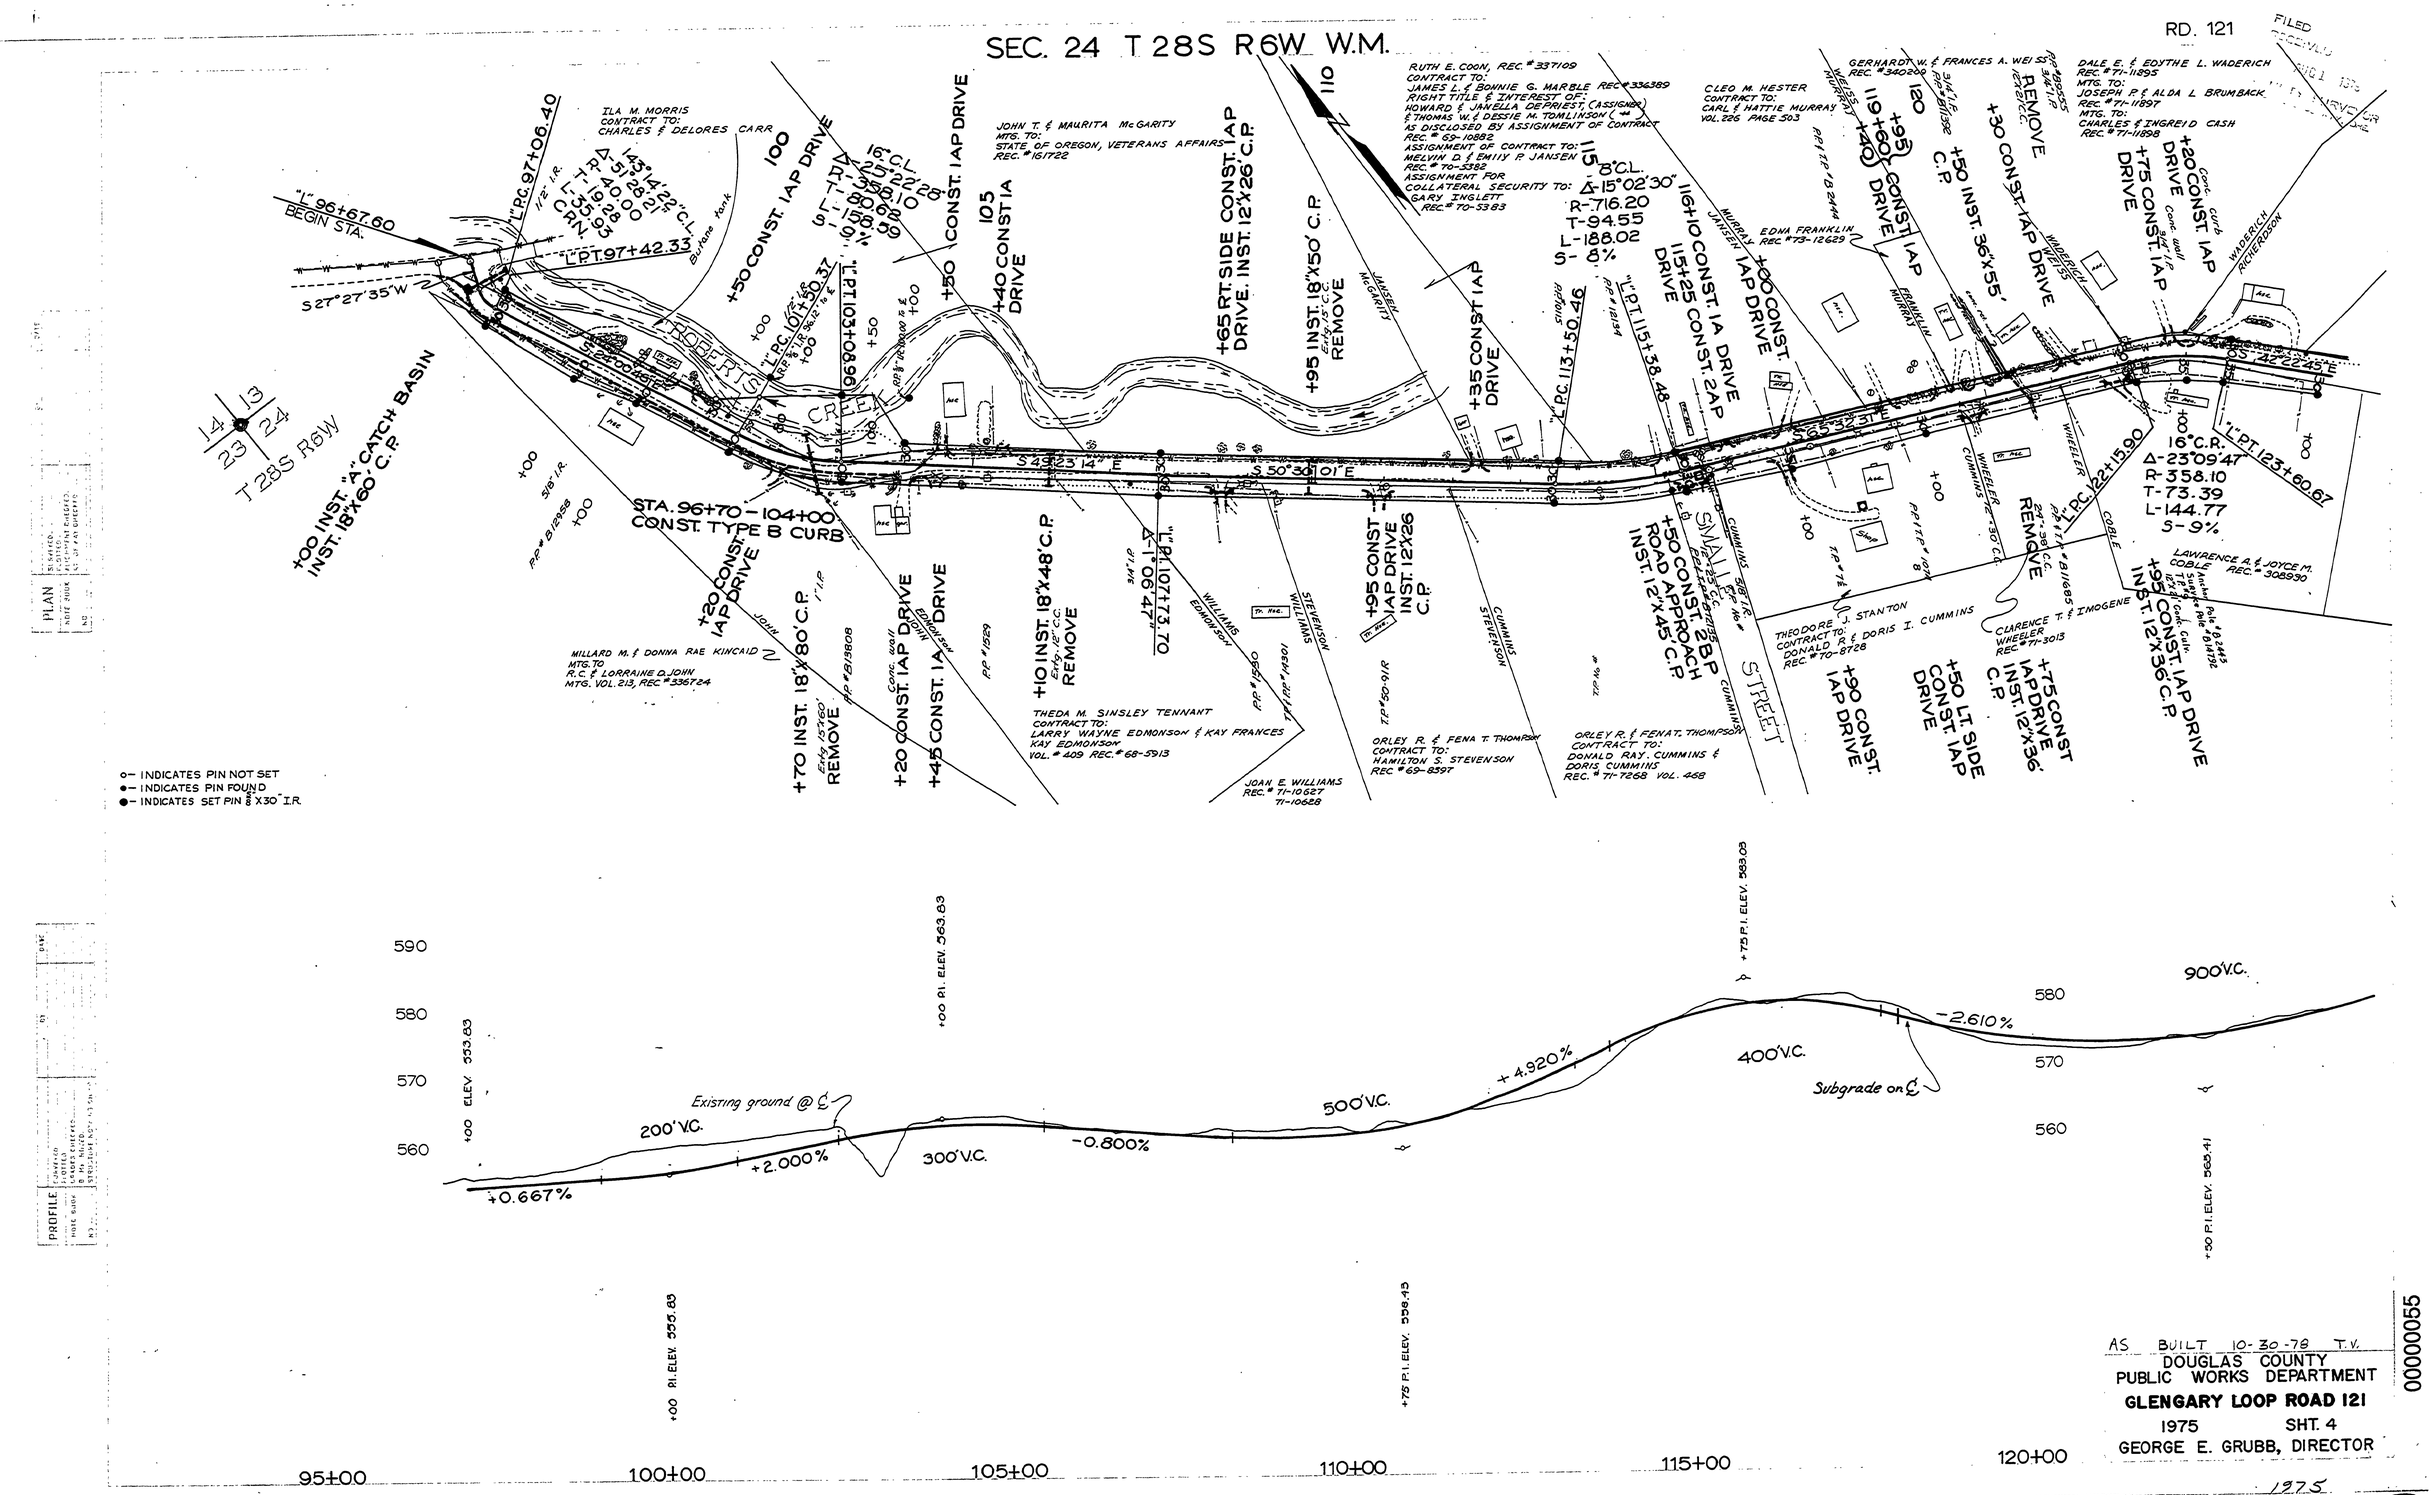
SEC. 24 T 28S R6W W.M.
RD. 121
FILED
"L" 96+67.60 BEGIN STA.
S 27°27'35"W
"L" PC 97+06.40
"L" PT 97+42.33
ILA M. MORRIS CONTRACT TO: CHARLES & DELORES CARR
+50 CONST. IAP DRIVE
"L" PC 101+50.37
"L" PT 103+06.98
+50 CONST. IAP DRIVE
+40 CONST IA DRIVE
JOHN T. & MAURITA McGARITY MTG. TO: STATE OF OREGON, VETERANS AFFAIRS REC. #161722
+65 RT SIDE CONST. IAP DRIVE. INST. 12"X26 C.P.
+95 INST. 18"X50' C.P. Entry 12" C.C. REMOVE
+35 CONST IAP DRIVE
RUTH E. COON, REC. #337109 CONTRACT TO: JAMES L. & BONNIE G. MARBLE REC. #336389 RIGHT TITLE & INTEREST OF: HOWARD & JANELLA DEPRIEST (ASSIGNOR) & THOMAS W. & DESSIE M. TOMLINSON (") AS DISCLOSED BY ASSIGNMENT OF CONTRACT REC. # 69-10882 ASSIGNMENT OF CONTRACT TO: MELVIN D. & EMILY P. JANSEN REC. # 70-5382 ASSIGNMENT FOR COLLATERAL SECURITY TO: GARY INGLETT REC. # 70-5383
CLEO M. HESTER CONTRACT TO: CARL & HATTIE MURRAY VOL. 226 PAGE 503
GERHARDT W. & FRANCES A. WEISS REC. #340220
DALE E. & EDYTHE L. WADERICH REC. #71-11893 MTG. TO: JOSEPH P. & ALDA L. BRUMBACK REC. #71-11897 MTG. TO: CHARLES & INGRED CASH REC. #71-11898
EDNA FRANKLIN REC. #73-12629
"L" PT 115+38.48
+00 CONST. IAP DRIVE
+50 INST. 36"X55'
+30 CONST IAP DRIVE
+20 CONST IAP DRIVE
+75 CONST. IAP DRIVE
+95 CONST. IAP DRIVE INST. 12"X36" C.P.
"L" PT 123+60.67
"L" PC 122+15.90
16° C.R. Δ-23°09'47" R-358.10 T-73.39 L-144.77 S-9%
LAWRENCE A. & JOYCE M. COBLE REC. # 308990
CLARENCE T. & IMOGENE WHEELER REC. # 71-3013
THEODORE J. STANTON CONTRACT TO: DONALD R. & DORIS I. CUMMINS REC. # 70-8728
+90 CONST. IAP DRIVE
+50 LT. SIDE CONST. IAP DRIVE
+75 CONST IAP DRIVE INST. 12"X36" C.P.
+50 CONST. 28P ROAD APPROACH INST. 12"X45" C.P.
SMALLEY STREET
ORLEY R. & FENA T. THOMPSON CONTRACT TO: DONALD RAY. CUMMINS & DORIS CUMMINS REC. # 71-7268 VOL. 468
ORLEY R. & FENA T. THOMPSON CONTRACT TO: HAMILTON S. STEVENSON REC # 69-8397
JOAN E. WILLIAMS REC. # 71-10687 71-10688
THEDA M. SINSLEY TENNANT CONTRACT TO: LARRY WAYNE EDMONSON & KAY FRANCES KAY EDMONSON VOL. # 409 REC. # 68-5913
MILLARD M. & DONNA RAE KINCAID MTG. TO R.C. & LORRAINE D. JOHN MTG. VOL. 213, REC. # 335724
+70 INST. 18"X80' C.P. Entry 15"60' REMOVE
+20 CONST. IAP DRIVE
+45 CONST. IA DRIVE
+10 INST. 18"X48' C.P. Entry 12" C.C. REMOVE
+95 CONST IAP DRIVE INST. 12"X26 C.P.
+00 INST. "A" CATCH BASIN INST. 18"X60" C.P.
STA. 96+70 - 104+00 CONST. TYPE B CURB
ROBERTS CREEK
S 49°23'14" E
S 50°30'01" E
S 65°32'31" E
S 22°22'45" E
T 28S R6W
14 13 23 24
o— INDICATES PIN NOT SET
●— INDICATES PIN FOUND
●— INDICATES SET PIN & X30" I.R.
590
580
570
560
+00 ELEV. 553.83
+00 PI. ELEV. 563.83
+75 P.I. ELEV. 563.03
+30 P.I. ELEV. 562.41
+00 PI. ELEV. 555.83
+75 P.I. ELEV. 558.43
Existing ground @ ℄
200' V.C.
+0.667%
+2.000%
300' V.C.
-0.800%
500' V.C.
+4.920%
400' V.C.
Subgrade on ℄
-2.610%
900' V.C.
95+00
100+00
105+00
110+00
115+00
120+00
M.P. 0.00-0.54
AS BUILT 10-30-78 T.V.
DOUGLAS COUNTY
PUBLIC WORKS DEPARTMENT
GLENGARY LOOP ROAD 121
1975 SHT. 4
GEORGE E. GRUBB, DIRECTOR
00000055
Co. Rd. #121
1975
sht. 4 of 8
(92)