MP 2

SEC. 19 T28S R5W W.M.

RD. 121

FILED
RECEIVED
AUG 1 1979
COUNTY SURVEYOR
DOUGLAS COUNTY, ORE.

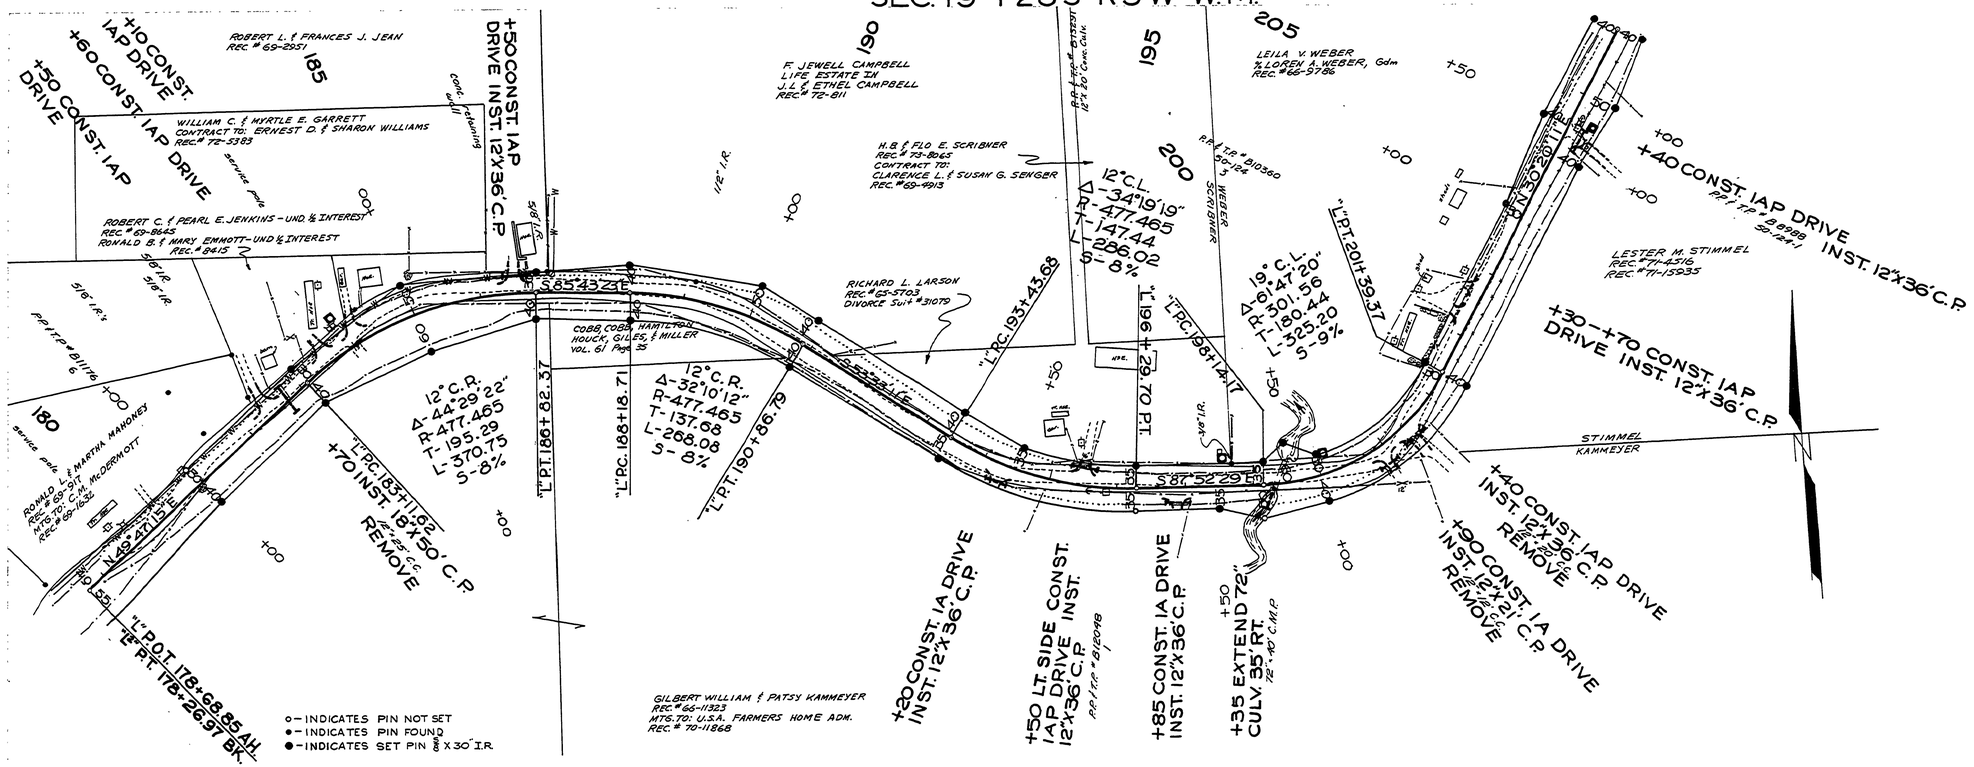

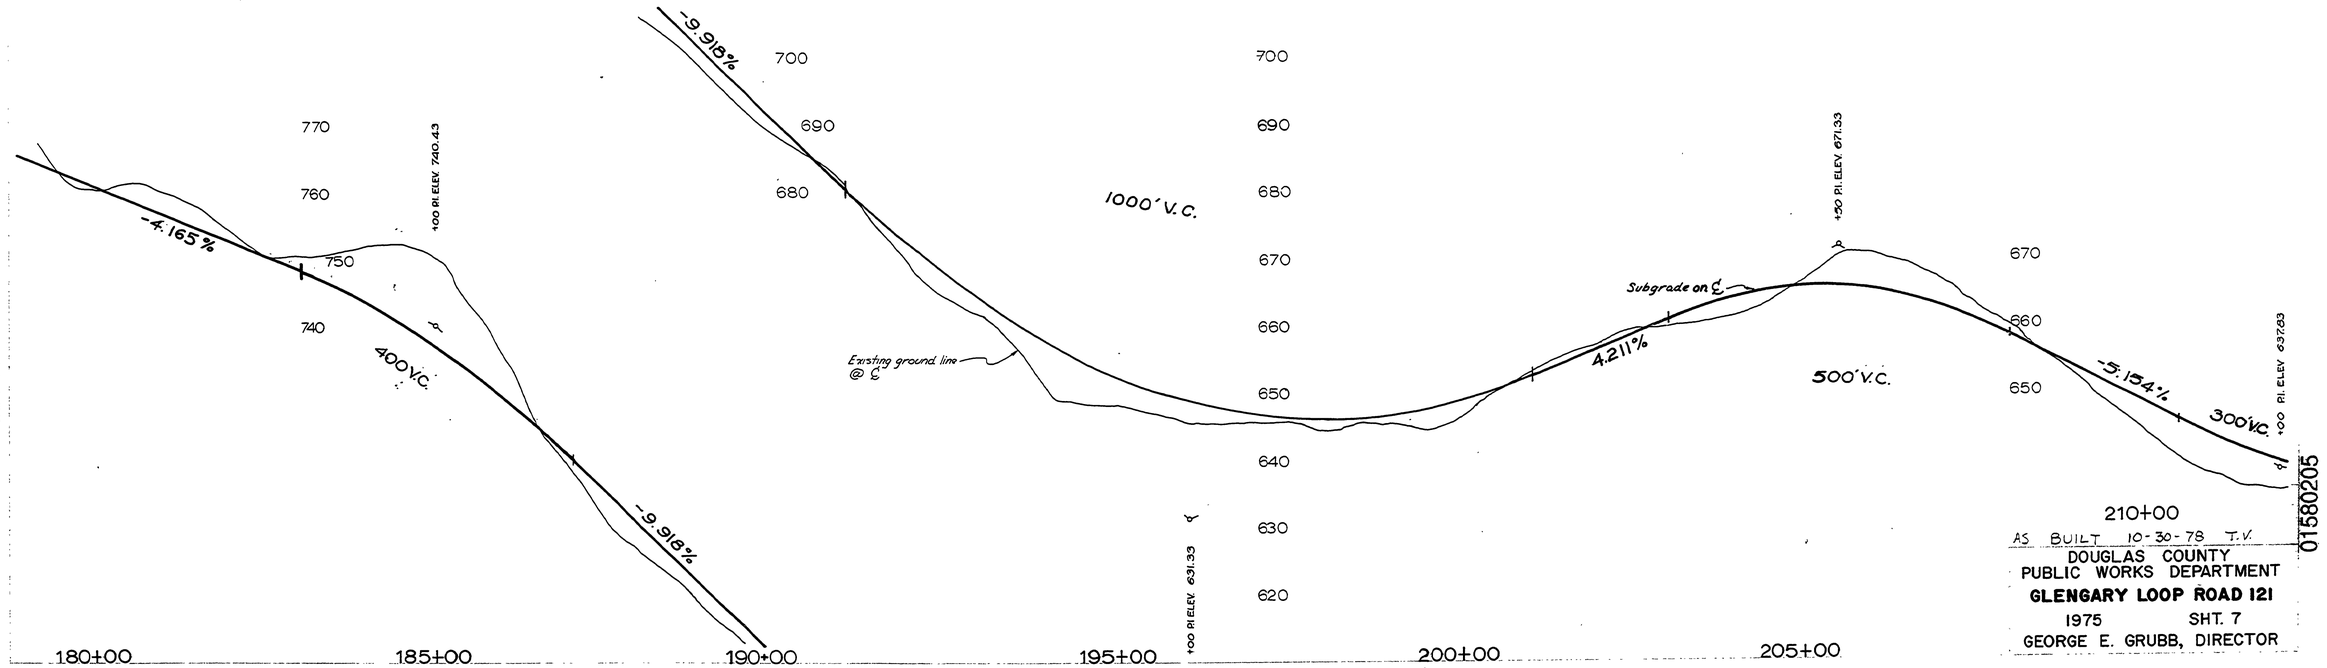

AS BUILT 10-30-78 T.V.

DOUGLAS COUNTY
PUBLIC WORKS DEPARTMENT
GLENGARY LOOP ROAD 121
1975 SHT. 7
GEORGE E. GRUBB, DIRECTOR

01580205

M.P. 1.58 - 2.05

Co. Rd. #121 1975 sht. 7 of 8

102