FILED
RECEIVED
MAY 22 1968
COUNTY SURVEYOR

HERMANS SECOND SUBDIVISION SEC 27 T29S R5W WM

SOUTH MYRTLE CO RD #18

STATION 0+00 BEGIN PROJECT

BLOCK 9 — BLOCK 5 — BLOCK 8

EAST BROADWAY — BOND ST — JOHNSON ST — JOHNSON LANE

Construct Type "B" Concrete Curbs 3416 Lin. Ft.

END OF PROJECT STATION 15+12.56

LAMPERT'S SUBDIVISION

SOUTH MYRTLE CUTOFF, CO RD #184

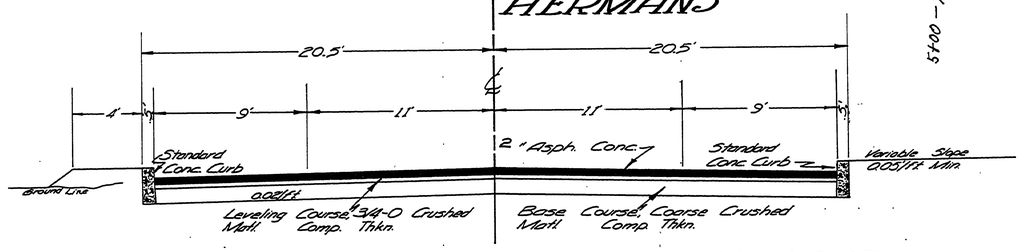

TYPICAL SECTION FOR NEAL LANE

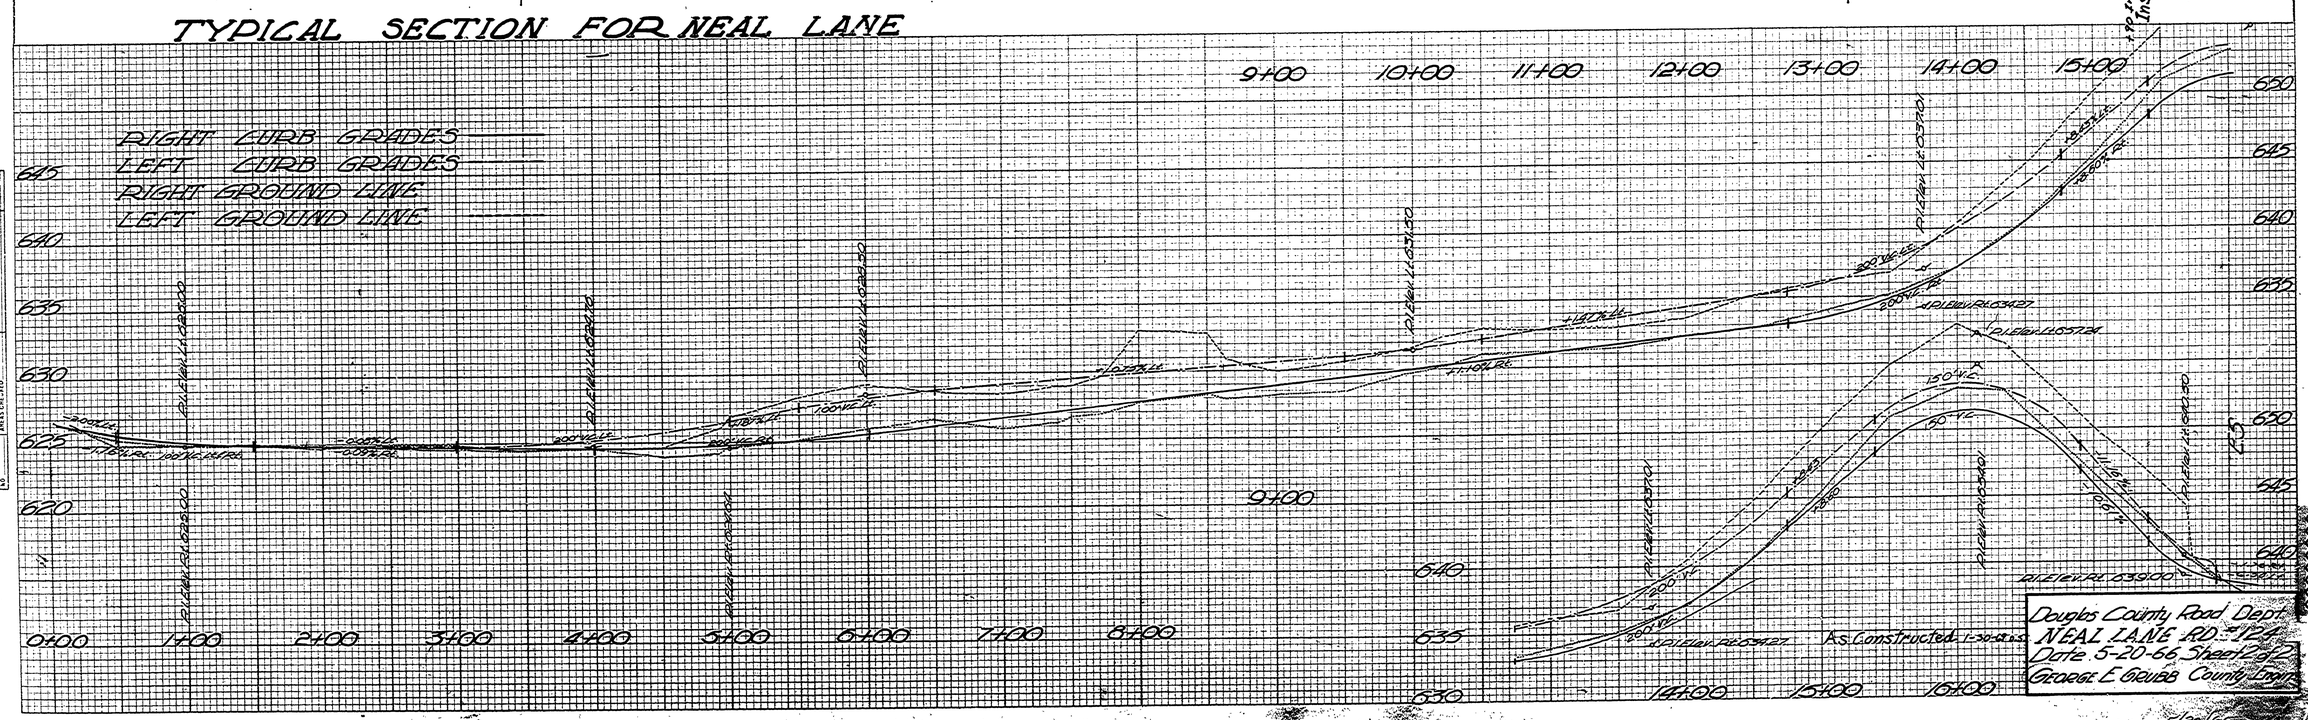

Douglas County Road Dept.
NEAL LANE RD. #124
Date 5-20-66 Sheet 2 of 2
George E. Grubb County Engr.

REGISTERED PROFESSIONAL ENGINEER 4250 OREGON MAY 2, 1968 GEORGE E. GRUBB

FINAL SURVEY	SURVEYED	BY	DATE
	PLOTTED		
	TEMPLATE		
NOTE BOOK	AREAS		
NO.	AREAS CHECKED		

ORIGINAL SURVEY	SURVEYED	BY	DATE
	PLOTTED		
	TEMPLATE		
NOTE BOOK	AREAS		
NO.	AREAS CHECKED		

M.P. 0+00 - 0.30

00000039