SEC 25, 26 & 35 T28S R7W W.M.

RD 125

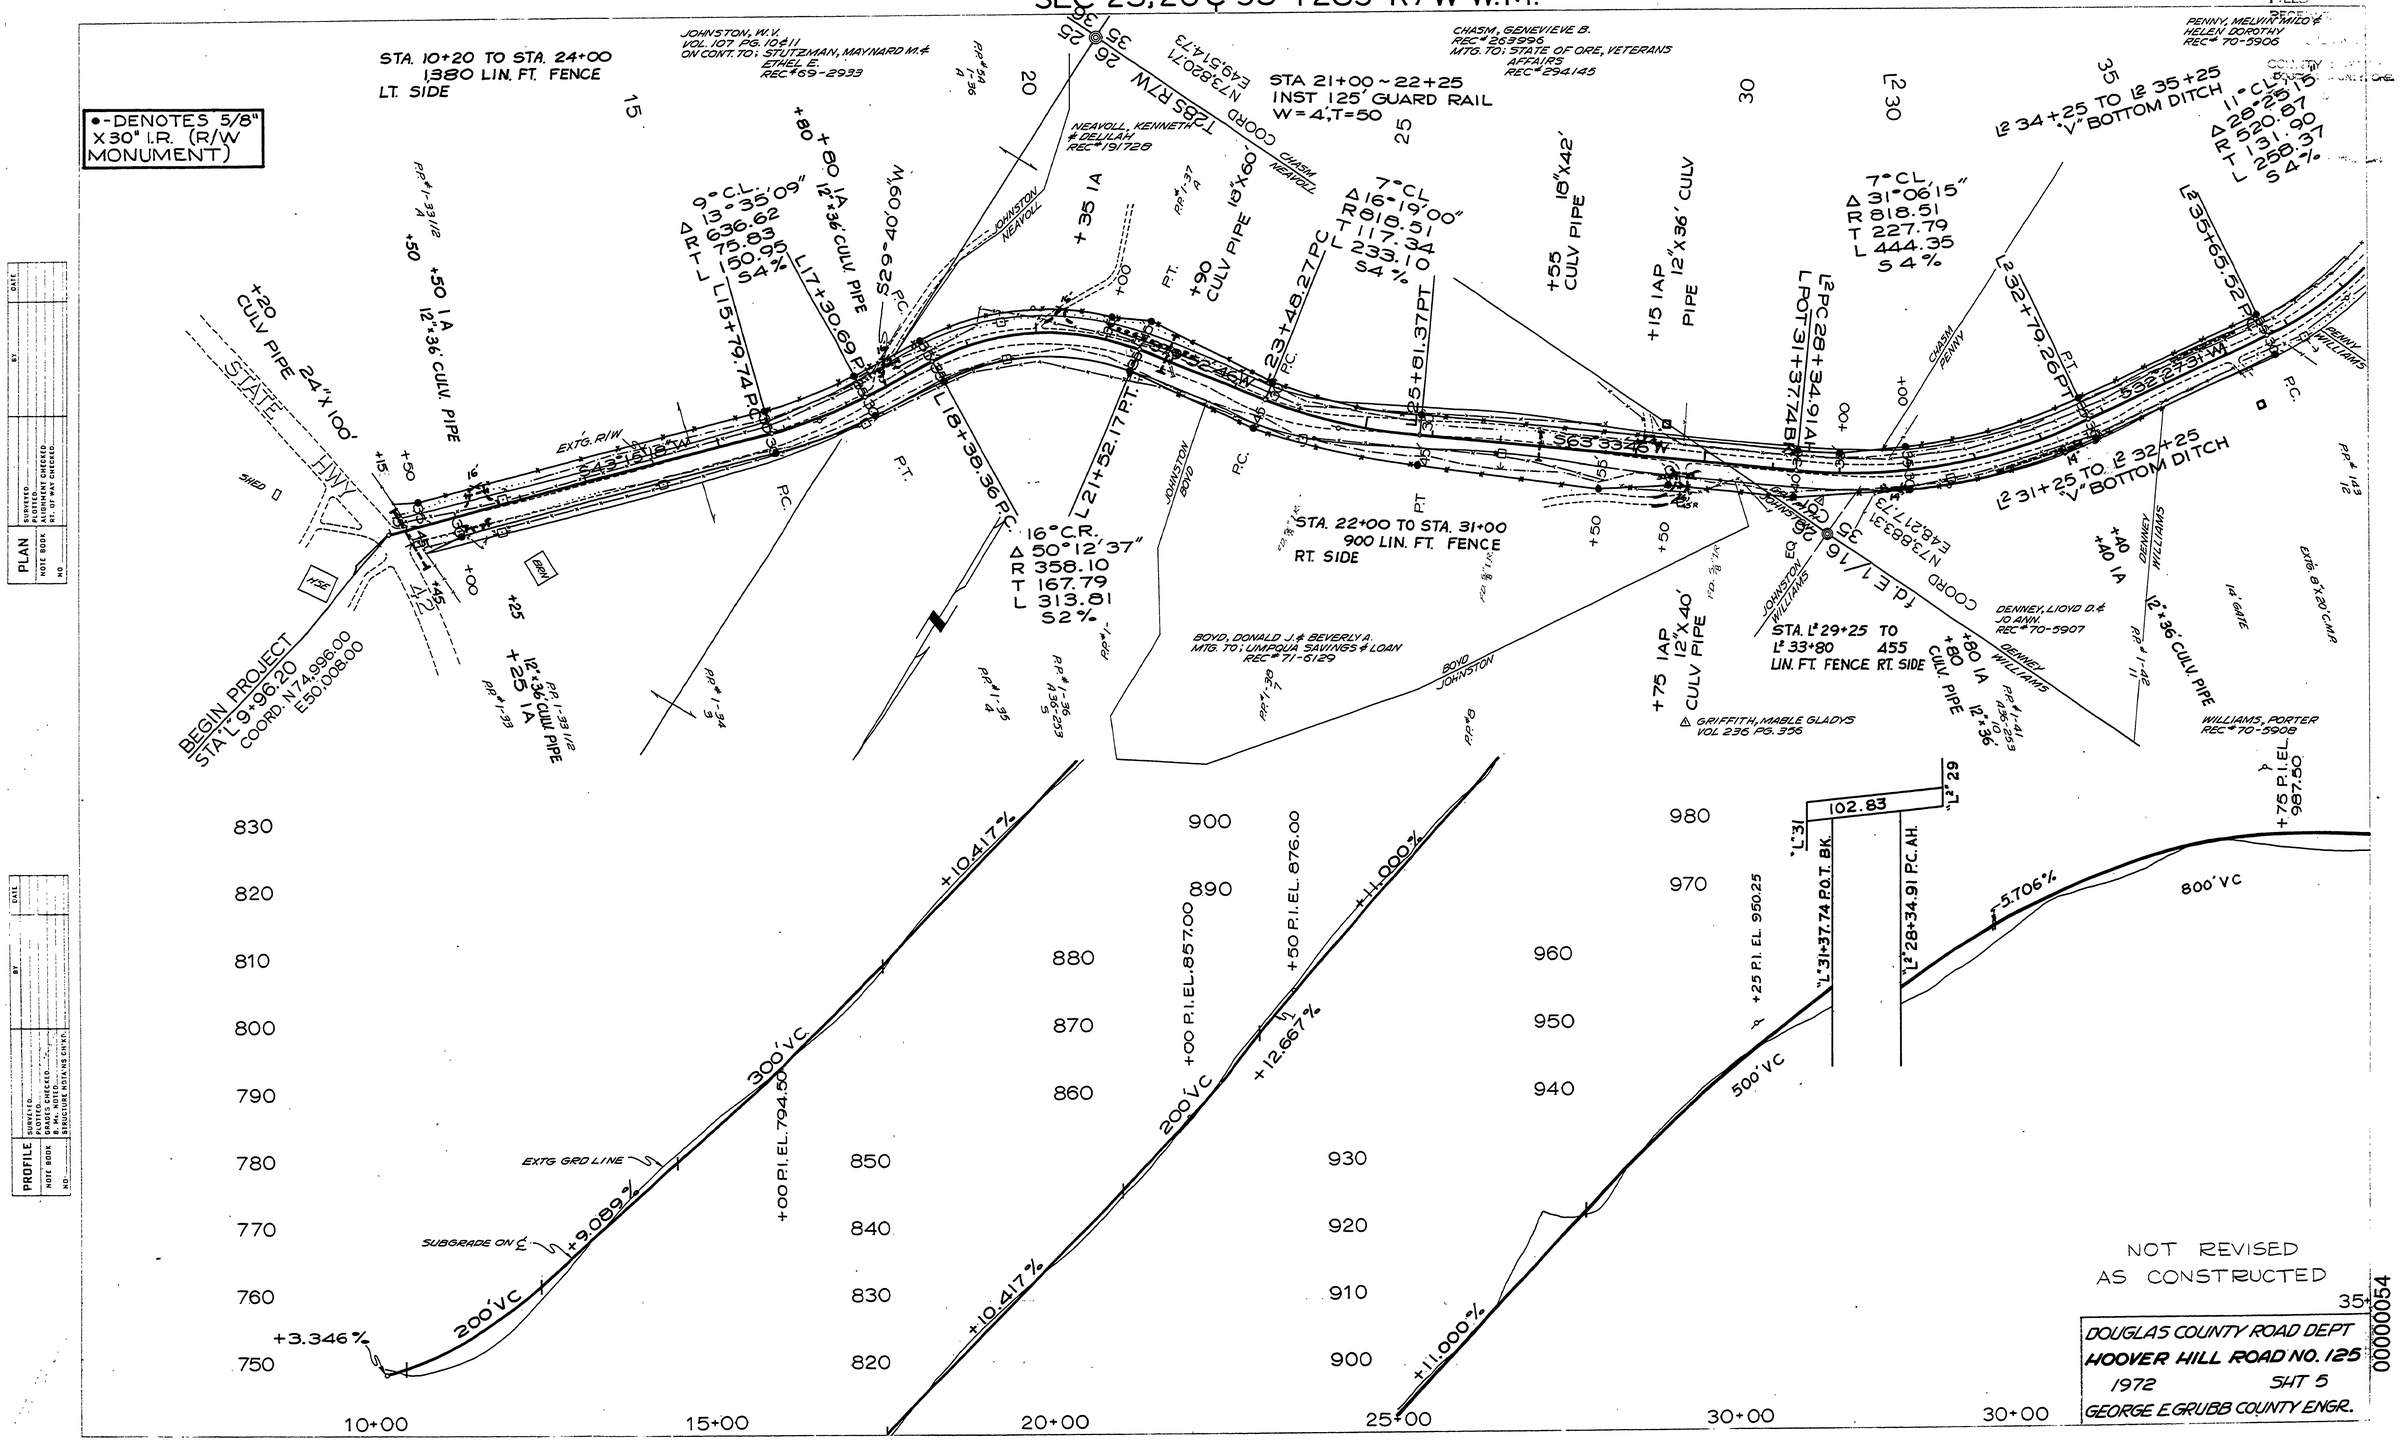

M.P. 0.00 - 0.54

Co. Rd. #125 1972 sht. 5 of 8 (108)