SEC 35 T28S R7W W.M.

M.P. 1

RD 125

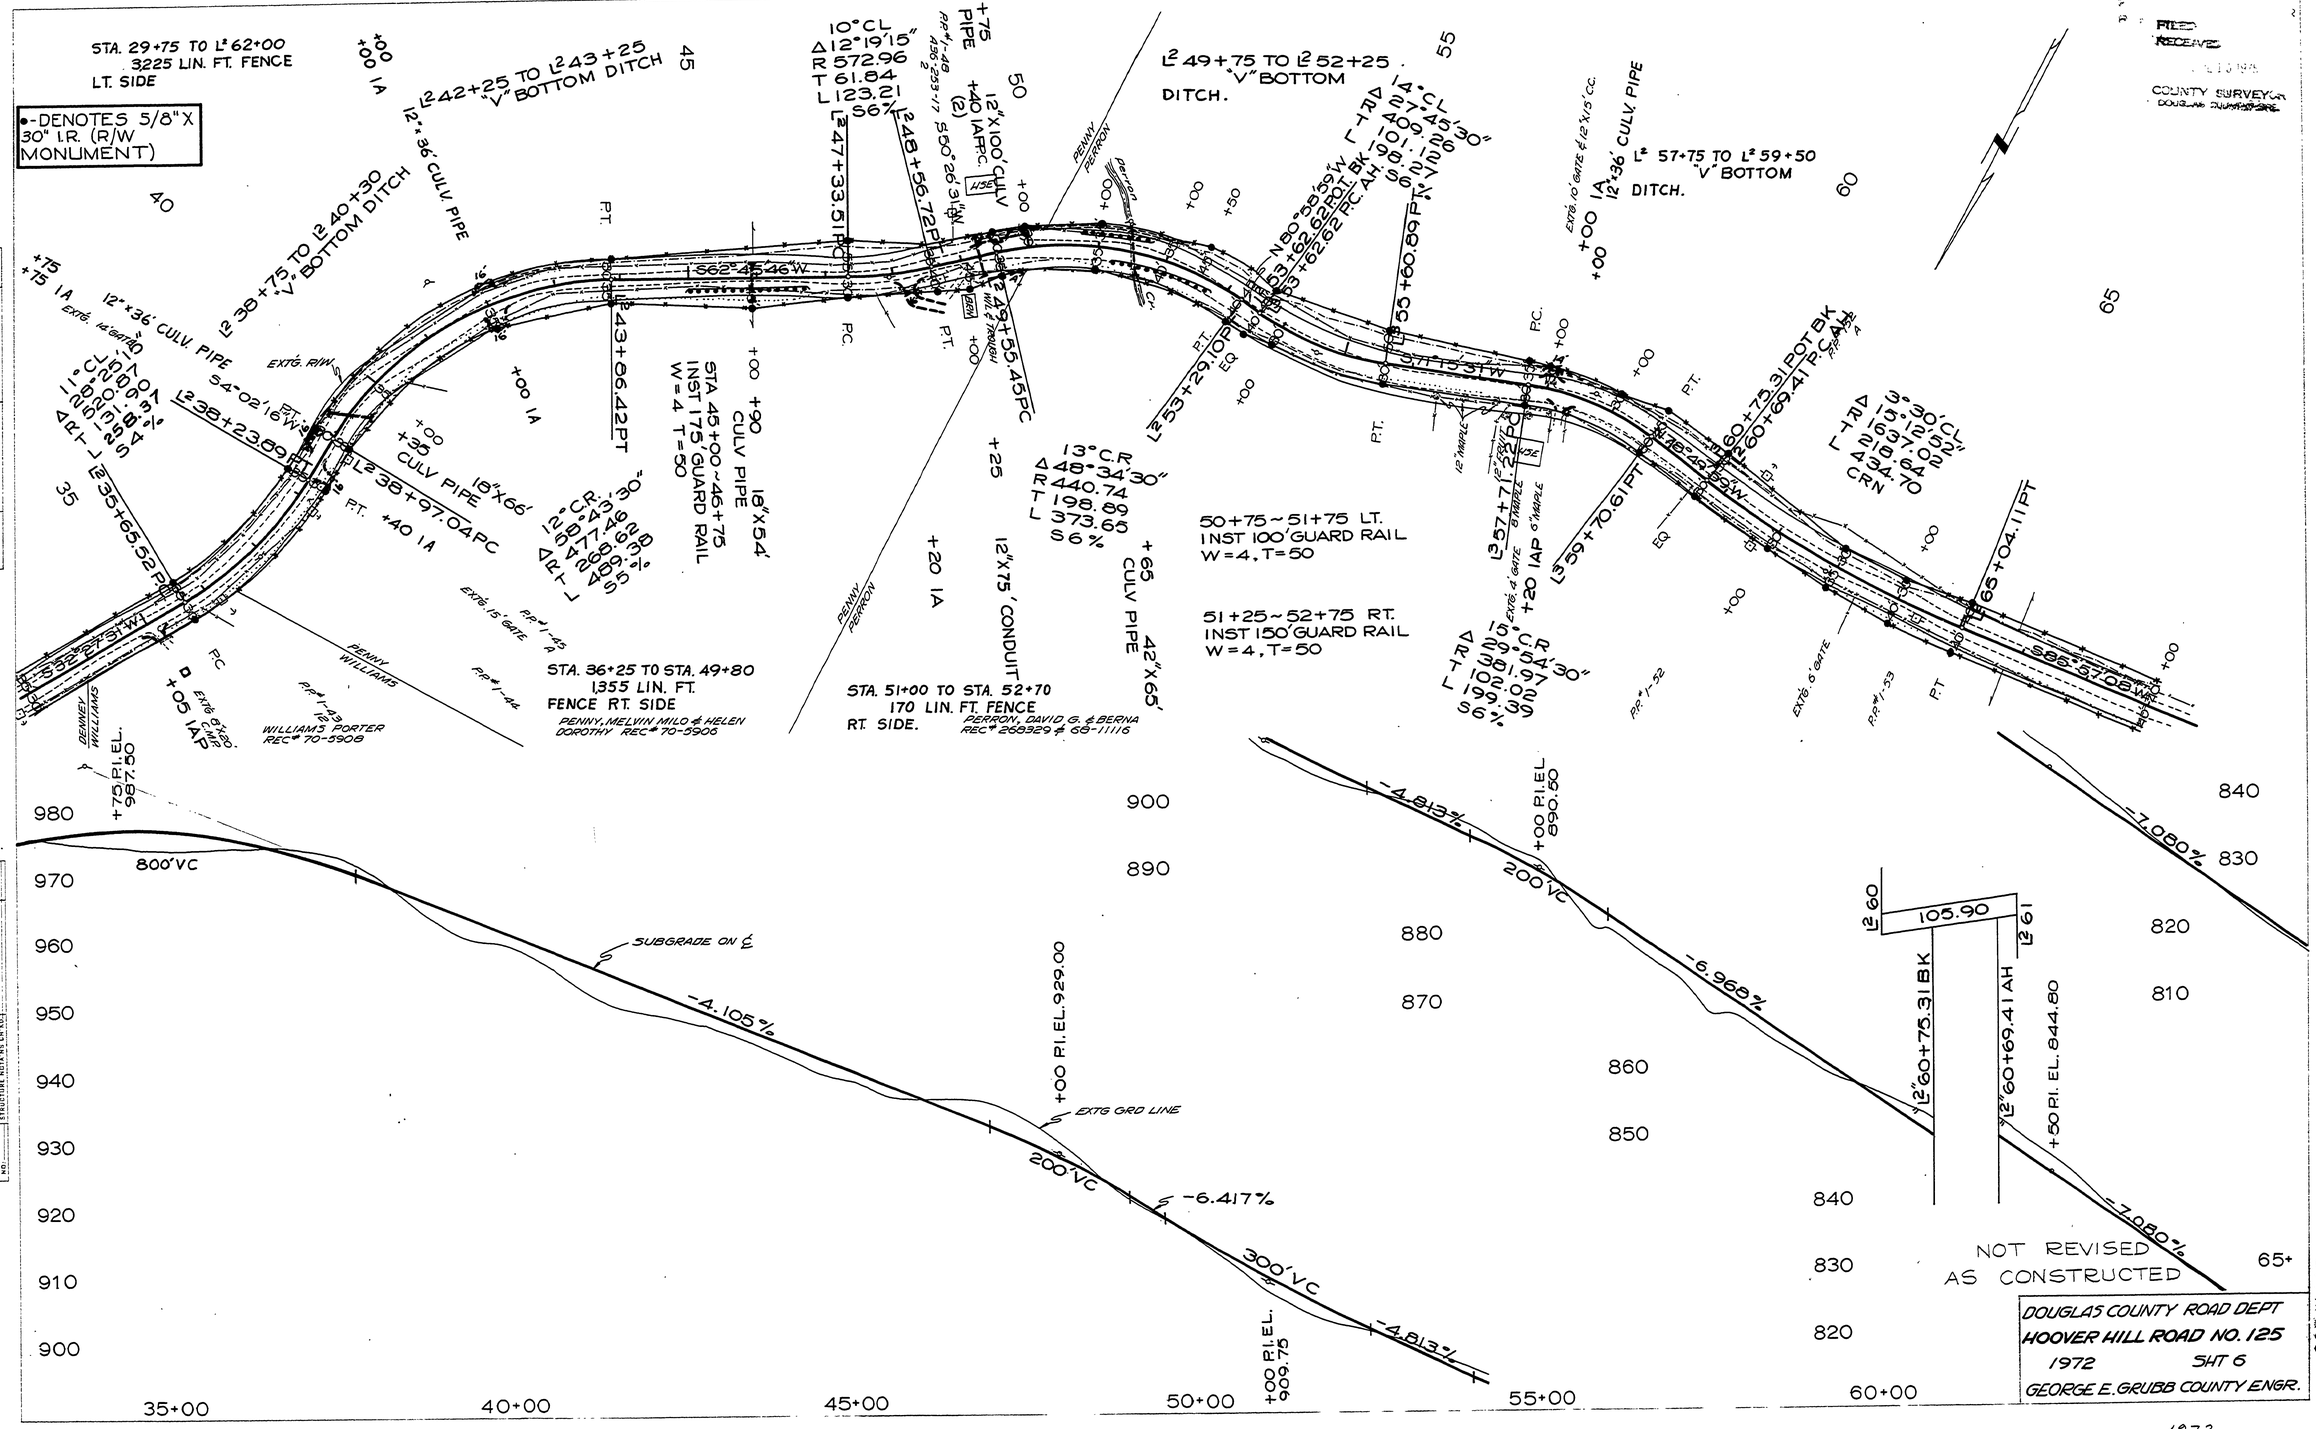

M.P. 0.54 - 1.15

Co. Rd #125 1972 sht. 6 of 8