SEC 34,35 T28S R7W W.M.

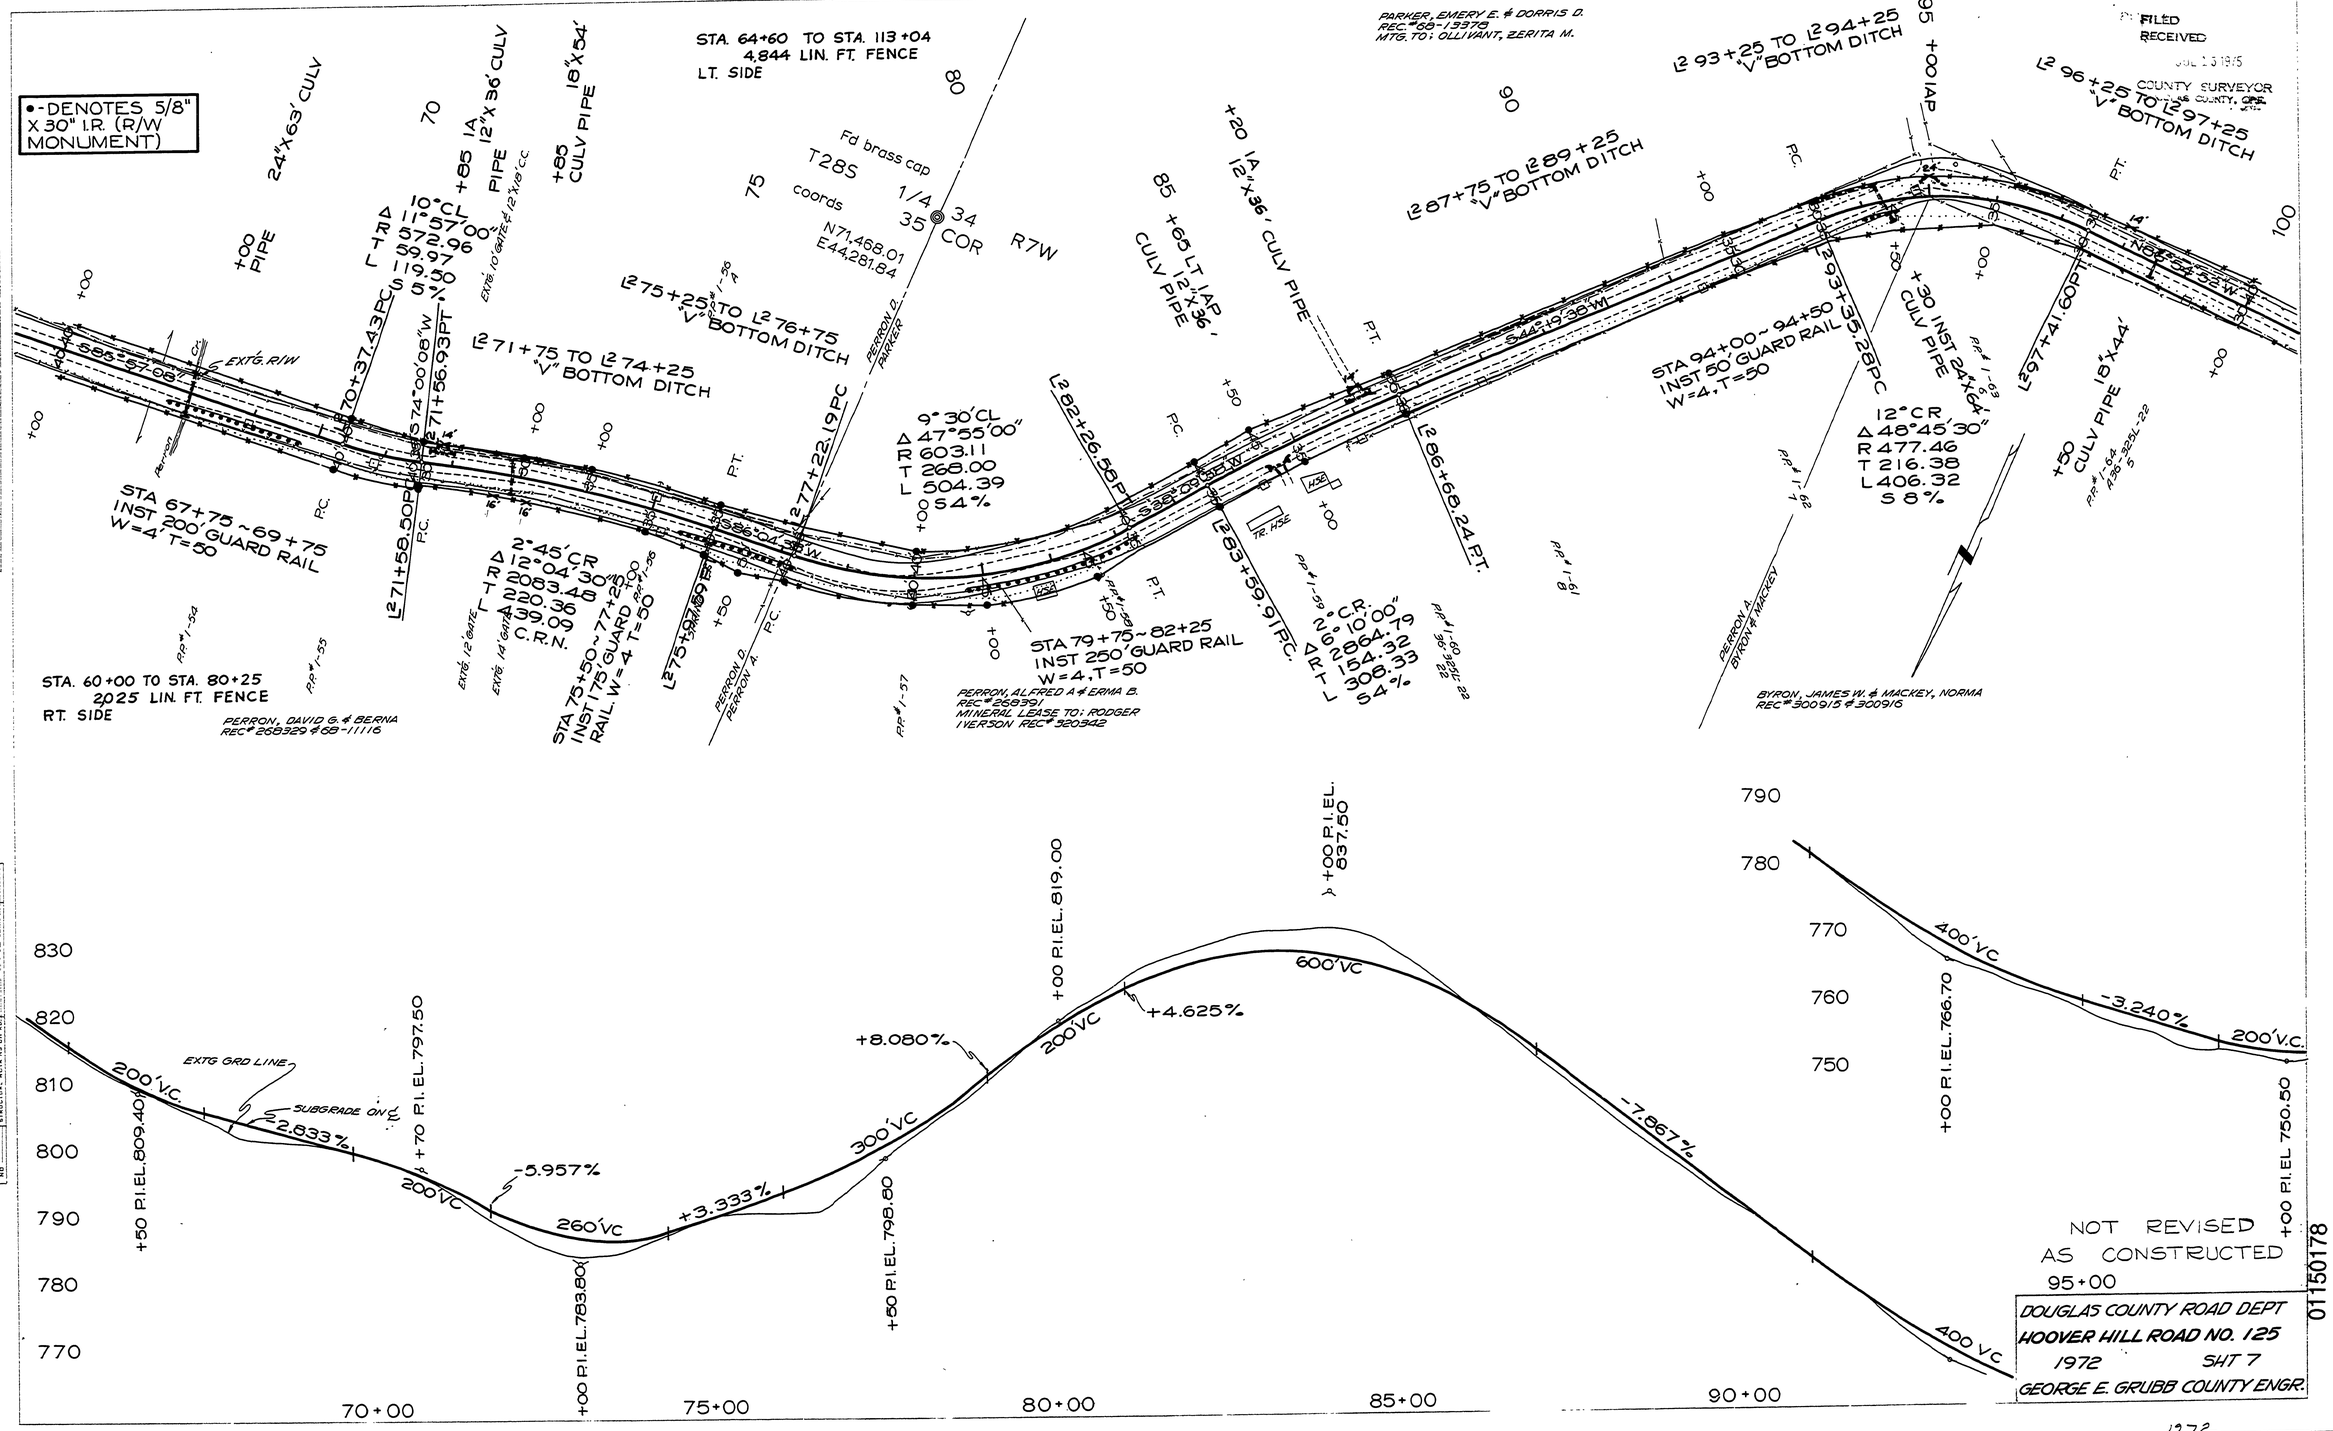

NOT REVISED
AS CONSTRUCTED

DOUGLAS COUNTY ROAD DEPT
HOOVER HILL ROAD NO. 125
1972 SHT 7
GEORGE E. GRUBB COUNTY ENGR.

01150178

M.P. 1.15-1.78

1972
Co. Rd #125 sht. 7 of 8