SEC. 9 T.26 S.. R.3 W.. W.M.

FILED
APR 12 1988
COUNTY SURVEYOR
DOUGLAS COUNTY, ORE.

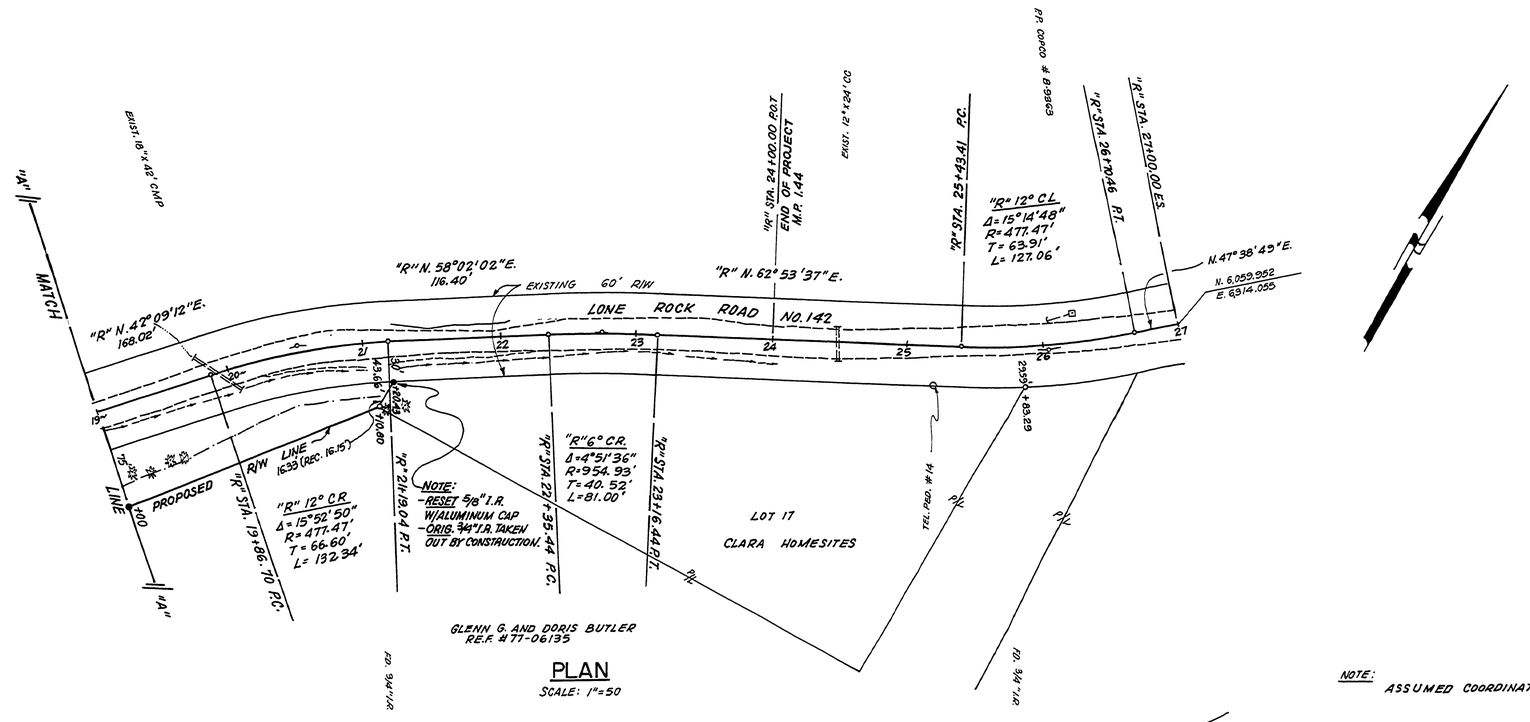

PLAN
SCALE: 1"=50

NOTE: ASSUMED COORDINATES USED

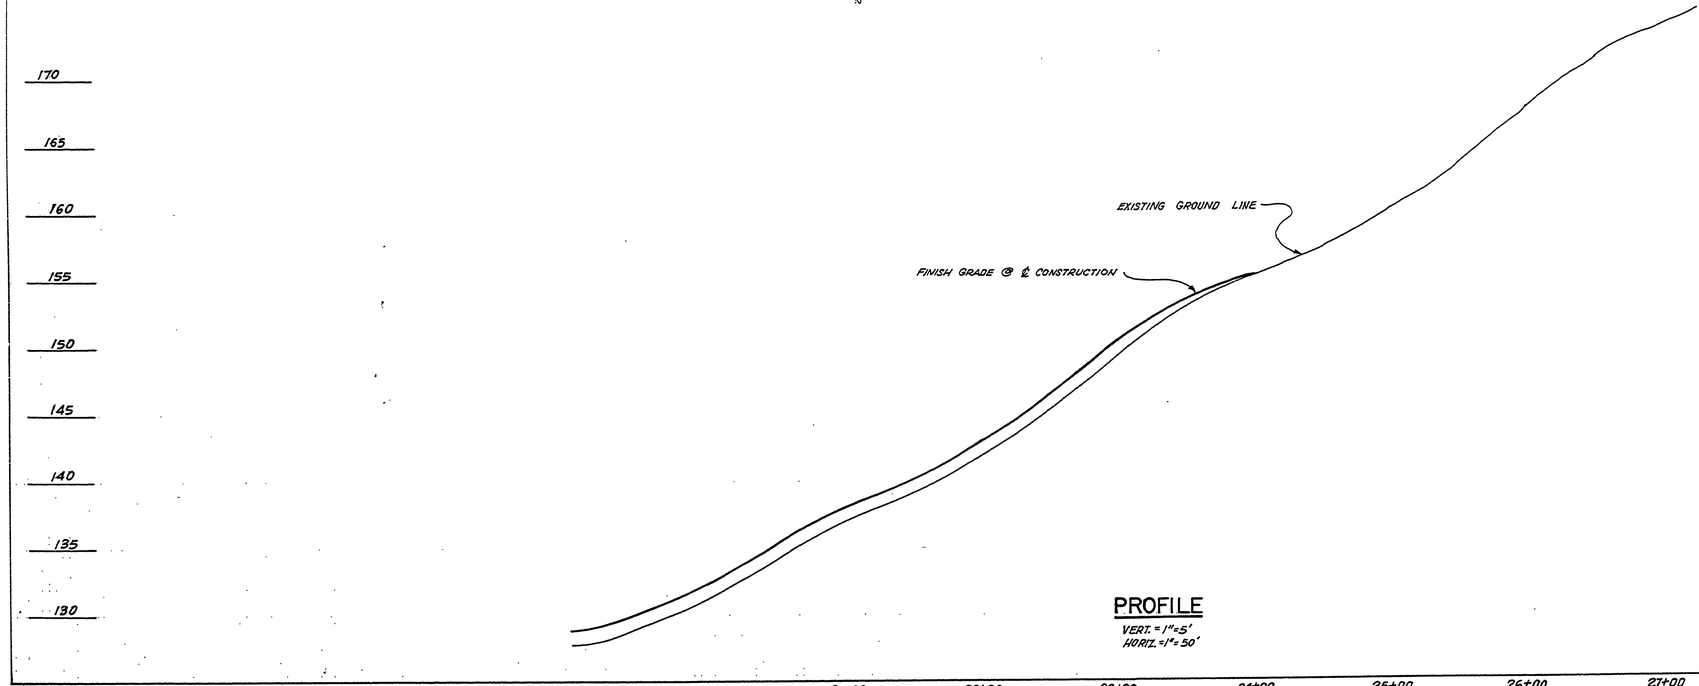

PROFILE
VERT. = 1"=5'
HORIZ. = 1"=50'

REGISTERED PROFESSIONAL ENGINEER — OREGON — APR. 21, 1978 — KENNETH LEROY ERICKSON

REGISTERED PROFESSIONAL LAND SURVEYOR — OREGON — WARREN H. POLAND

REVISIONS		
Engr.	Drawn	Checked
K	JLR	DDS
Approval Recommended: Warren H. Poland		

DOUGLAS COUNTY
COUNTY ENGINEER DEPARTMENT
LONE ROCK ROAD NO.142
PLAN AND PROFILE
M.P. 1.12 TO M.P. 1.44
K.L. ERICKSON, COUNTY ENGINEER

Date	Scale	Drwg. No.
MAR., 1988	AS SHOWN	2/2

01290144

M.P. 1.29 - 1.44

Rd #142 sheet 2 of 2

1208