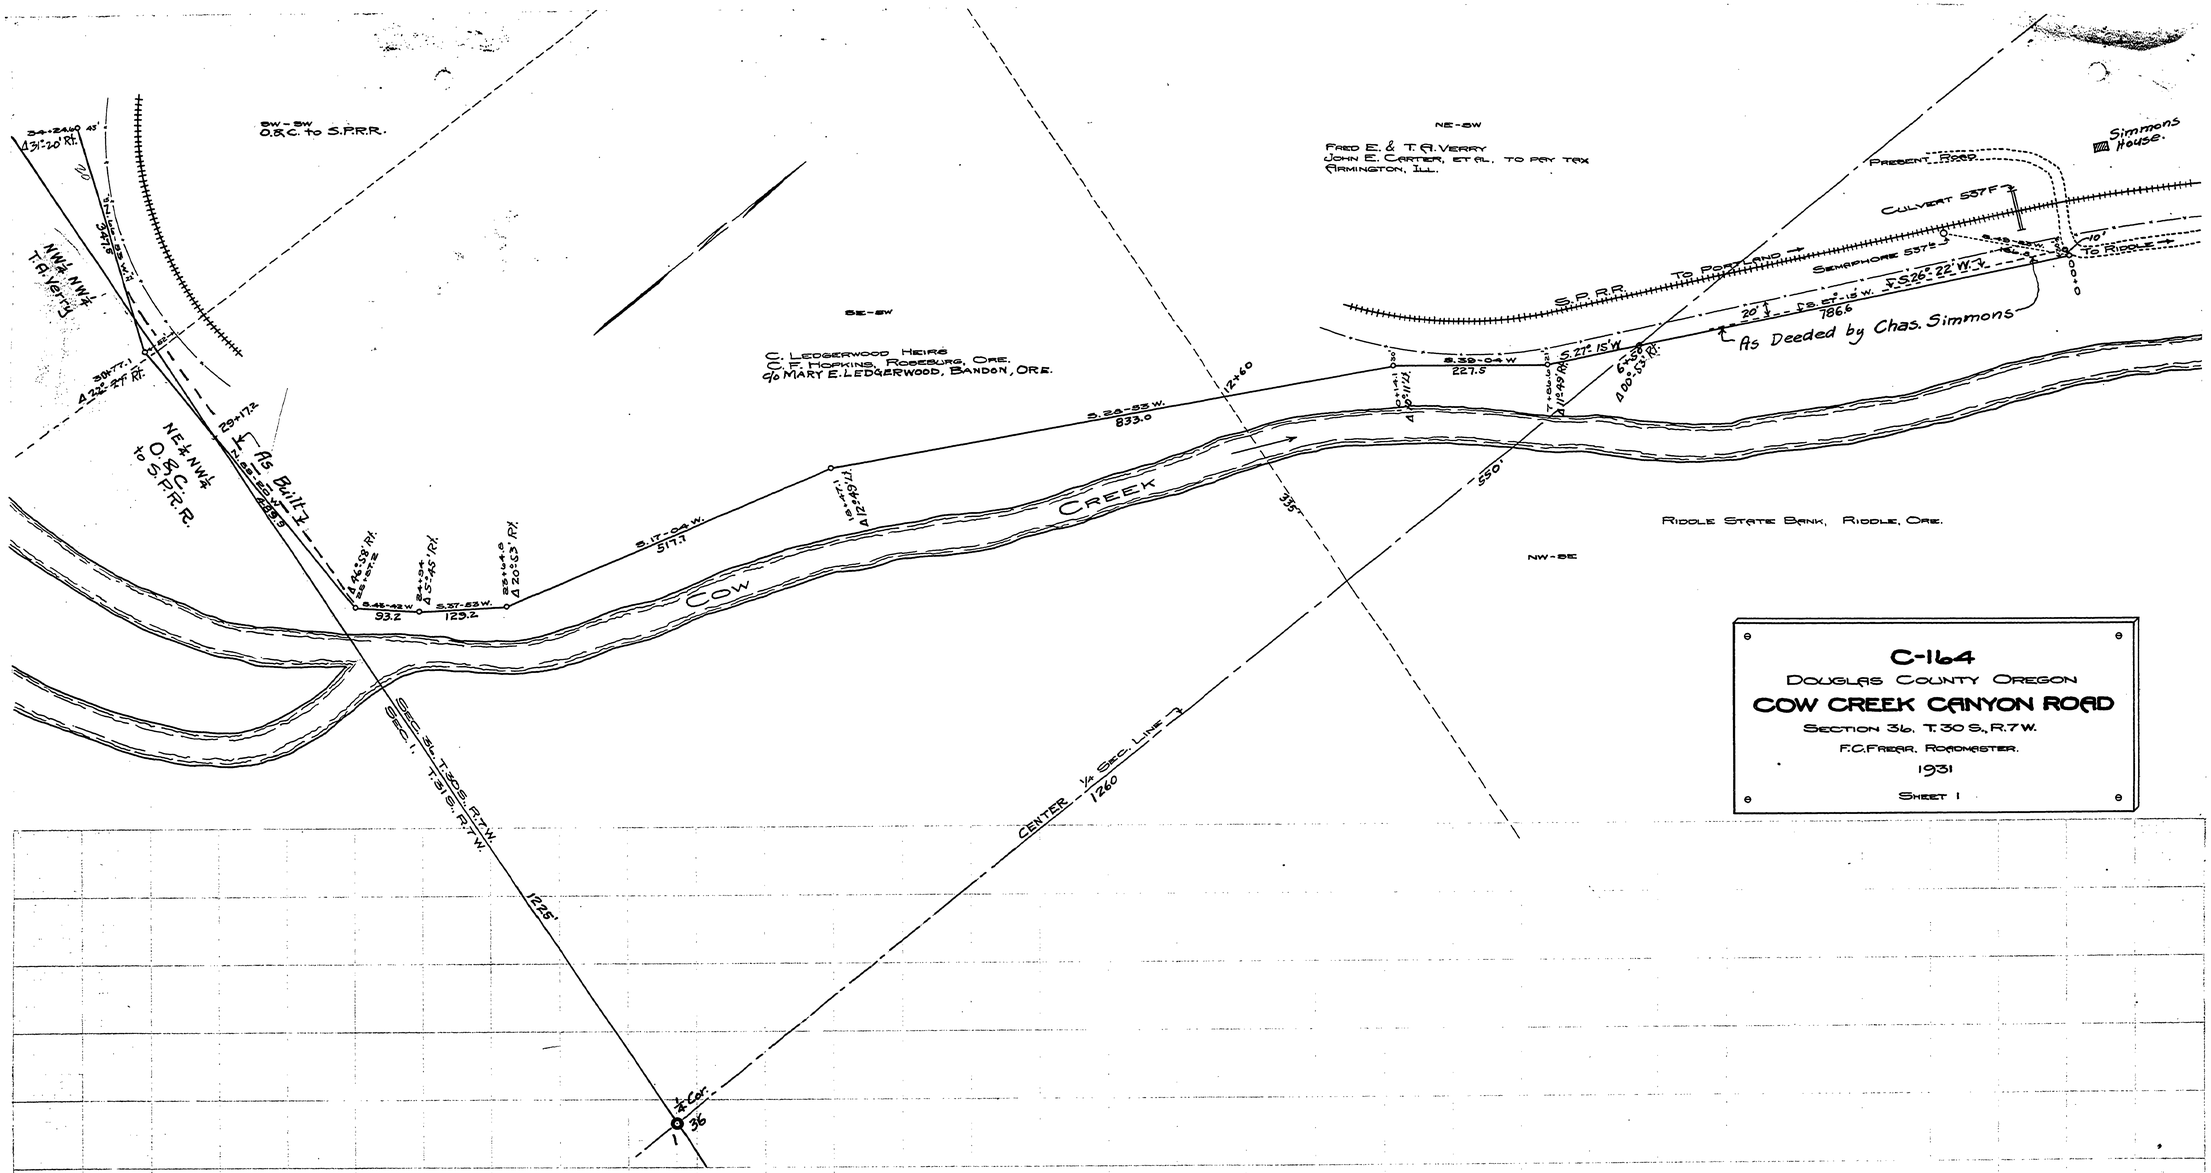
C-164
DOUGLAS COUNTY OREGON
COW CREEK CANYON ROAD
SECTION 36, T. 30 S., R. 7 W.
F.C. FRIEAR, ROADMASTER.
1931
SHEET 1
SW-SW
O.&C. to S.P.R.R.
NE-SW
FRED E. & T. A. VERRY
JOHN E. CARTER, ET AL. TO PAY TAX
ARMINGTON, ILL.
SE-SW
C. LEDGERWOOD HEIRS
C.F. HOPKINS, ROSEBURG, ORE.
c/o MARY E. LEDGERWOOD, BANDON, ORE.
NW-SE
RIDDLE STATE BANK, RIDDLE, ORE.
NW¼ NW¼
T.A. Verry
NE¼ NW¼
O&C
to S.P.R.R.
As Built
As Deeded by Chas. Simmons
Simmons House.
PRESENT ROAD
CULVERT 55'F
SEMAPHORE 55'F
S.P.R.R.
TO PORTLAND
TO RIDDLE
COW CREEK
CENTER ¼ SEC. LINE
SEC. 36, T.30S., R.7W.
SEC. 1, T.31S., R.7W.
¼ Cor.
36
1
S.27° 15' W.
S.26° 22' W.
S.48°-42' W.
S.37°-53' W.
S.17°-04' W.
S.24°-53' W.
S.39°-04' W.
S.57°-18' W.
93.2
129.2
511.7
833.0
227.5
786.6
1260
1225'
550'
335'
20'
12+60
29+172
34+24.0
30+77.1
25+64.9
23+64.0
24+58'
25+67.2
25+45'
25+63'
Δ 31°-20' Rt.
Δ 22°-27' Rt.
Δ 12°-49' Rt.
Δ 00°-53' Rt.
Δ 20°-63' Rt.
Δ 5°-45' Rt.
Δ 14°-58' Rt.
Δ 12°-49' Rt.
