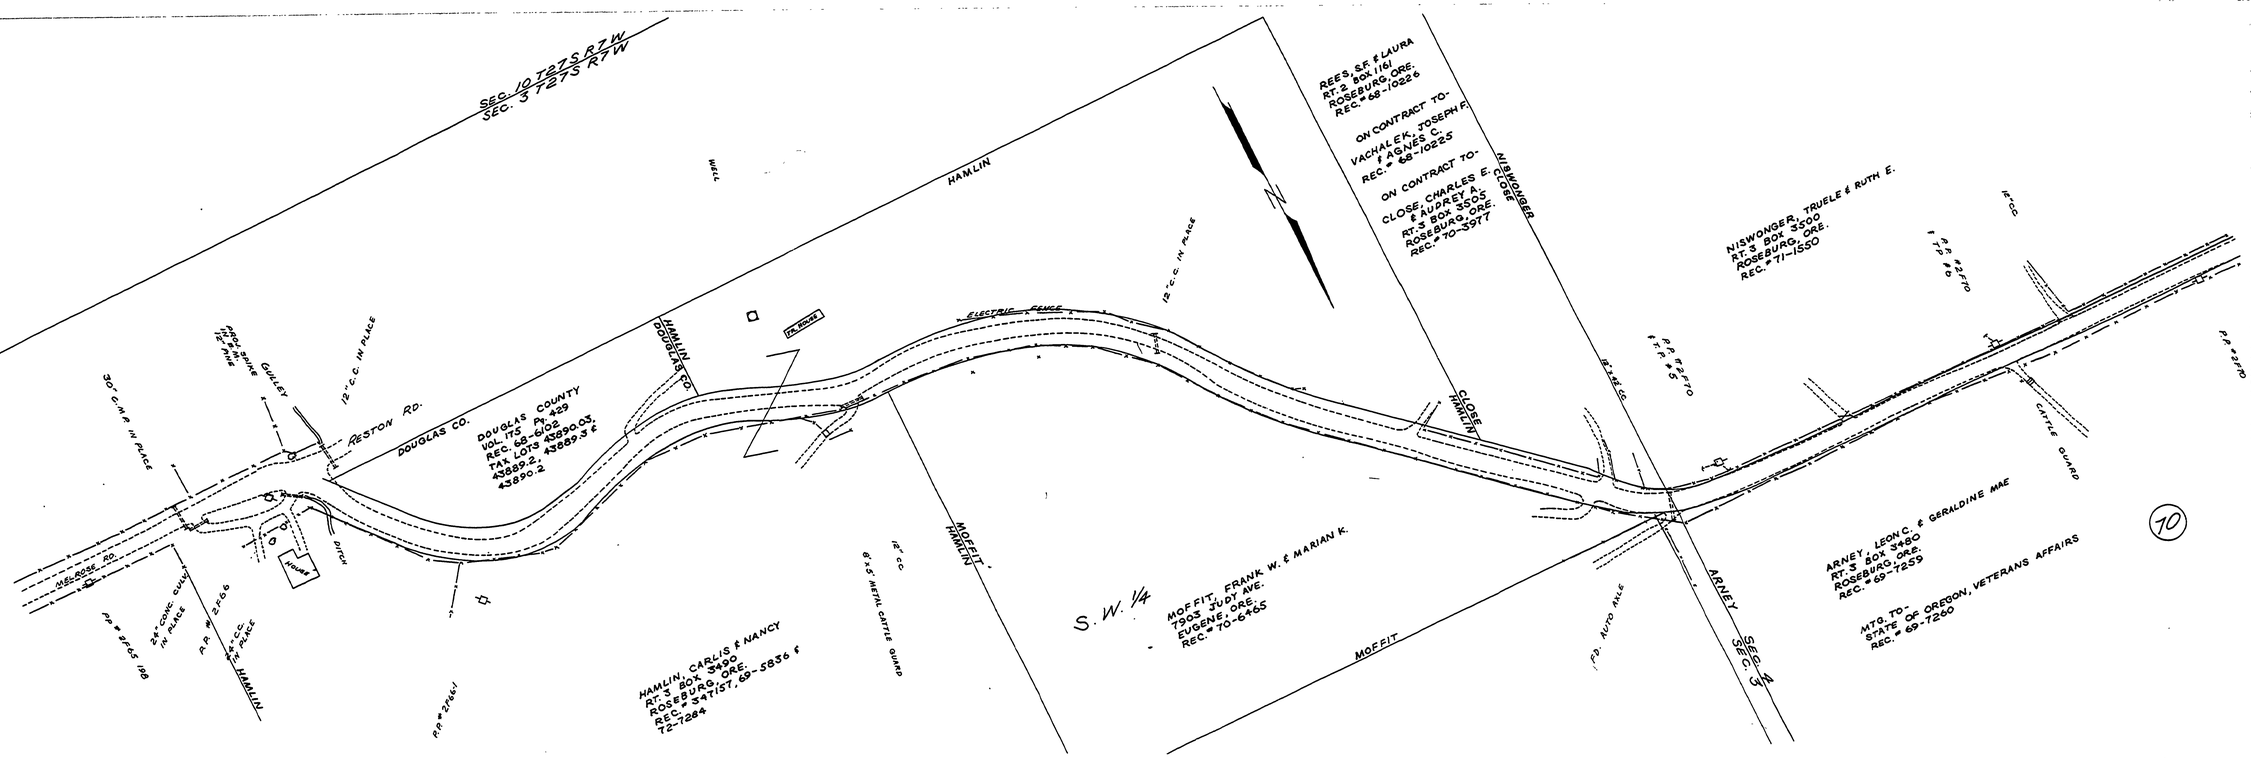

FILED
RECEIVED
JUL 03 1975
COUNTY SURVEYOR
DOUGLAS COUNTY, ORE.

NOT REVISED
AS CONSTRUCTED

DOUGLAS COUNTY ROAD DEPT.
CALLAHAN RD. 174
1972 SHT. 2
GEORGE E. GRUBB COUNTY ENGR.

RD174002

1972
C. Rd #174 sht. 2 of 4 (26)