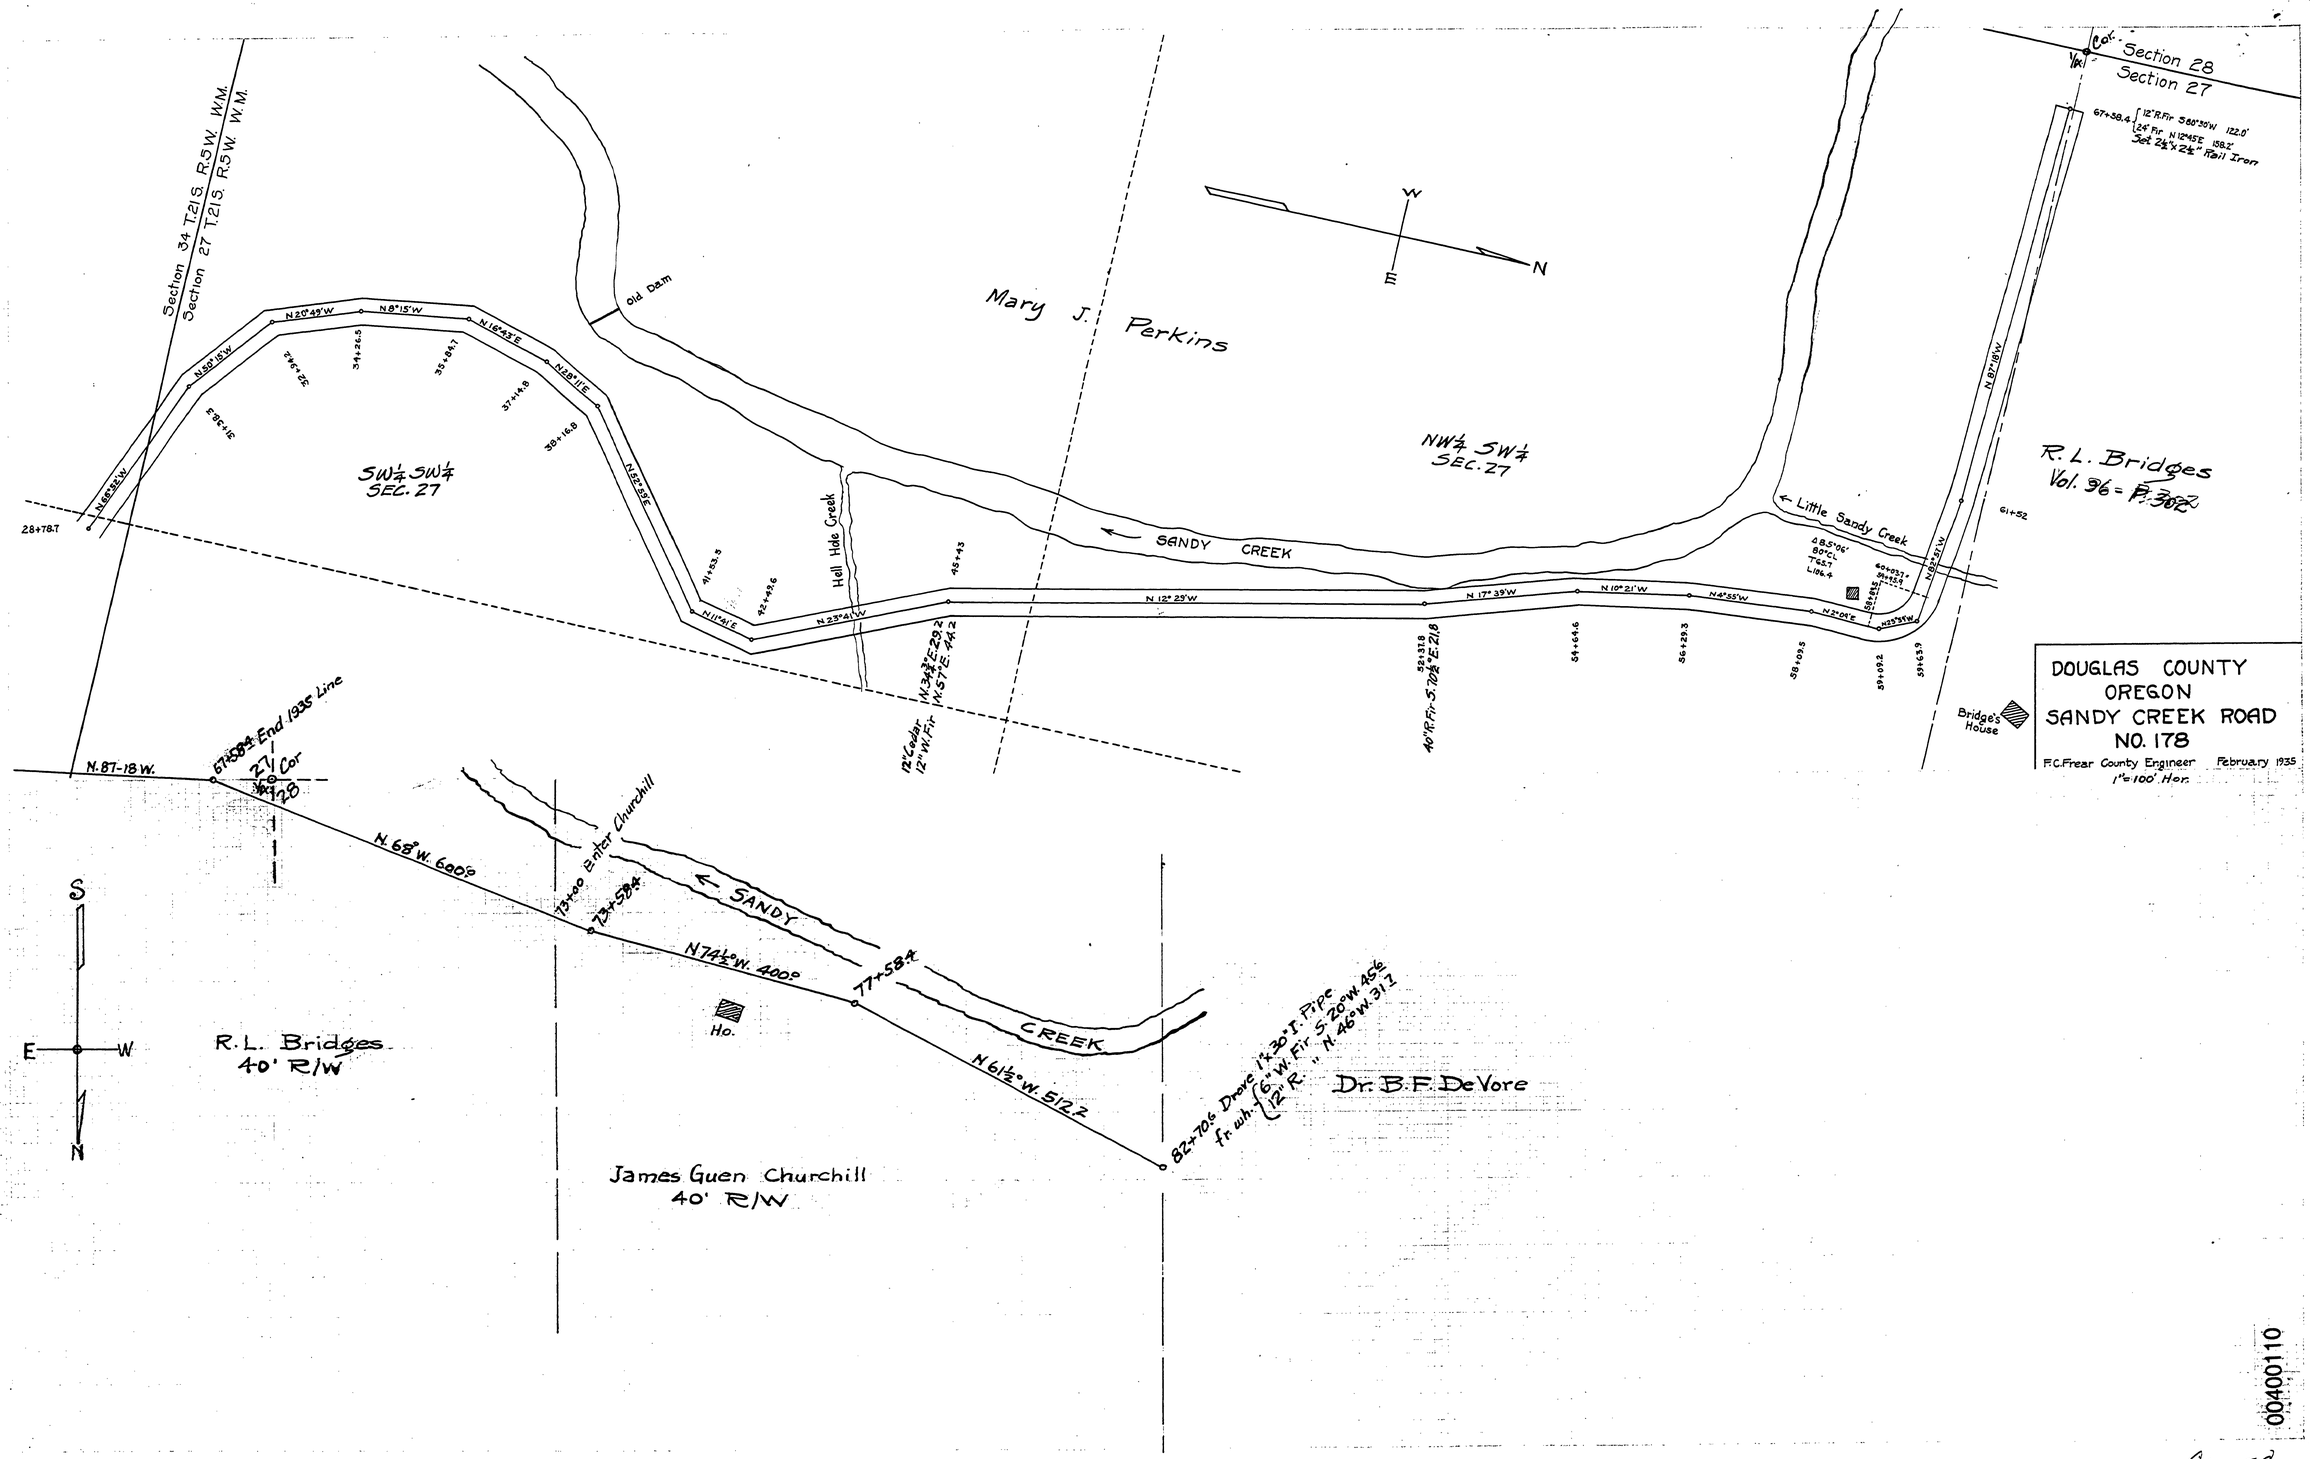

00400110

Co. 178

T 21-5 S. 27, 28 & 34 FEB 1935 SHT 2 OF 2