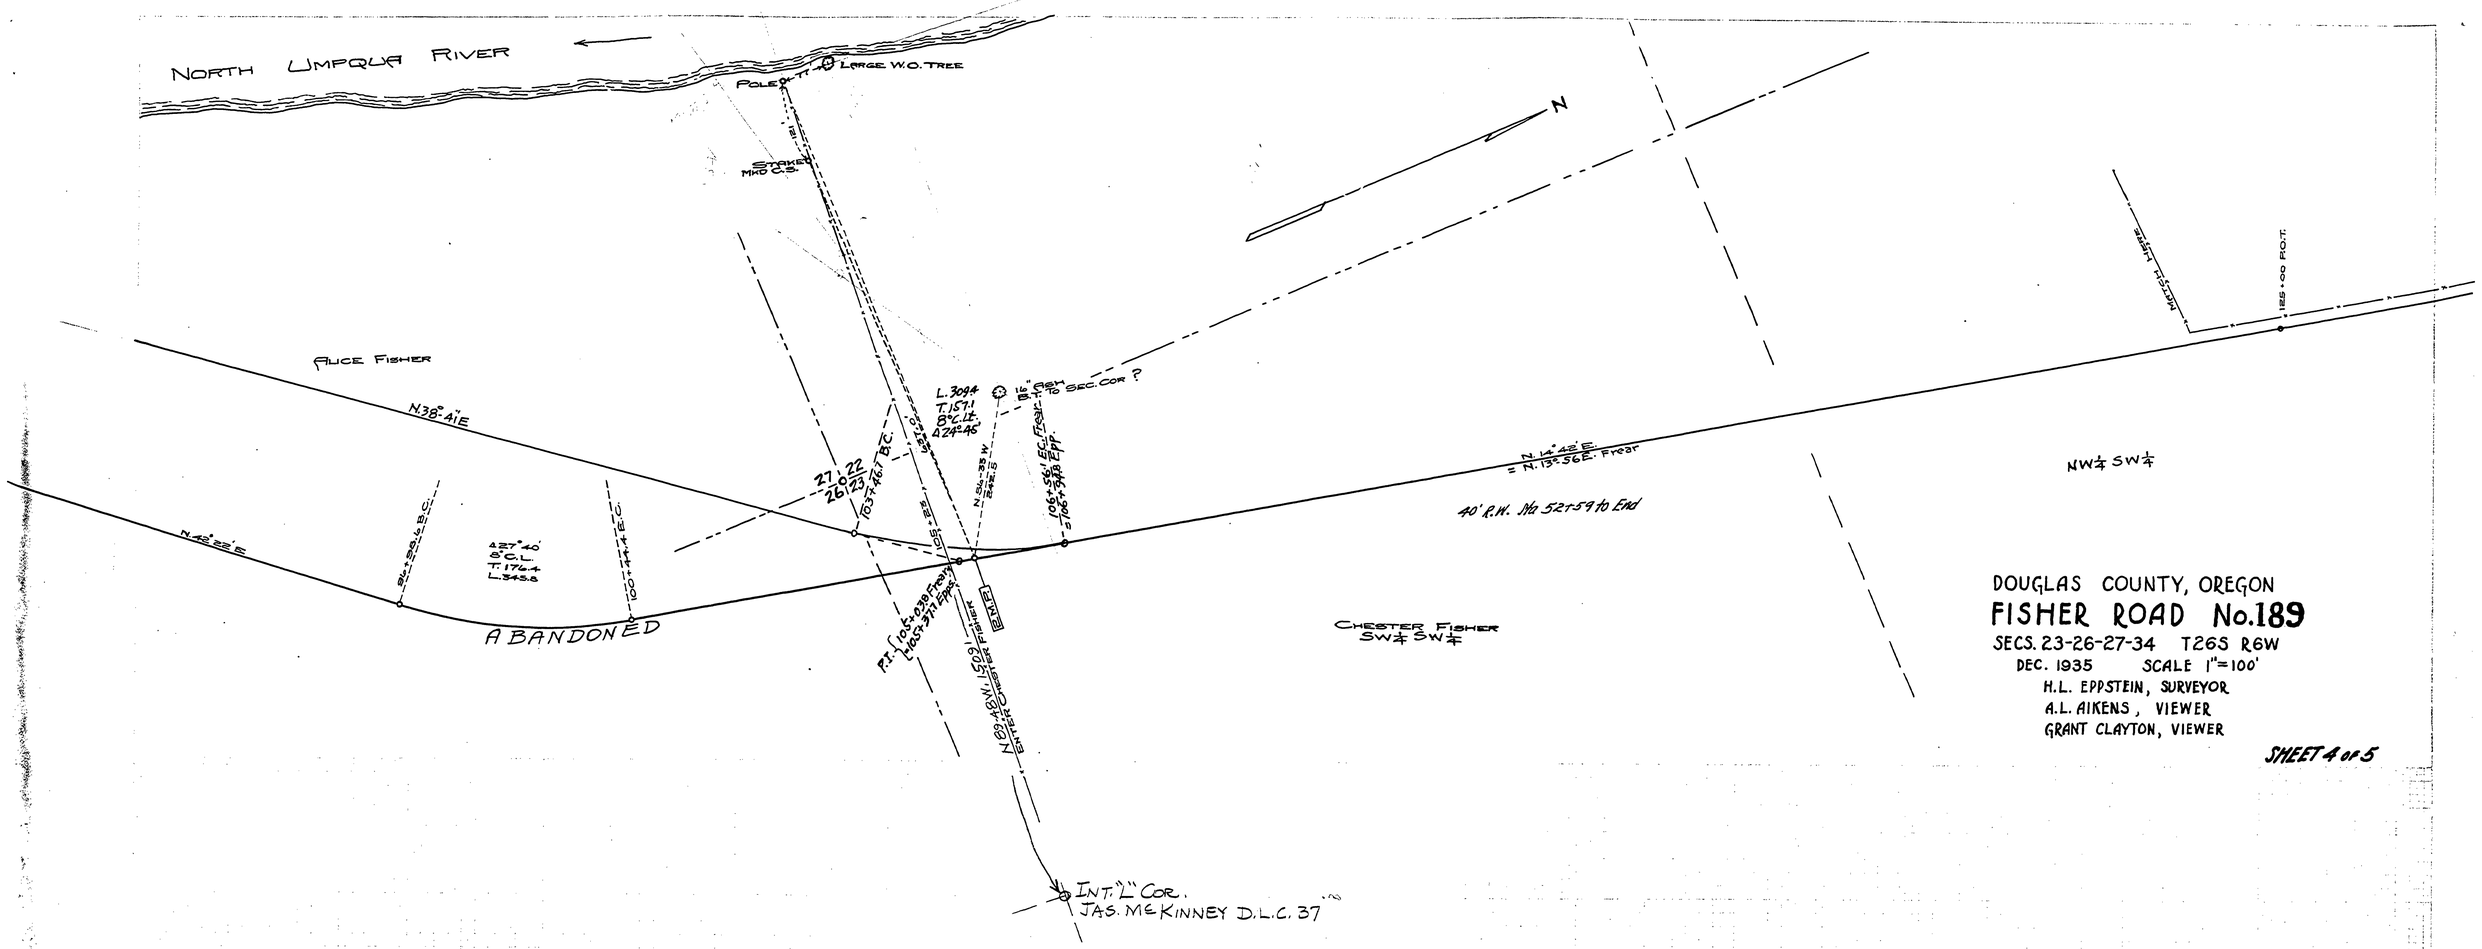

DOUGLAS COUNTY, OREGON

FISHER ROAD No.189

SECS. 23-26-27-34 T26S R6W

DEC. 1935 SCALE 1"=100'

H.L. EPPSTEIN, SURVEYOR

A.L. AIKENS, VIEWER

GRANT CLAYTON, VIEWER

SHEET 4 of 5

01900235

RD # 189

~M.P. 1.90 - 2.35

T26-6 S. 23,26,27 & 34 SHT 4 of 5

7