


DOUGLAS COUNTY, OREGON.  
 GOODRICH-ELKHEAD ROAD No. 190.  
 SEC. 11, T24S, R5W.  
 1938-9 F.C. FREAR, CO. ROADMASTER  
 SHEET 4

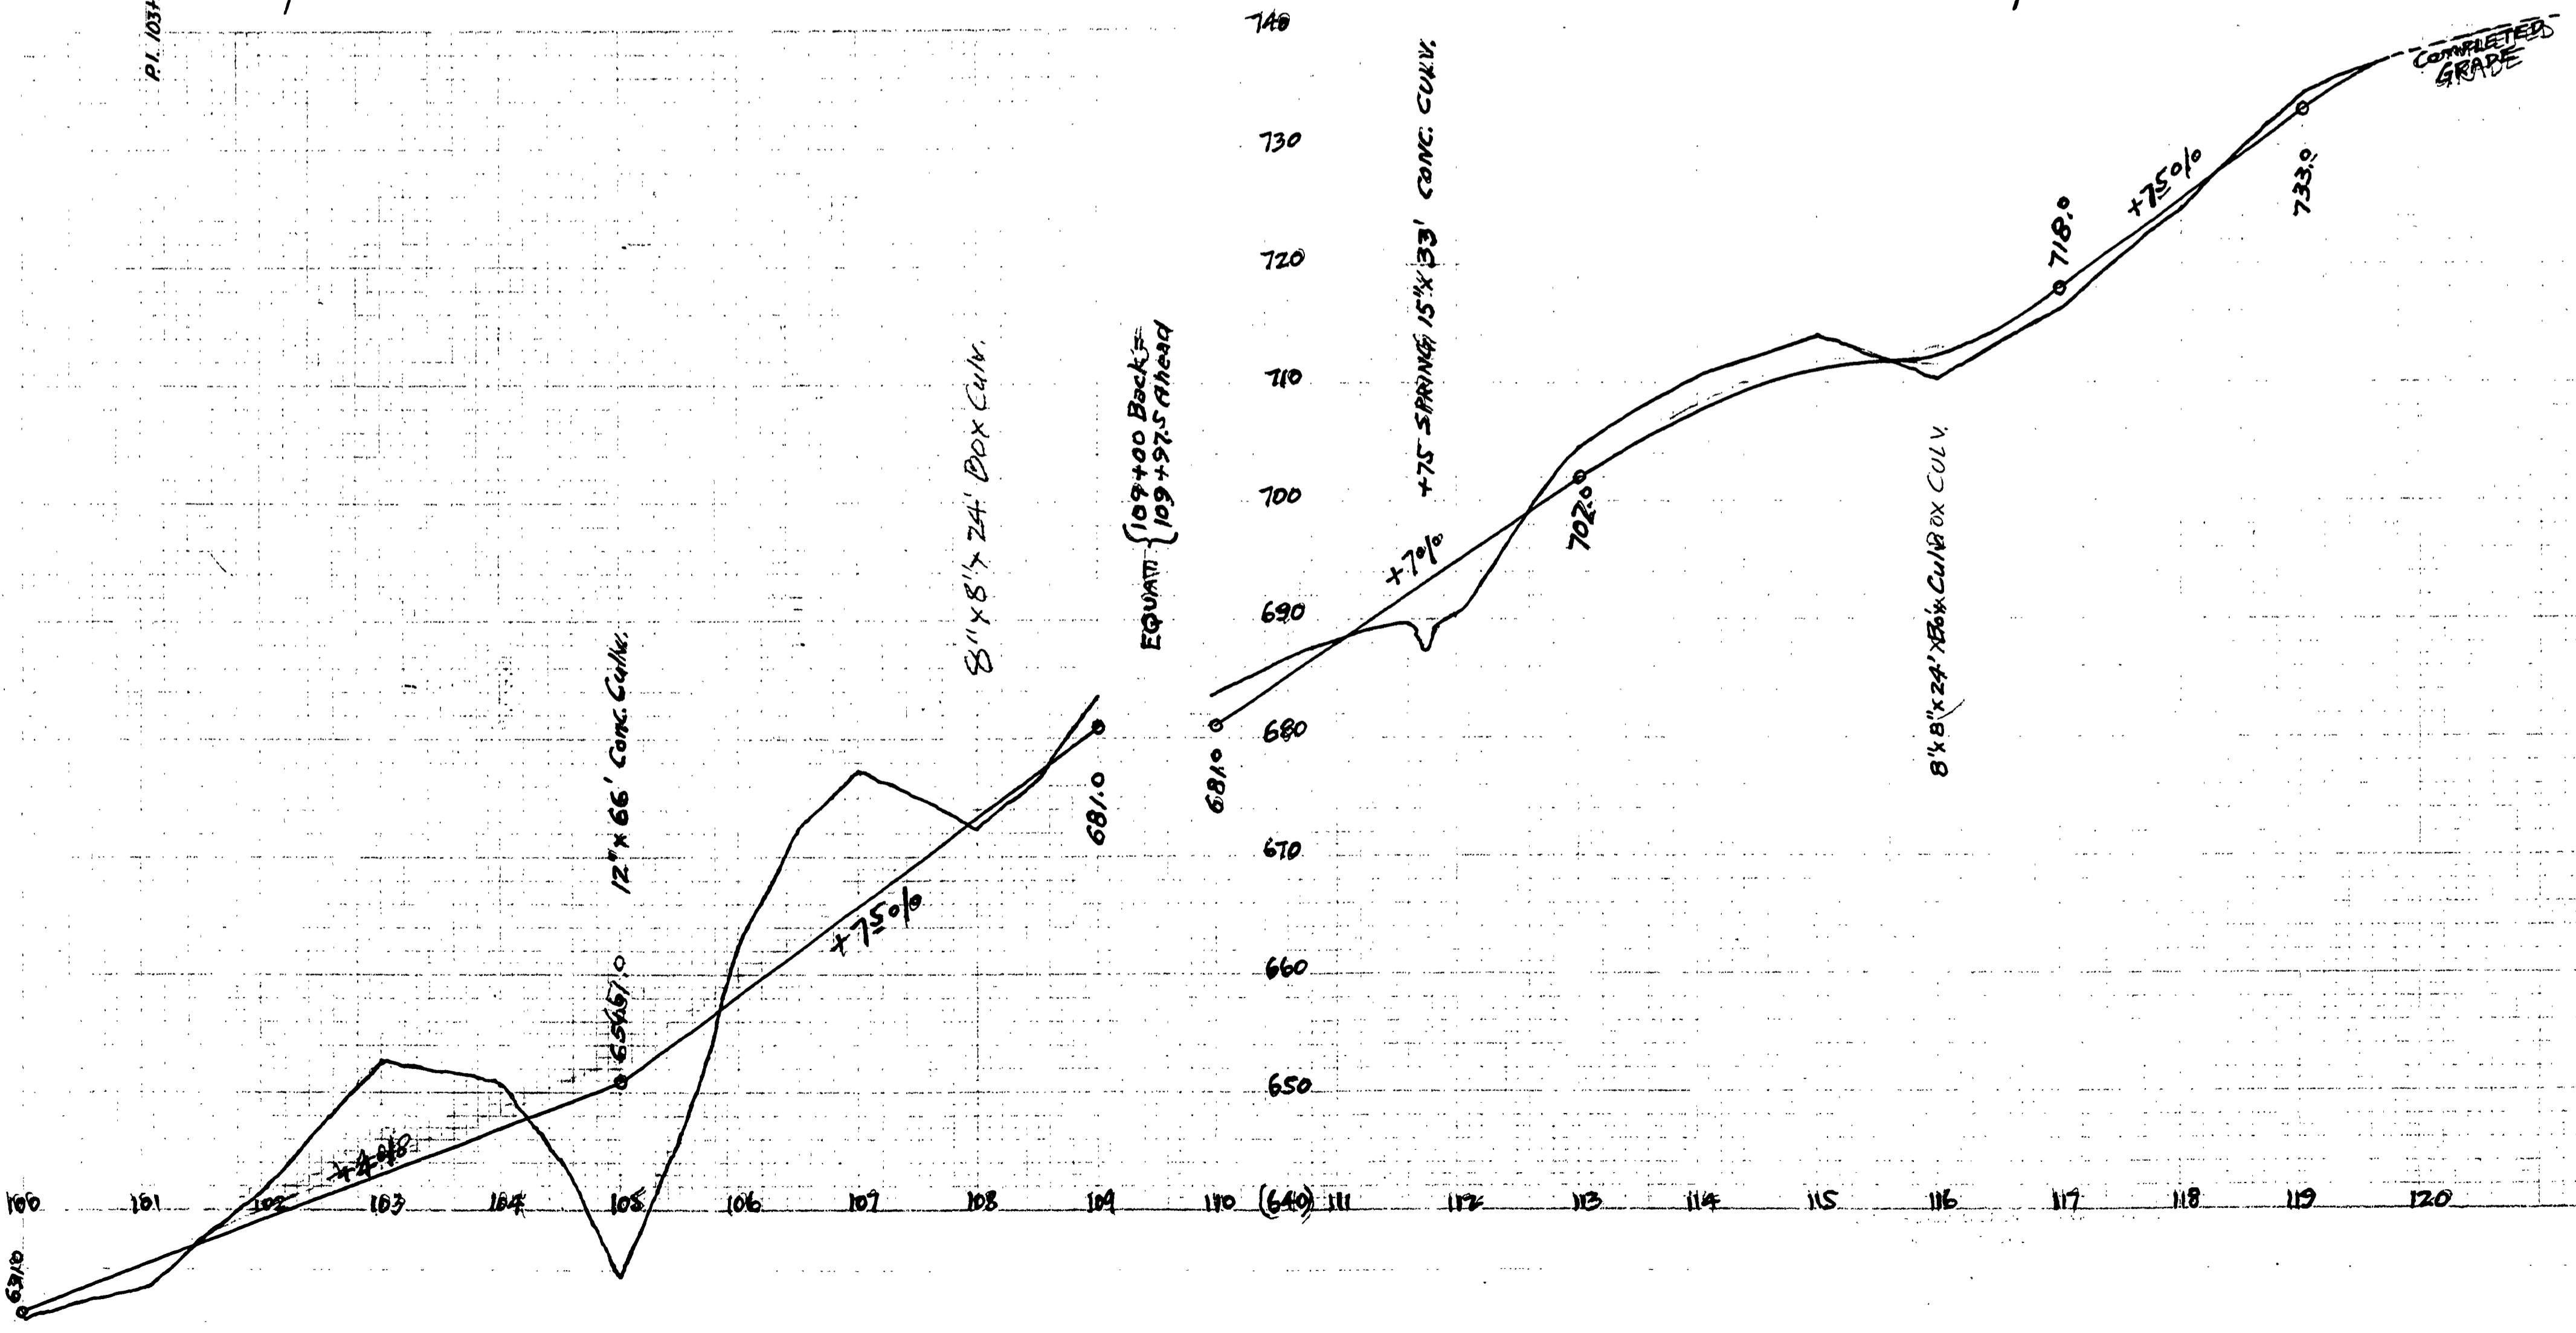

01800230