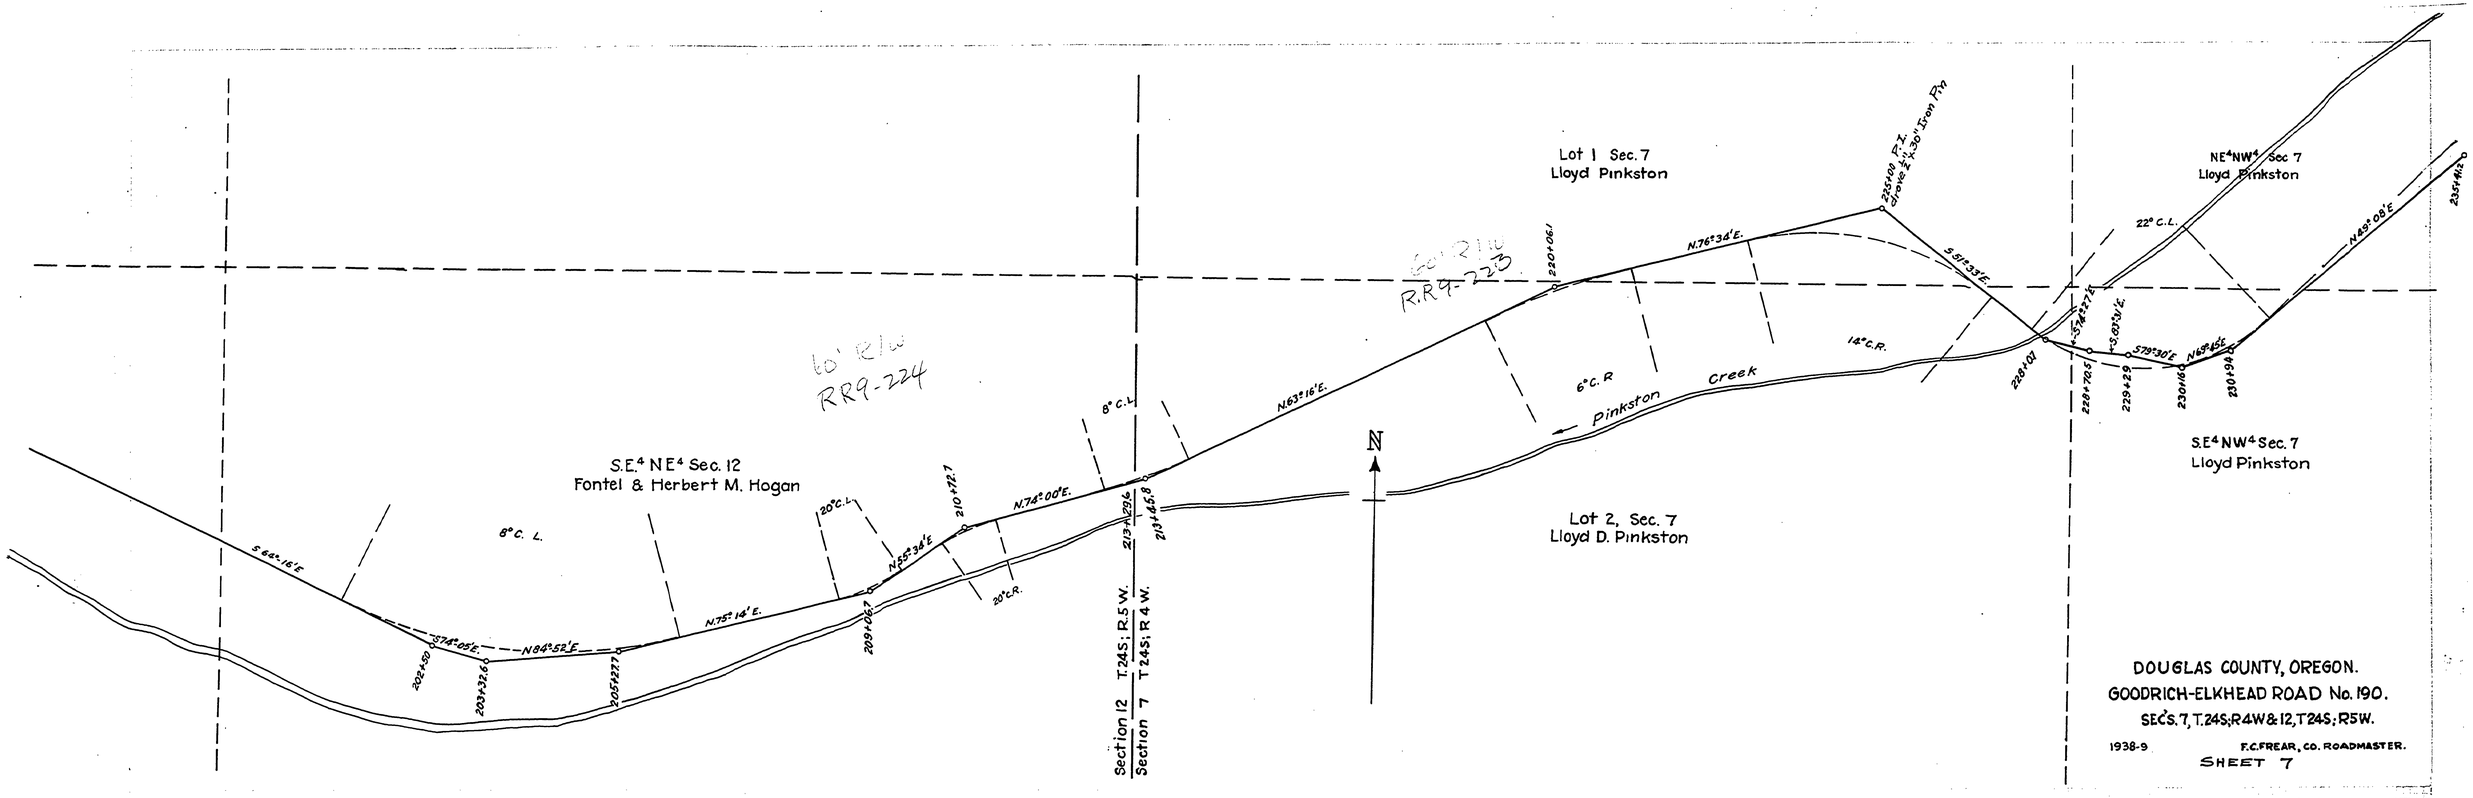


DOUGLAS COUNTY, OREGON.
GOODRICH-ELKHEAD ROAD No. 190.
SEC'S. 7, T.24S; R4W & 12, T24S; R5W.

1938-9 F.C.FREAR, CO. ROADMASTER.

SHEET 7

03600410

~ M.P. 3.60 - 4.10

T 24-4 S. 12
T 24-4 S.7 1938-9 SHT 7 OF 8

CO. RD #190